


# MAP OF JUDITH NO. 1, 2 & 4

CONTROLLED BY THE Colonial Iron Co.

Scale 1 inch = 100 feet

1918

Prepared by D. D. ...

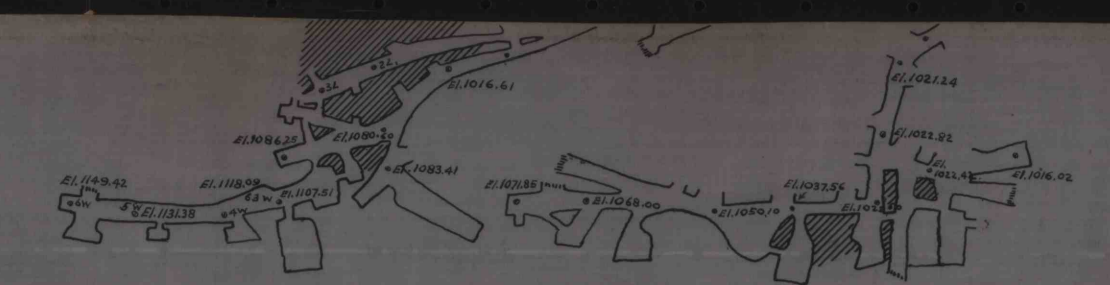

COLONIAL IRON COMPANY.

CARBON COAL AND COKE COMPANY.

