



NOTE:  
PROPERTY LINE IN PENCIL  
OK  
WERTZ & MILLER MINE  
OK  
OTHER MINES CANNOT BE SURVEYED  
AFR 1941

CAMBRIA IRON CO.  
Christian Horner Warrant Dated Nov. 4, 1846  
David Farmer Warrant Dated Jan. 22, 1847  
GEORGE SHAFER  
A. N. WAKEFIELD  
HIRAM GWANK  
JOHN V. SHAFER

DALE BORO

WALNUT GROVE

Bedford Pike

TOWNSHIP ROAD


S. 60° 20' E. 286.4 ft.

N. 60° 07' E. 1088 ft.

Main Heading

Public Road

Back Cor.

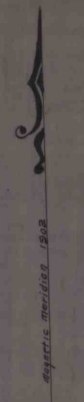

Warrant Line

JACOB JACOBY  
Jacob Jacoby's  
Mines  
Elev. 1367.4

Jacob Rose Mine

Elev. 1326.85  
Barriman's  
Wakefield

Elev. 1326.45  
Wertz & Miller  
Mine

Jacob Rose Mine

Elev. Creek  
1312.62

