


MAP SHOWING
MINING OPERATIONS
OF
EDWARD FUGE
IN PROPERTY OF
J. P. McCONAUGHY, EST.
JOHNSTOWN-PENNA
SCALE 1"=100'

NOTE :- FIRST SURVEYS MADE BY CAMBRIA
STEEL Co. DECEMBER - 1909.

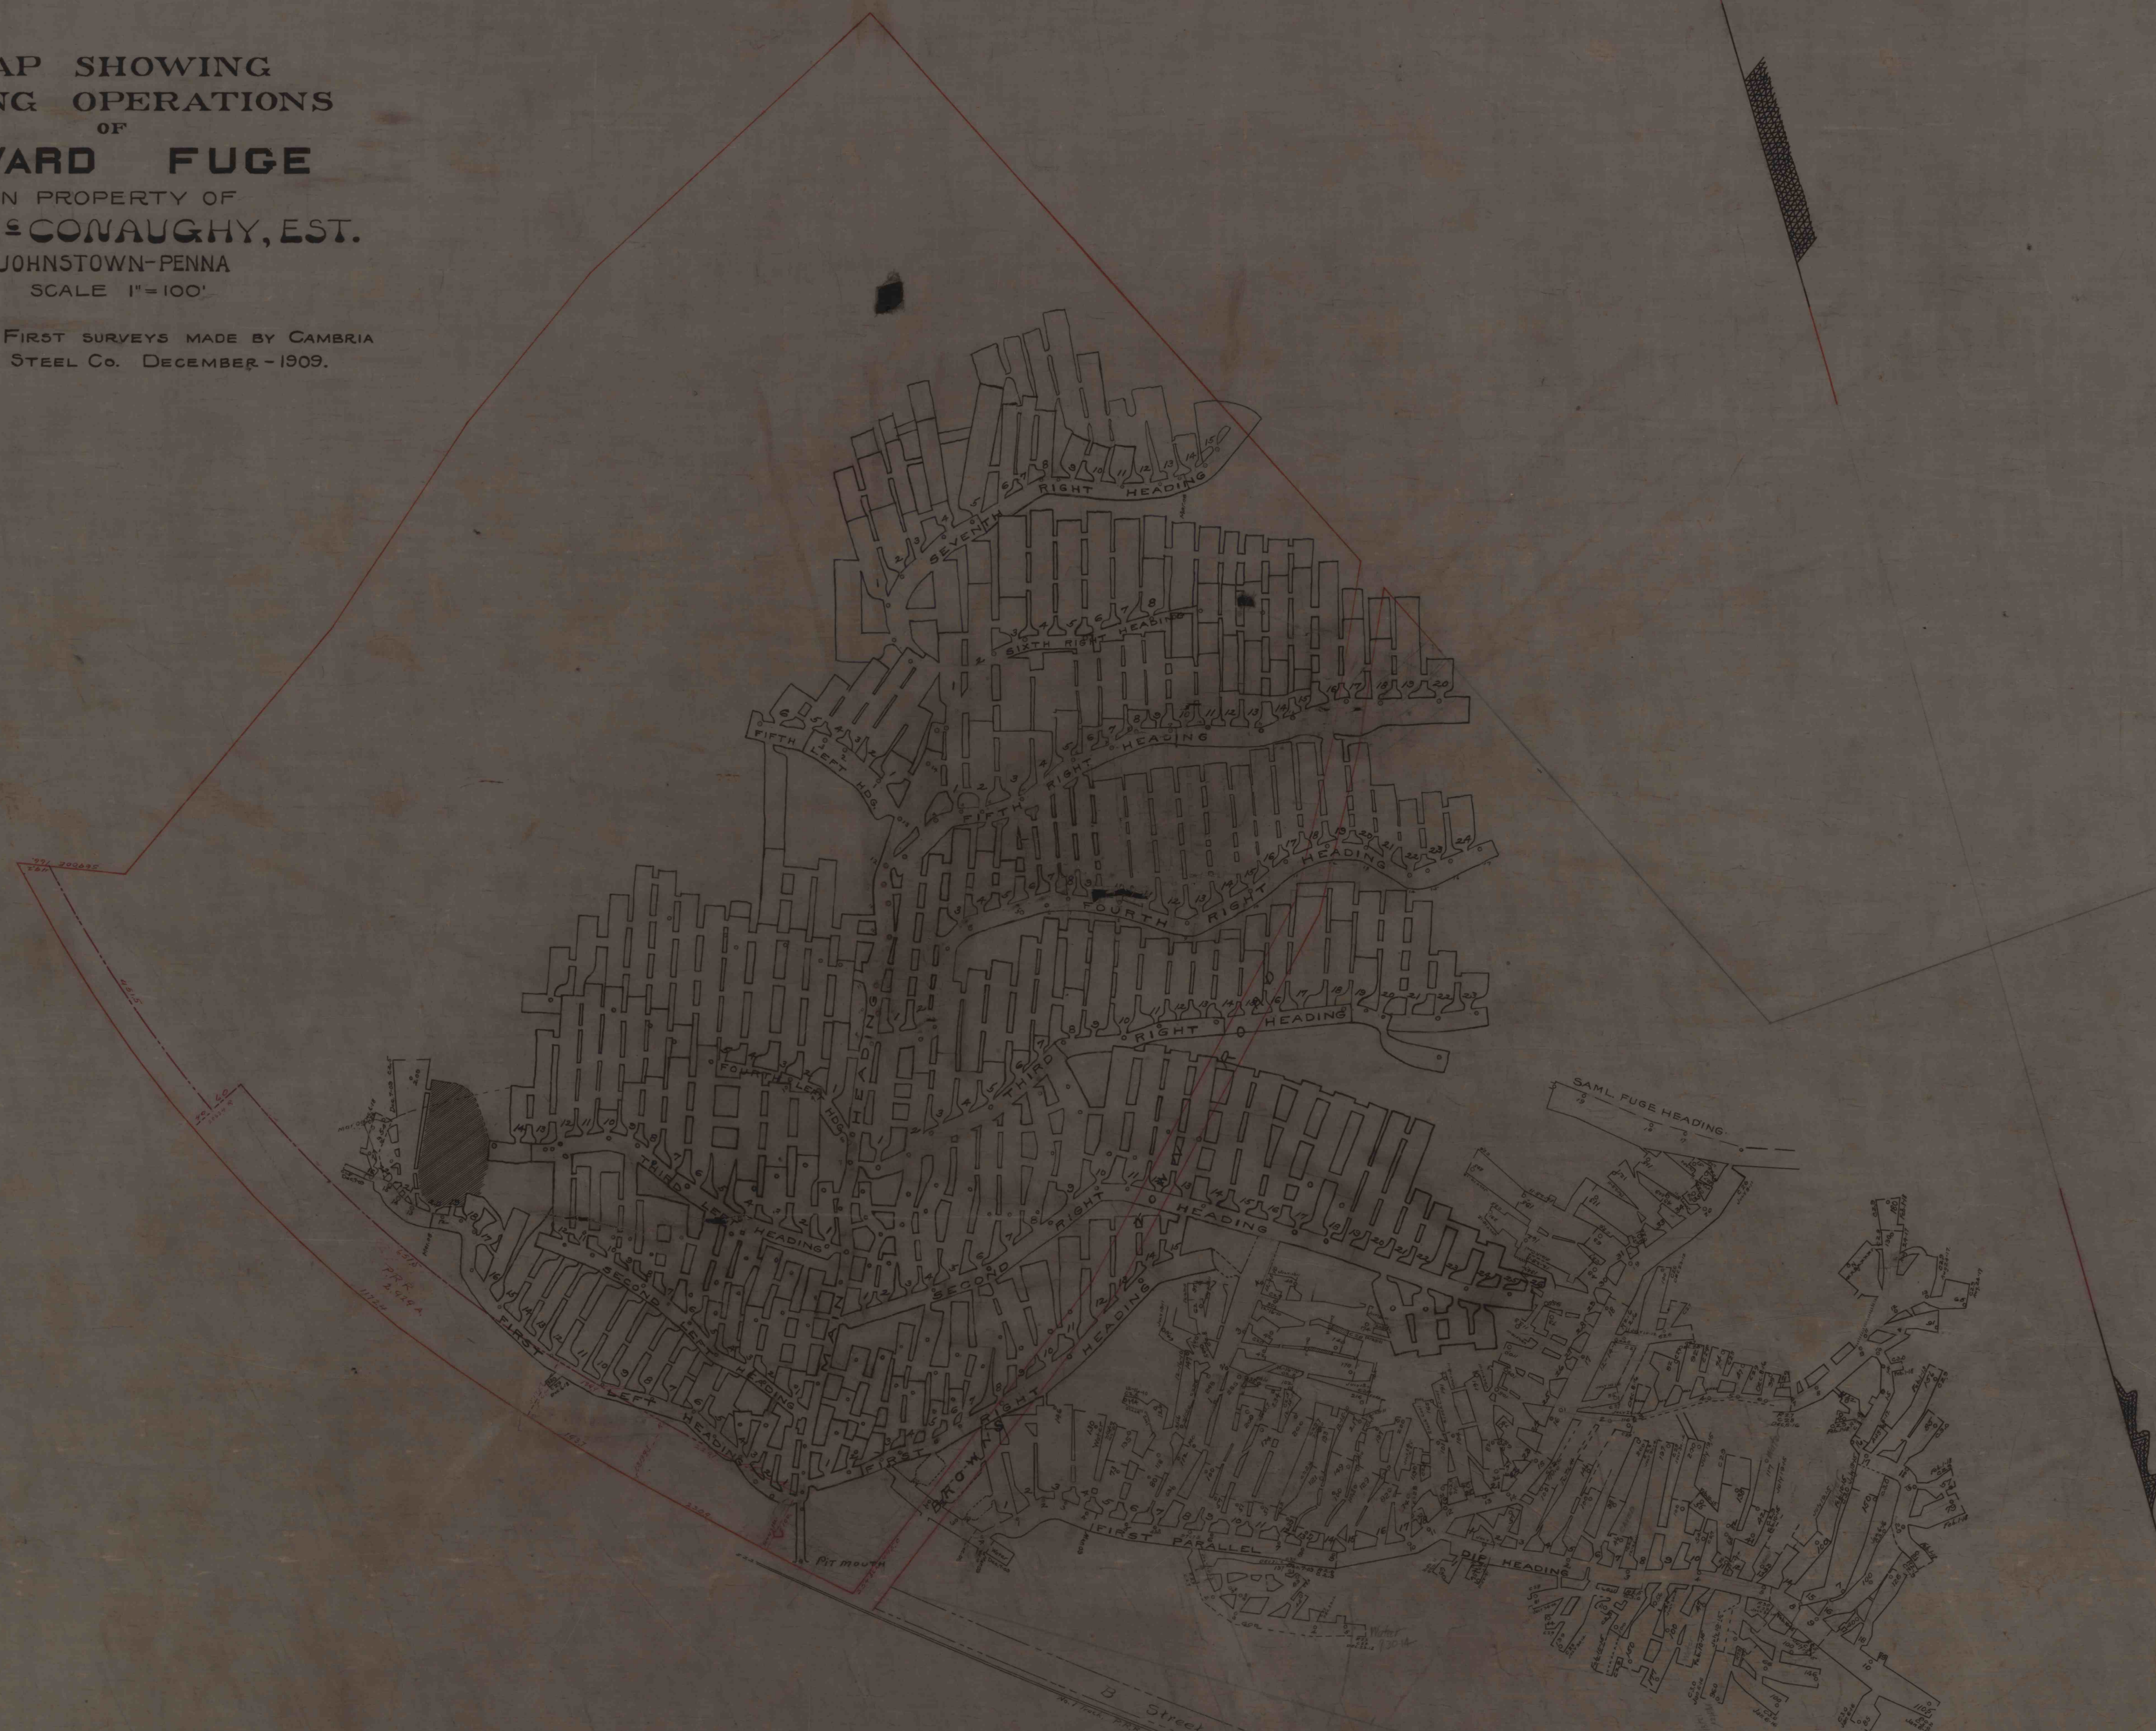

Scale 100 To 1 inch
MGT. CO. PA.

CAMBRIA STEEL CO.
M.E. & S. DEPT.
OTHER COAL MINES
C. & CO.
INDEX NO. SC-1A.

S. G. Fetterman,
CIVIL & MINING ENGINEER.