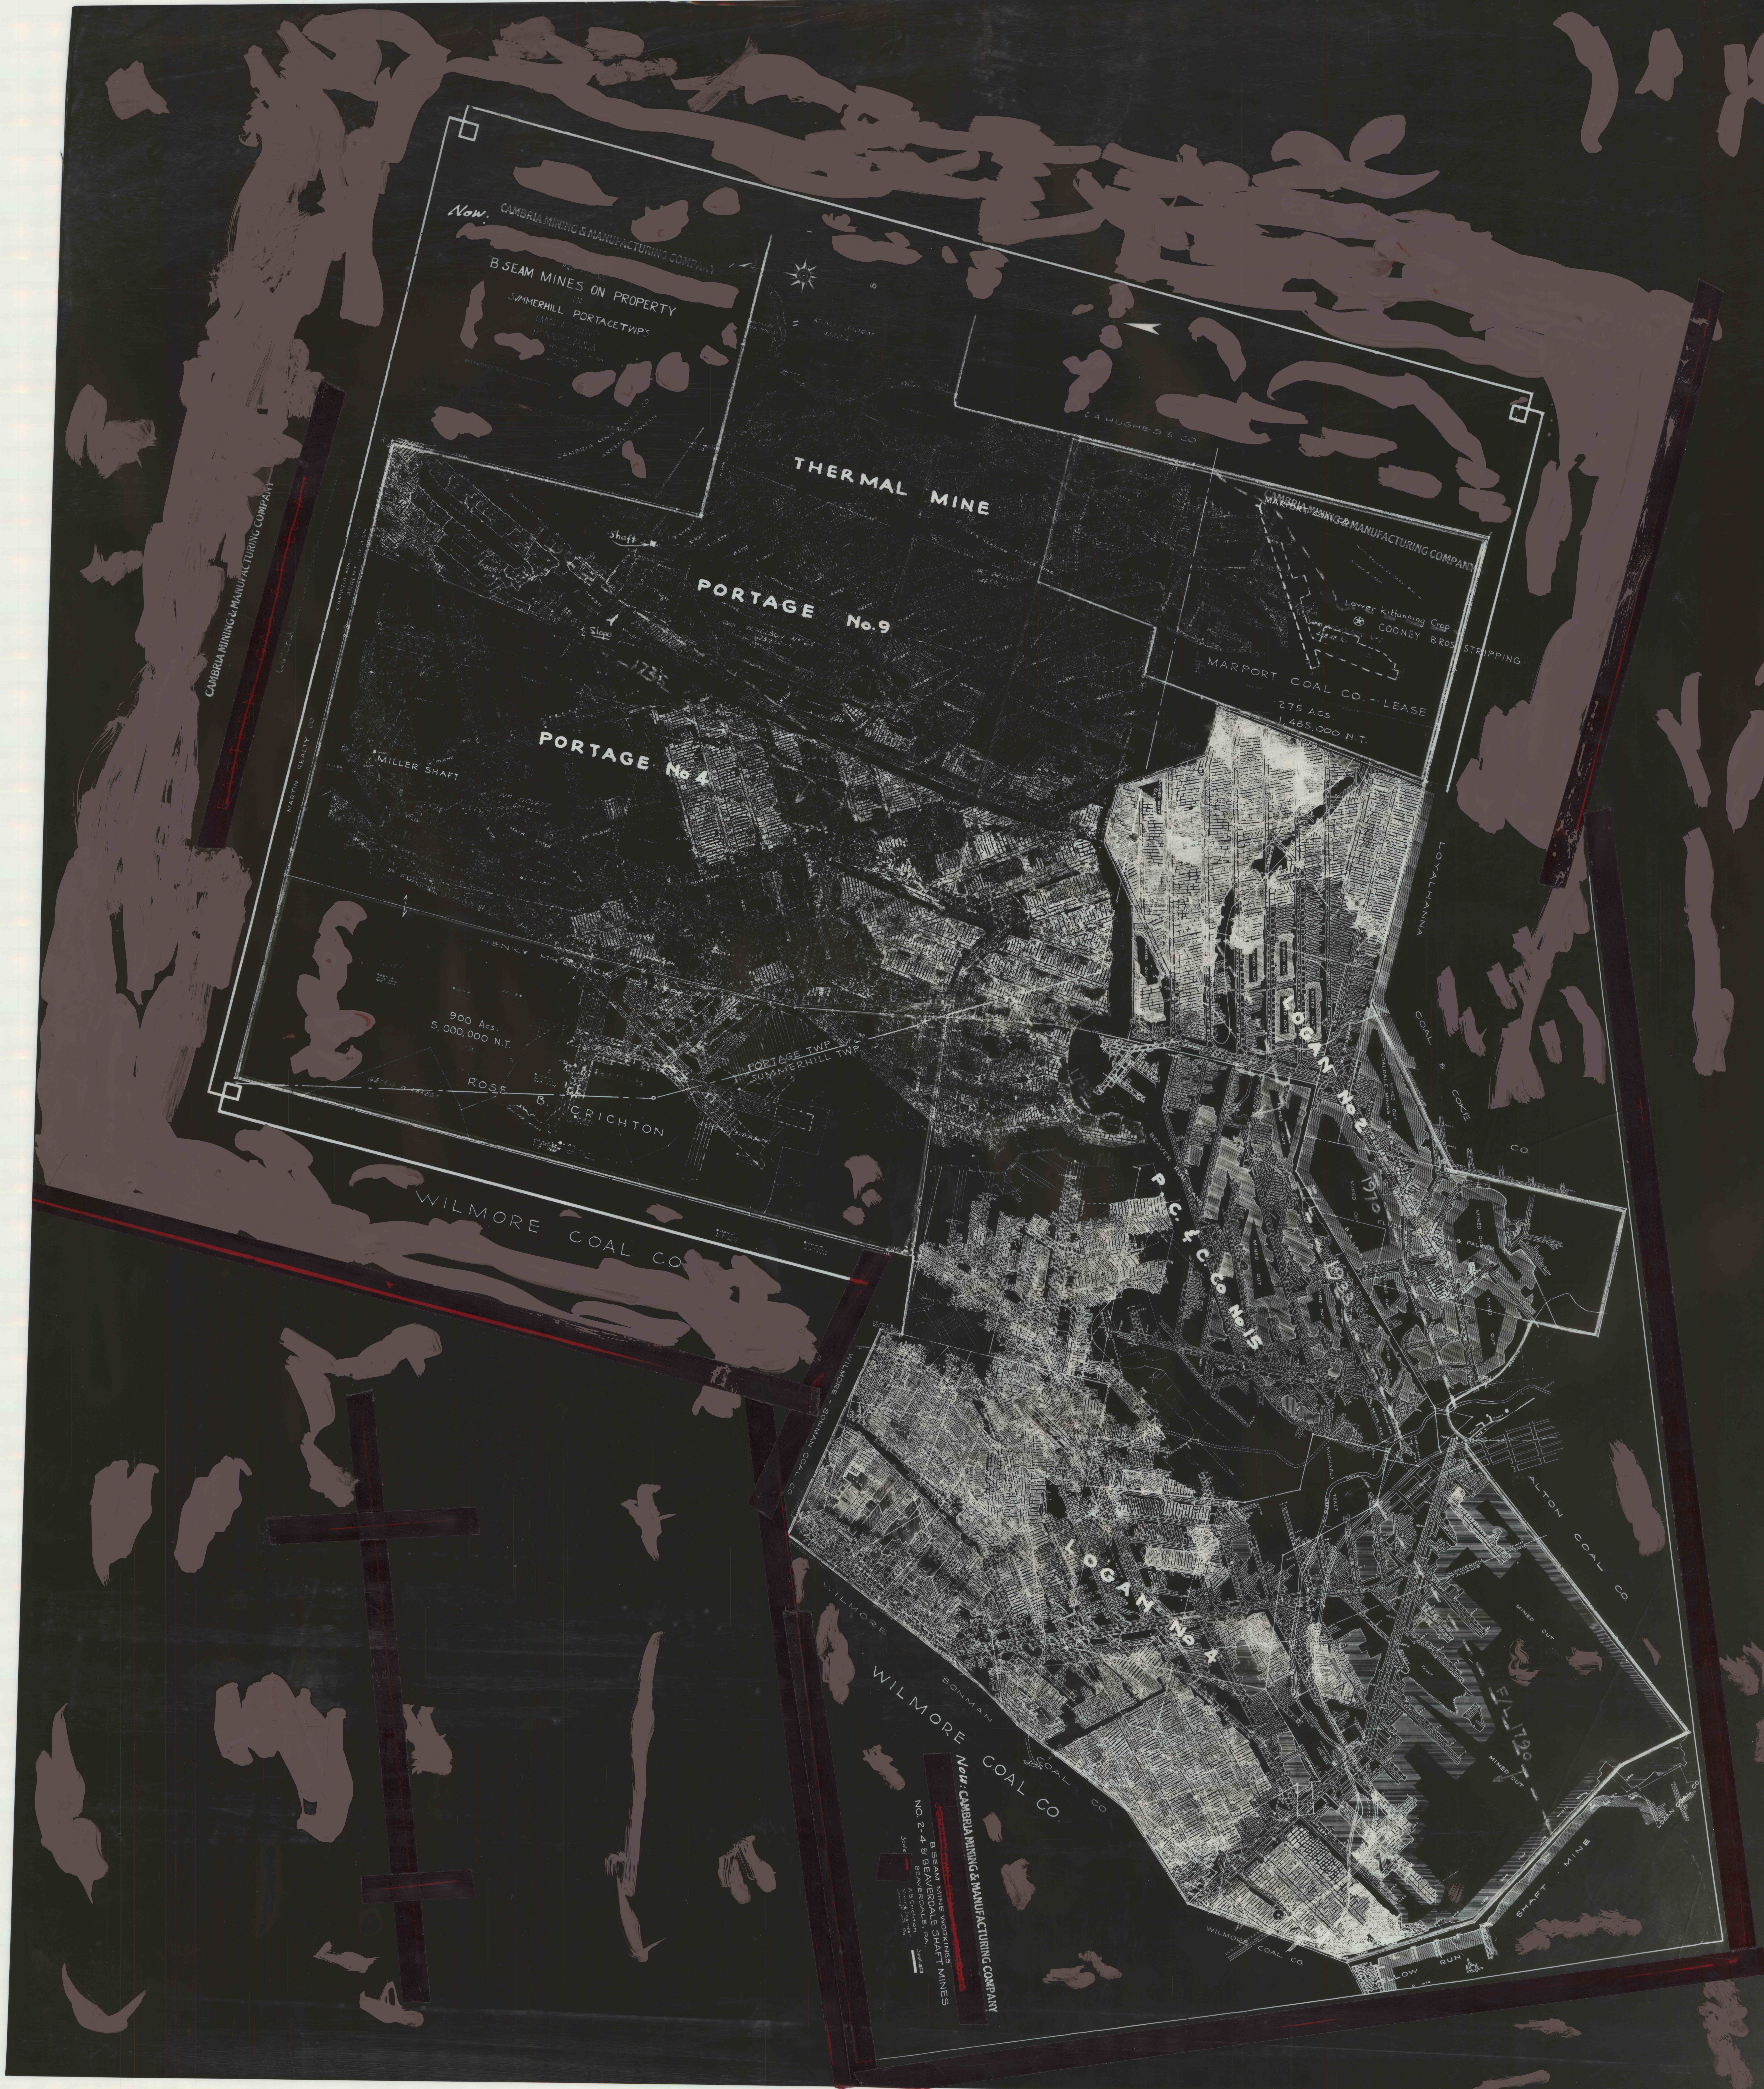
Now. CAMBRIA MINING & MANUFACTURING COMPANY
B SEAM MINES ON PROPERTY
IN
SUMMERHILL PORTAGE TWP'S
THERMAL MINE
C.A. HUGHES & CO
PORTAGE No. 9
PORTAGE No 4
Shaft
Slope
1735
MILLER SHAFT
MARTIN REALTY CO
CAMBRIA MINING & MANUFACTURING COMPANY
HENRY McCORMICK
900 Acs.
5,000,000 N.T.
ROSE
B. CRICHTON
PORTAGE TWP
SUMMERHILL TWP
WILMORE COAL CO
CAMBRIA MINING & MANUFACTURING COMPANY
Lower Kittanning Crop
COONEY BROS STRIPPING
MARPORT COAL CO. - LEASE
275 Acs.
1,485,000 N.T.
LOYALHANNA COAL & COKE CO.
LOGAN No 2
P.C. & C. Co No 15
1910
1933
MINED OUT
COALDALE MINING CO
BEAVER RUN
MICHAELS TRACT
BEAVERDALE
SUMMERHILL
ADAMS
ALTON COAL CO.
LOGAN No 4
F.W. 1720
WILMORE - SONMAN COAL CO
WILMORE SONMAN COAL CO
WILMORE COAL CO.
WILMORE COAL CO
SHAFT MINE
LOGAN COAL CO
BELLOW RUN
Now: CAMBRIA MINING & MANUFACTURING COMPANY
B SEAM MINE WORKINGS
NO. 2-4 & BEAVERDALE SHAFT MINES
BEAVERDALE, PA.
A.B. Crichton
Mining Engineer