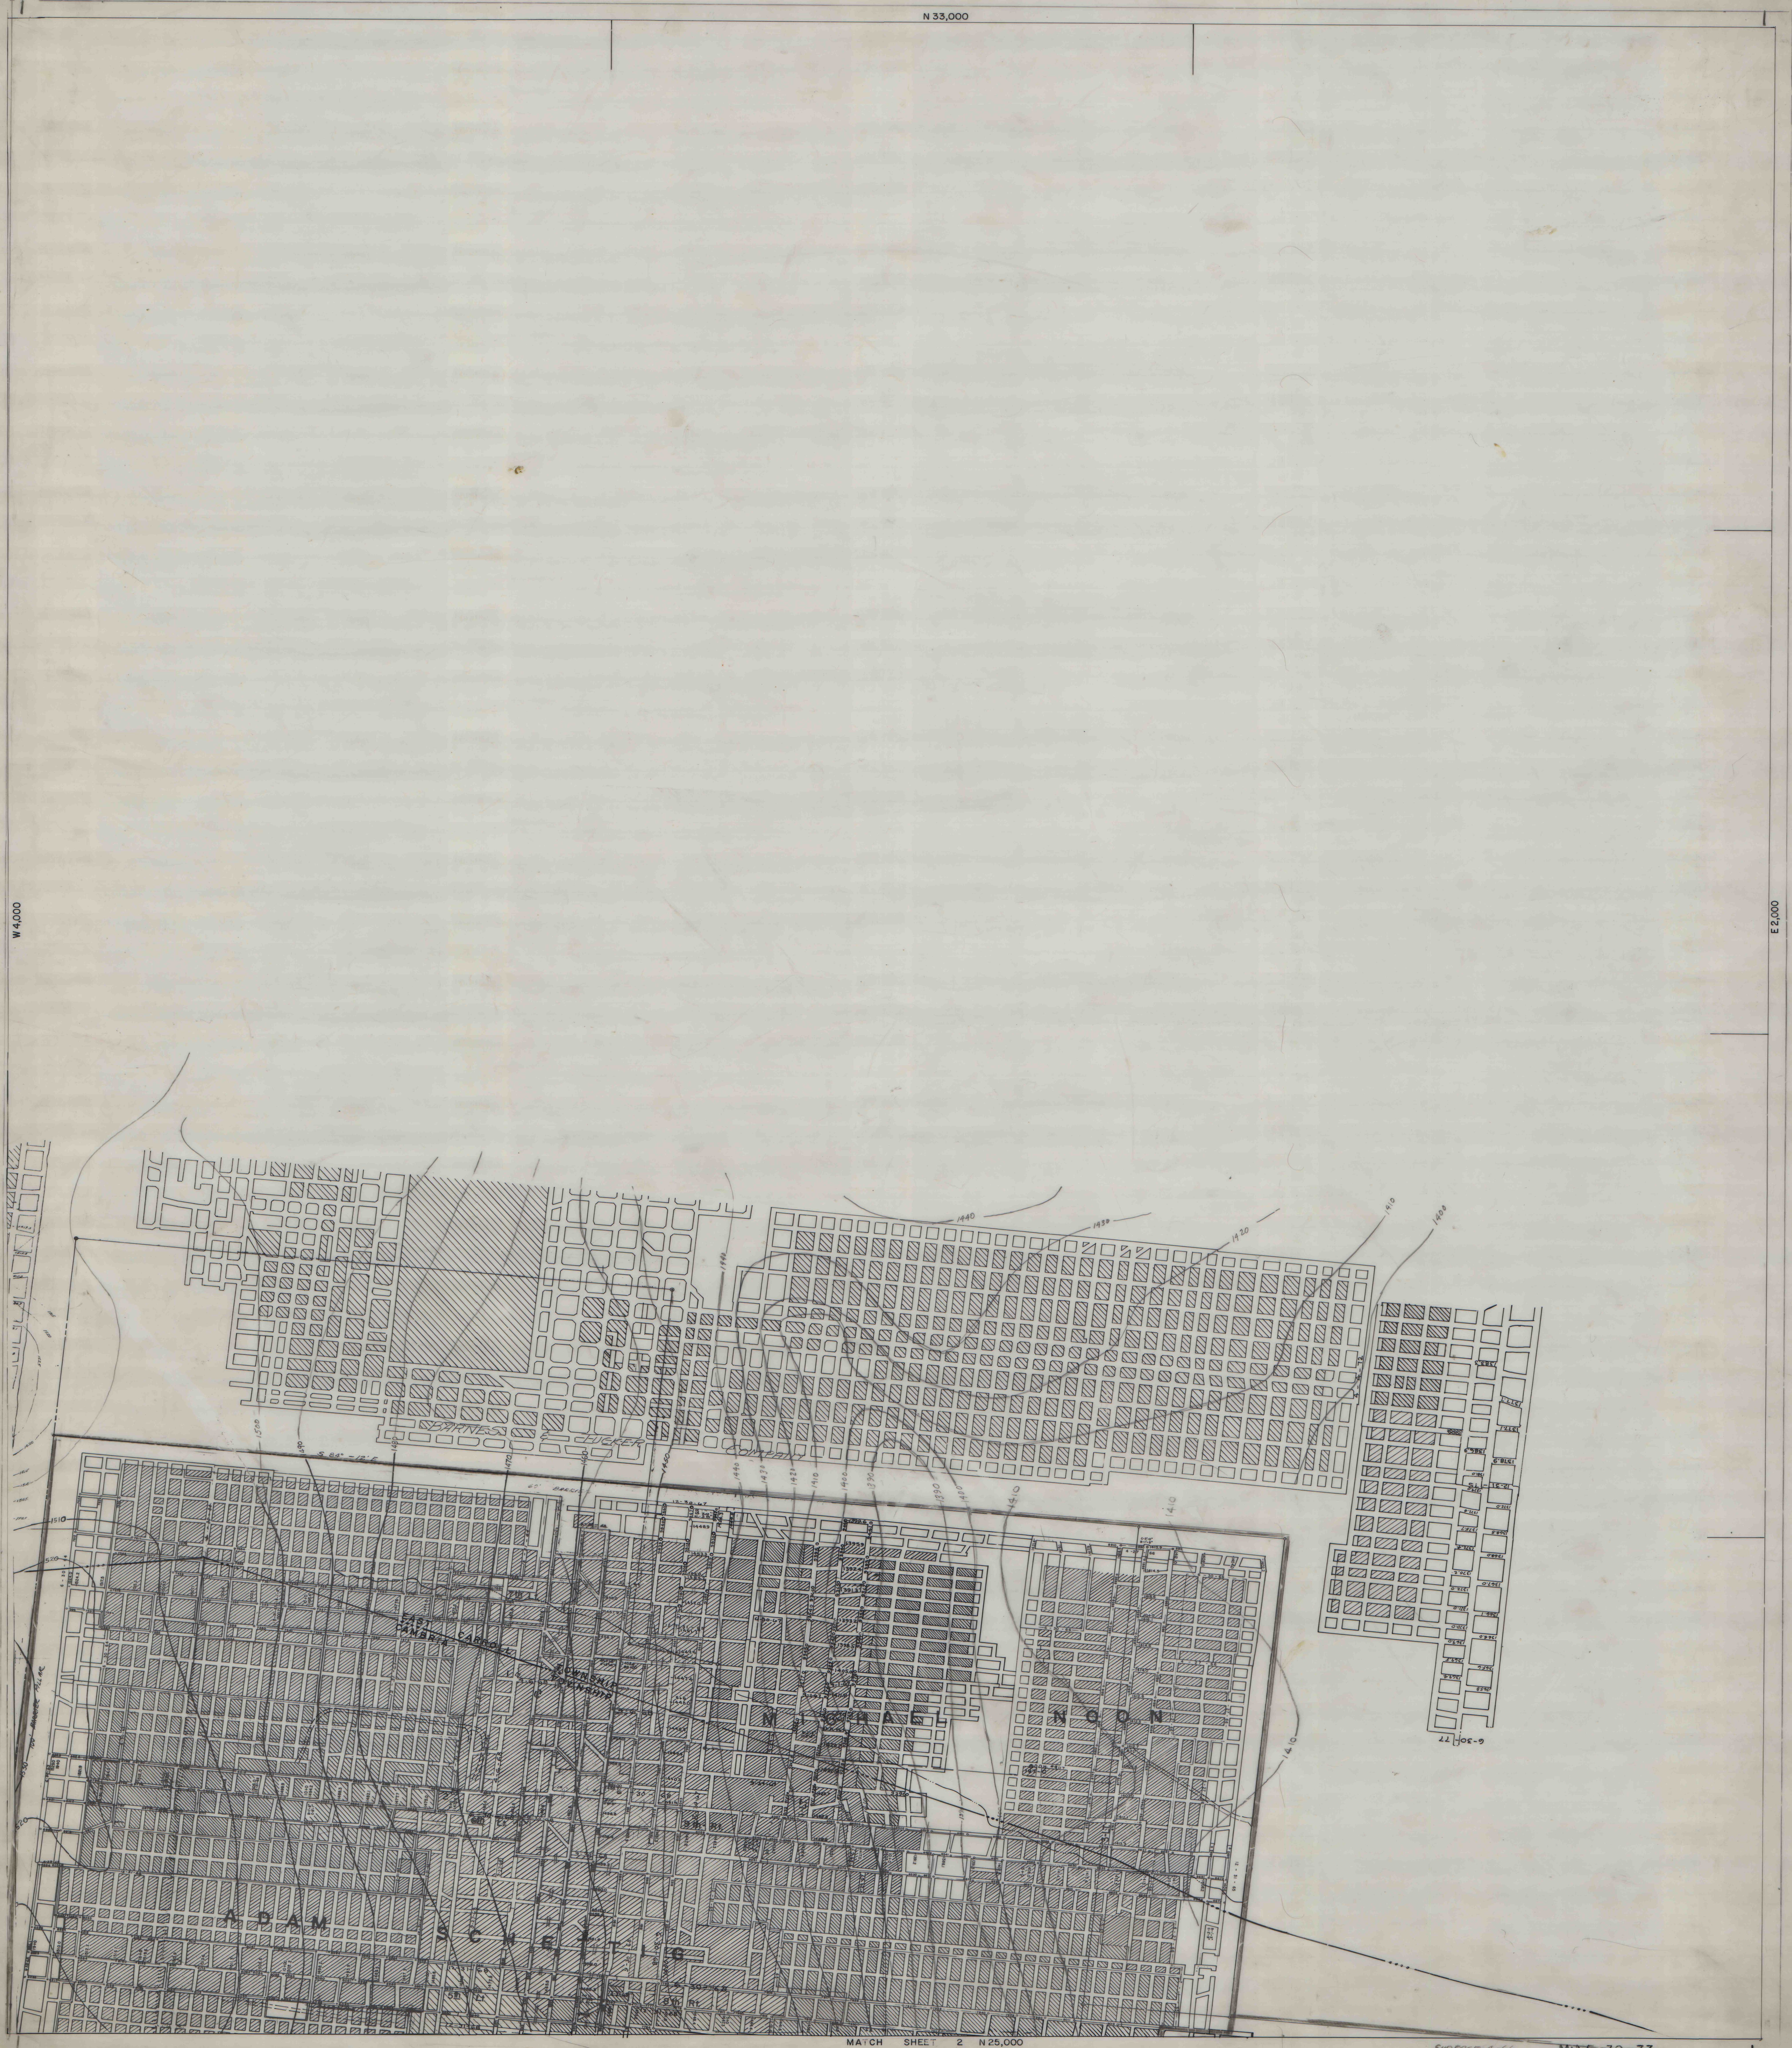
N 33,000
W 4,000
E 2,000
BARNES & TUCKER COMPANY
S 84° - 12' E
EAST CARROLL TOWNSHIP
CAMBRIA TOWNSHIP
MICHAEL NOON
ADAM SCHETTIG
100' BARRIER PILLAR
1440
1430
1420
1410
1400
1390
1500
1490
1480
1470
1460
1450
1510
1520
1530
6-30-77
4-4-72
12-31-75
12-31-65
MATCH SHEET 2 N 25,000
SURFACE-4-66
MINE 32-33
1
SHEET-1 FOR OVERLAY