

CAMBRIA COUNTY

COMMISSIONERS


FRANK

F. CALANDRA

THOMAS DEY

MATCH SHEET 8 WA 000

MATCH SHEET 10 E2,000

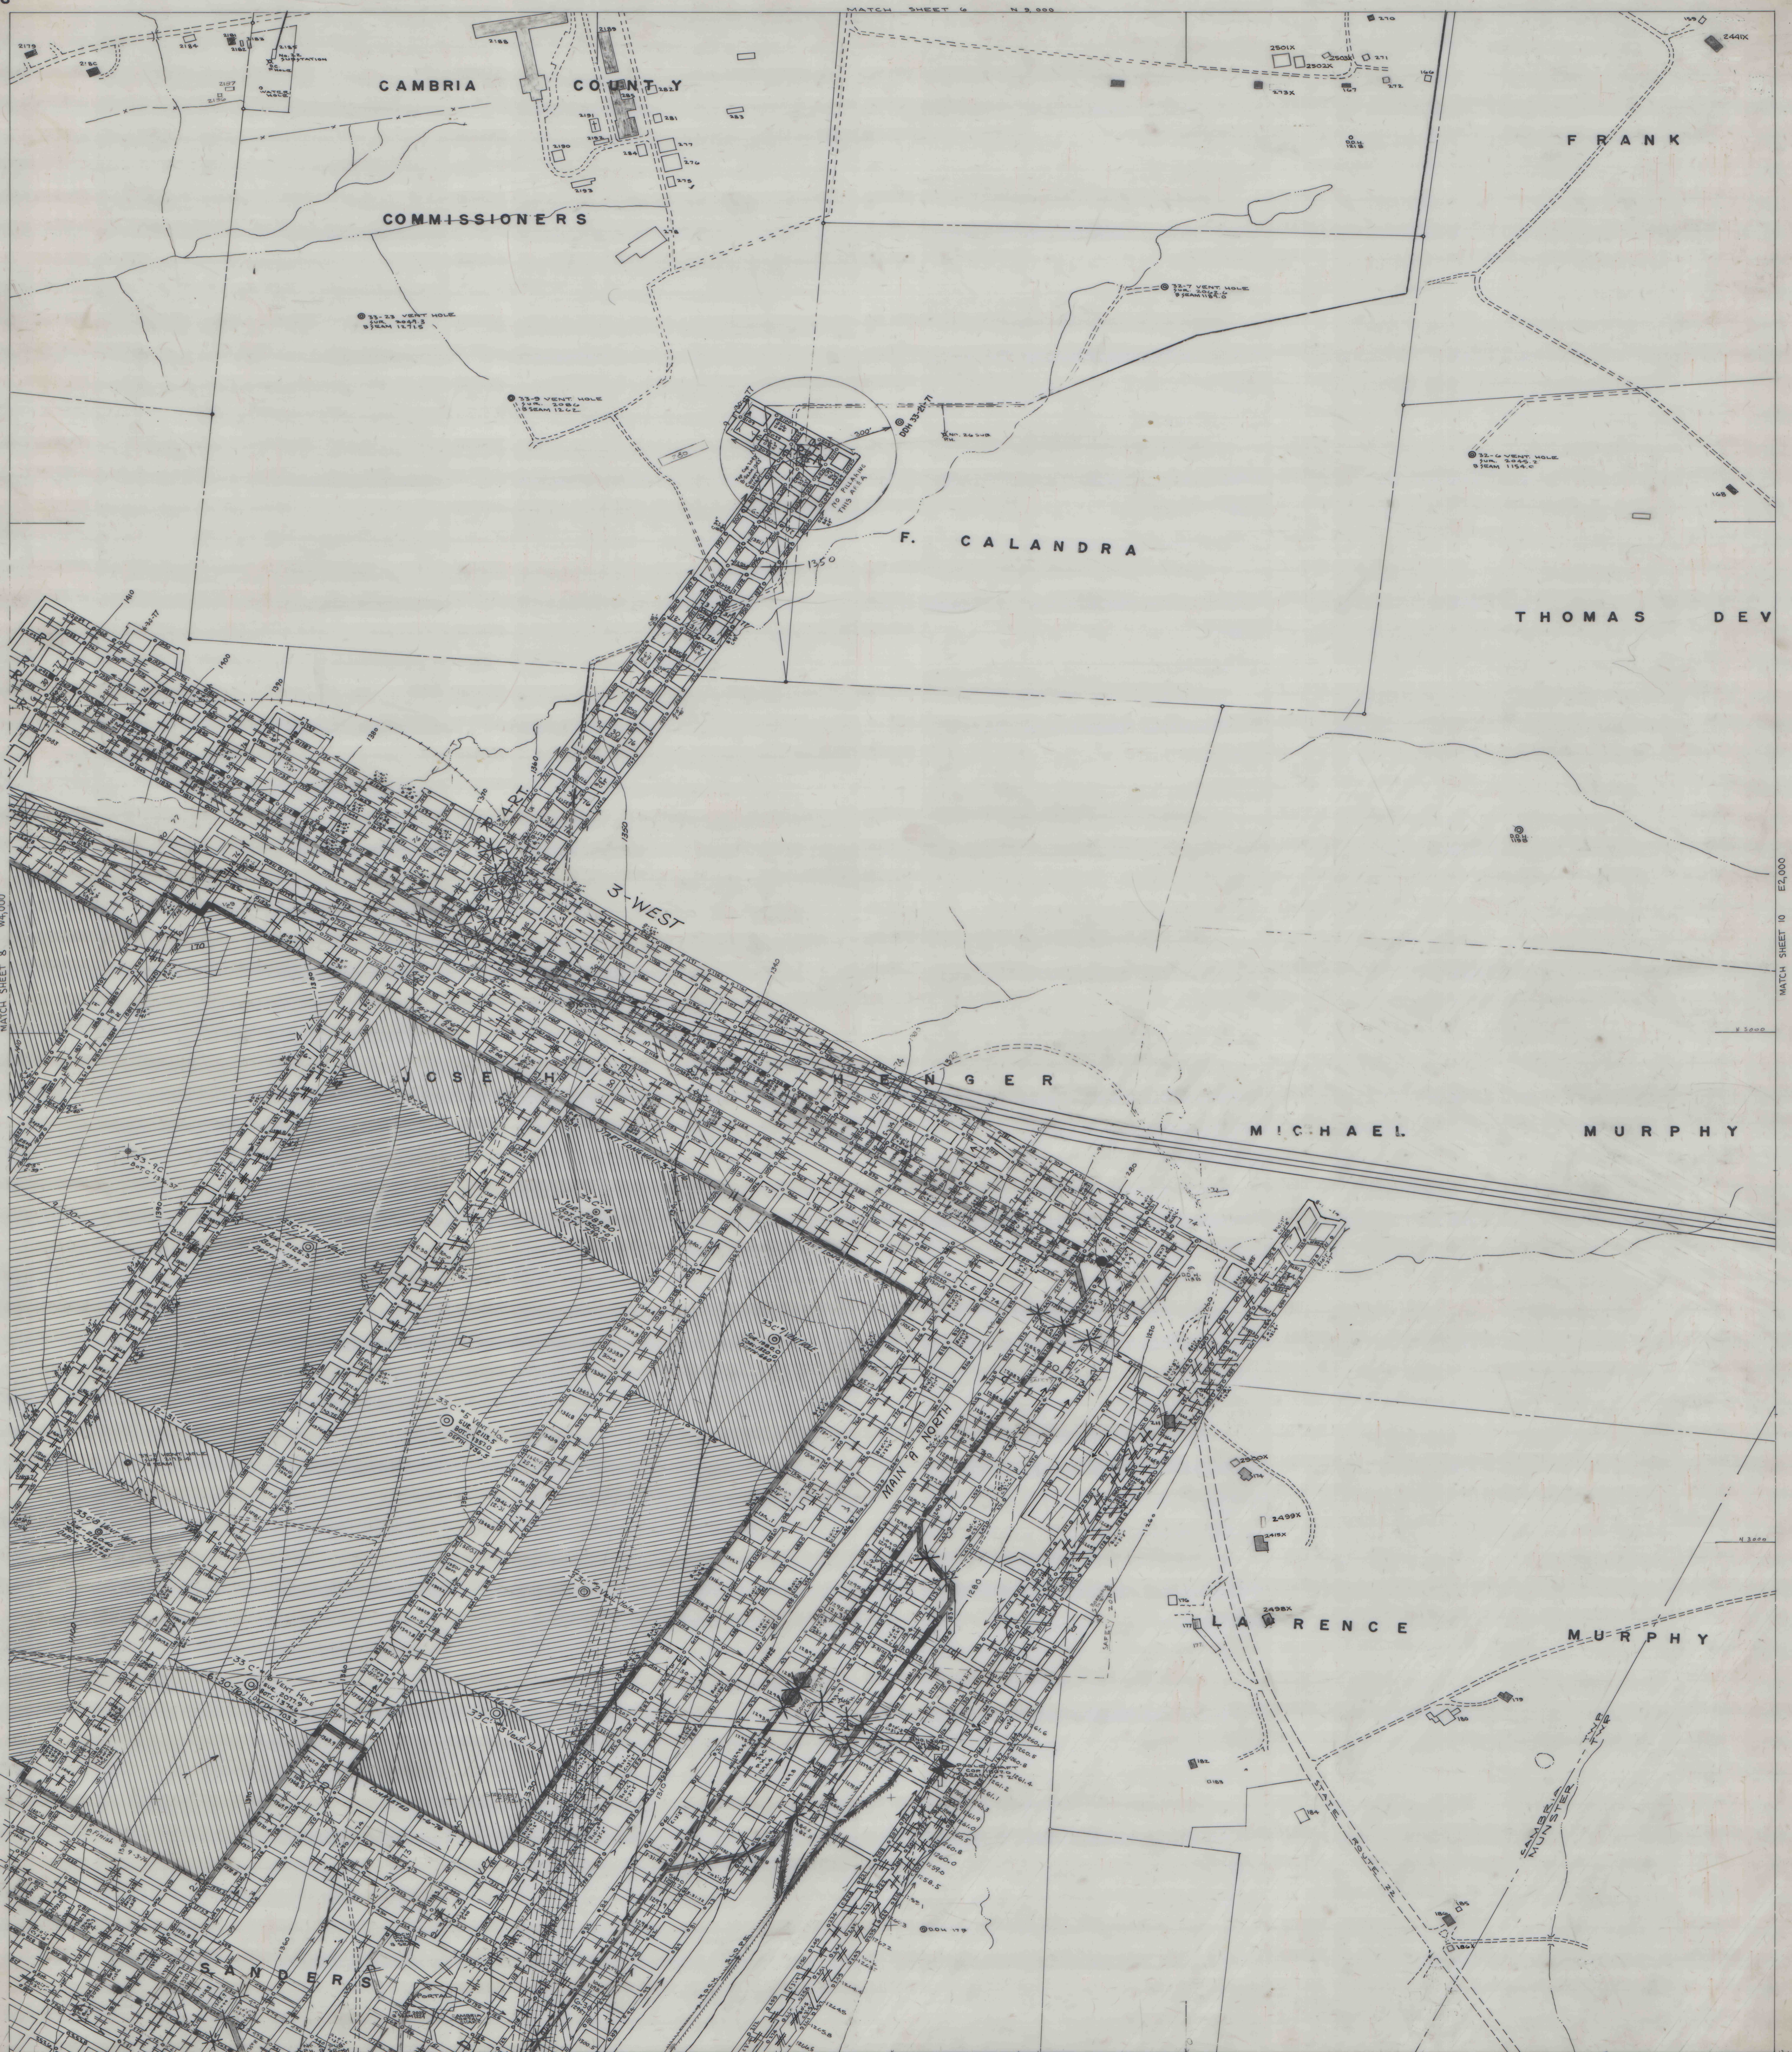

MATCH SHEET 12 N1,000

MINE 33-C'