
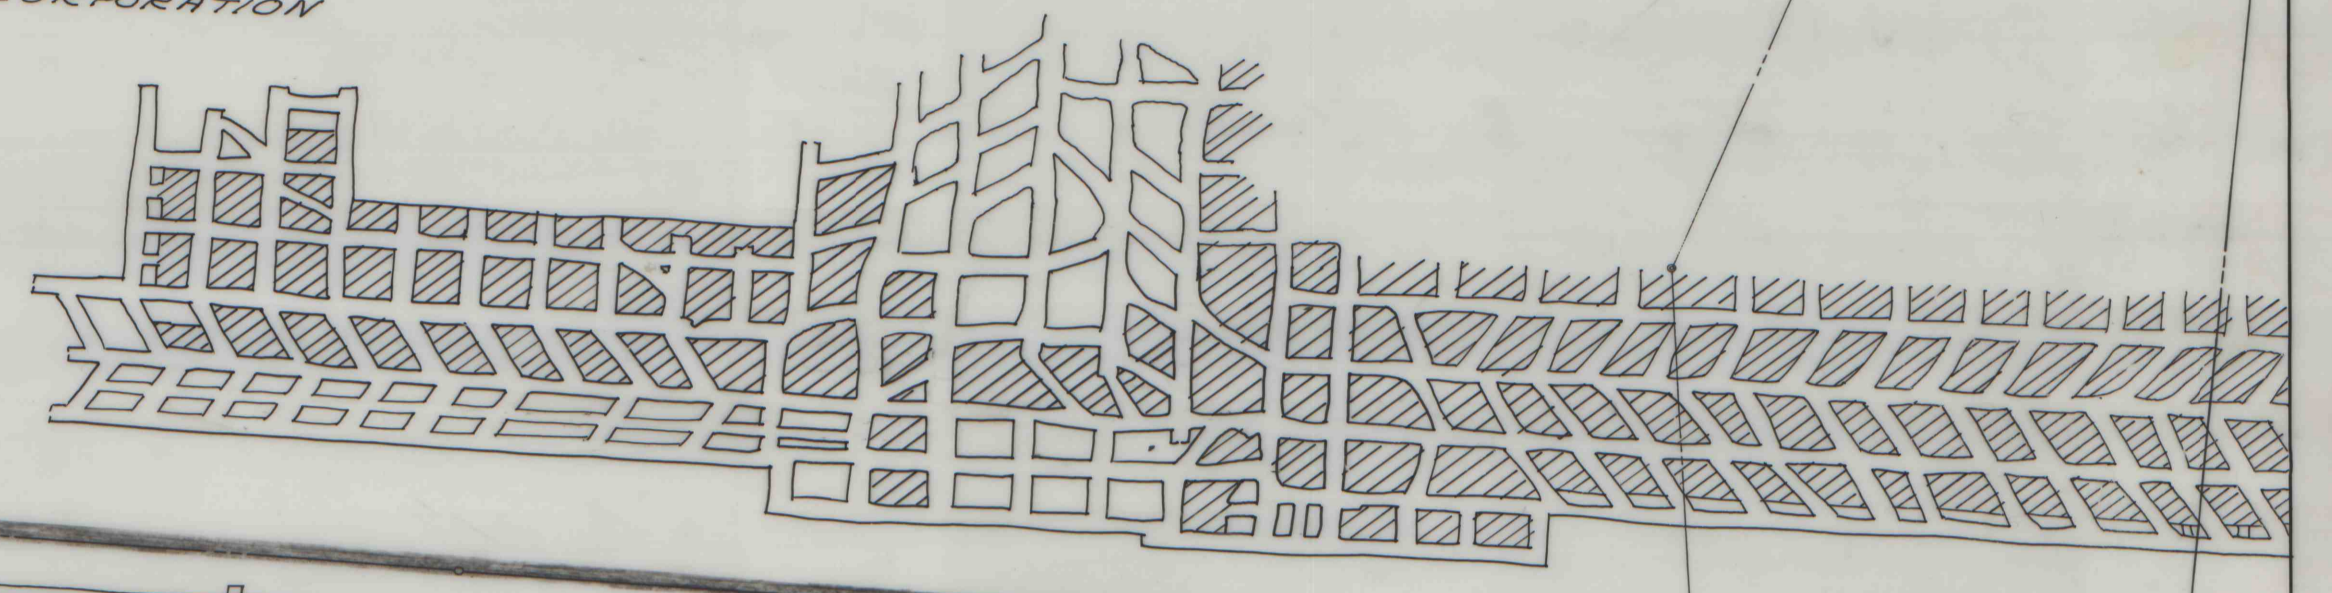


EASTERN ASSOCIATED COAL CORPORATION

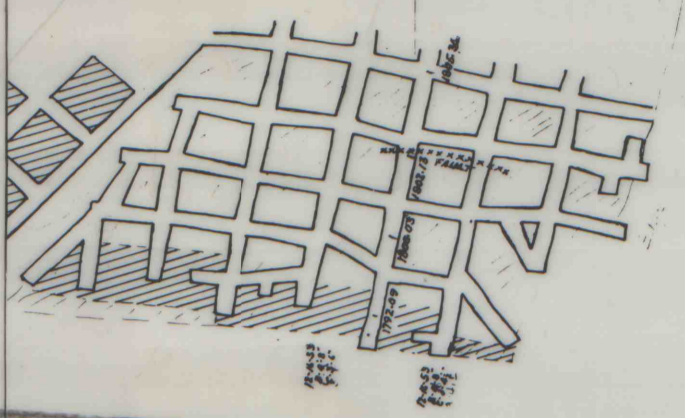

MATCH SHEET 15

MATCH SHEET 17