


EASTERN ASSOCIATED COAL CORPORATION

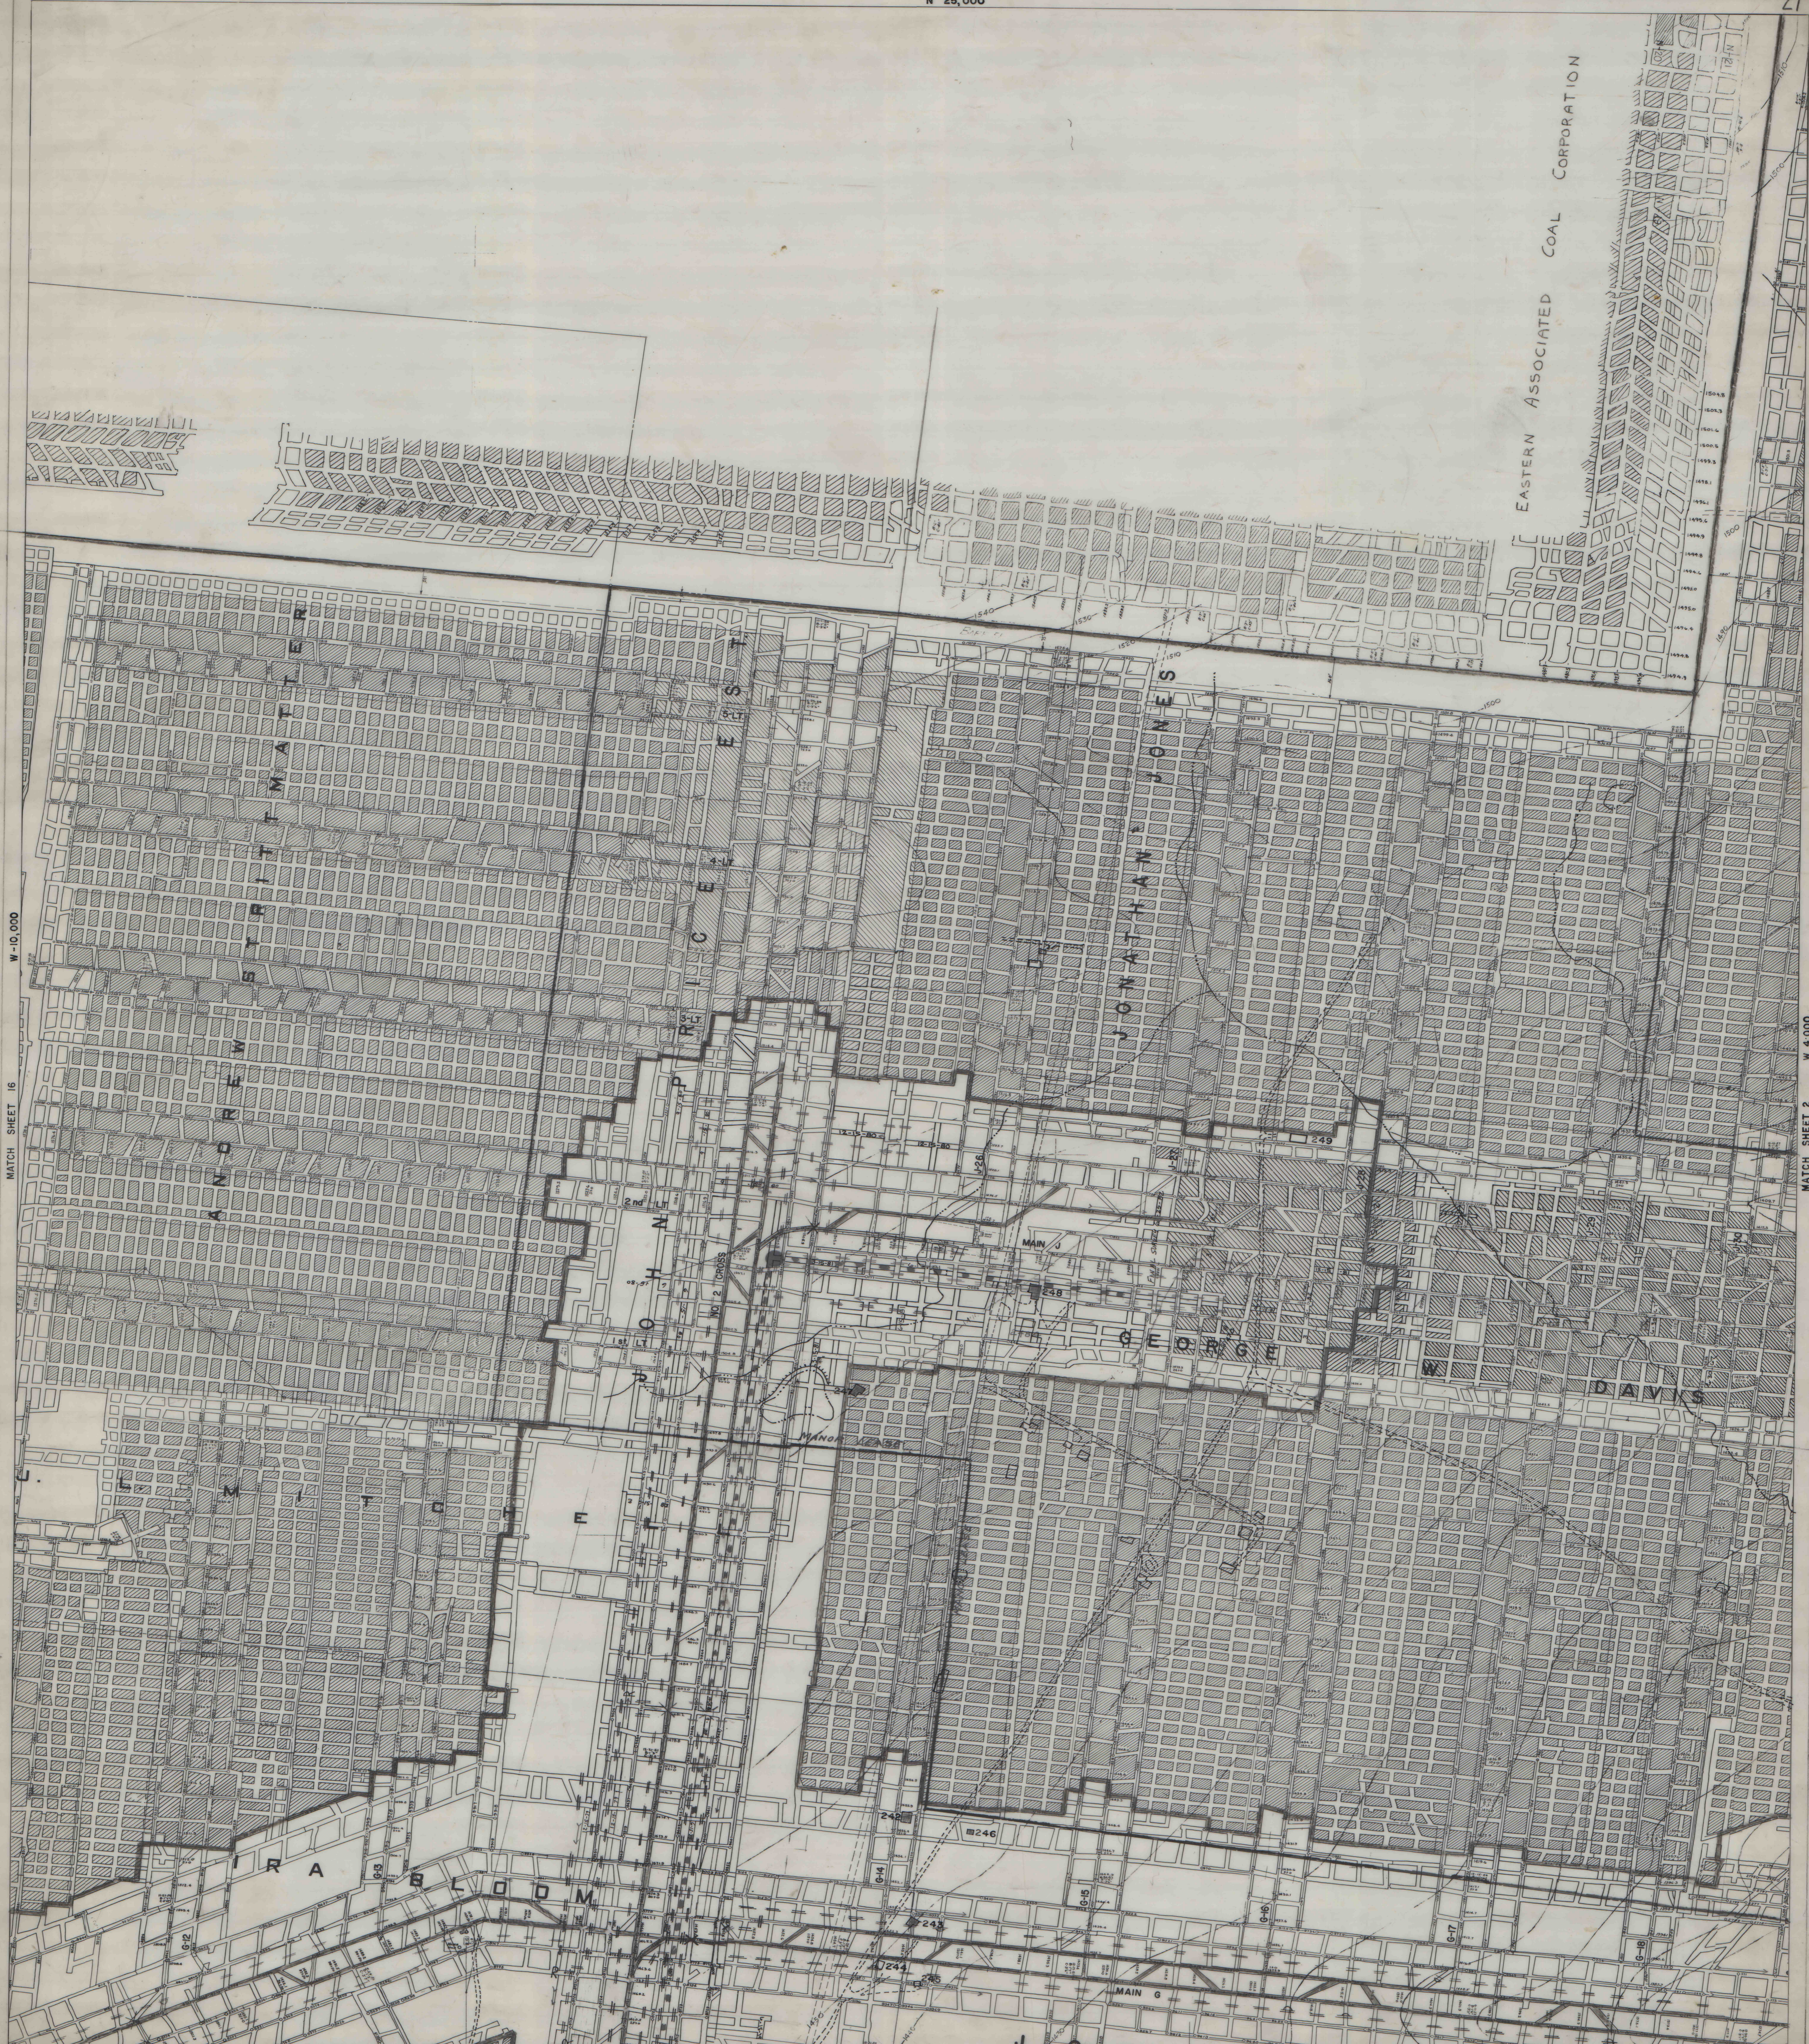

MATCH SHEET 16 W-10,000

MATCH SHEET 2 W 4,000