


Red 2/19/53

Red 2/19/53

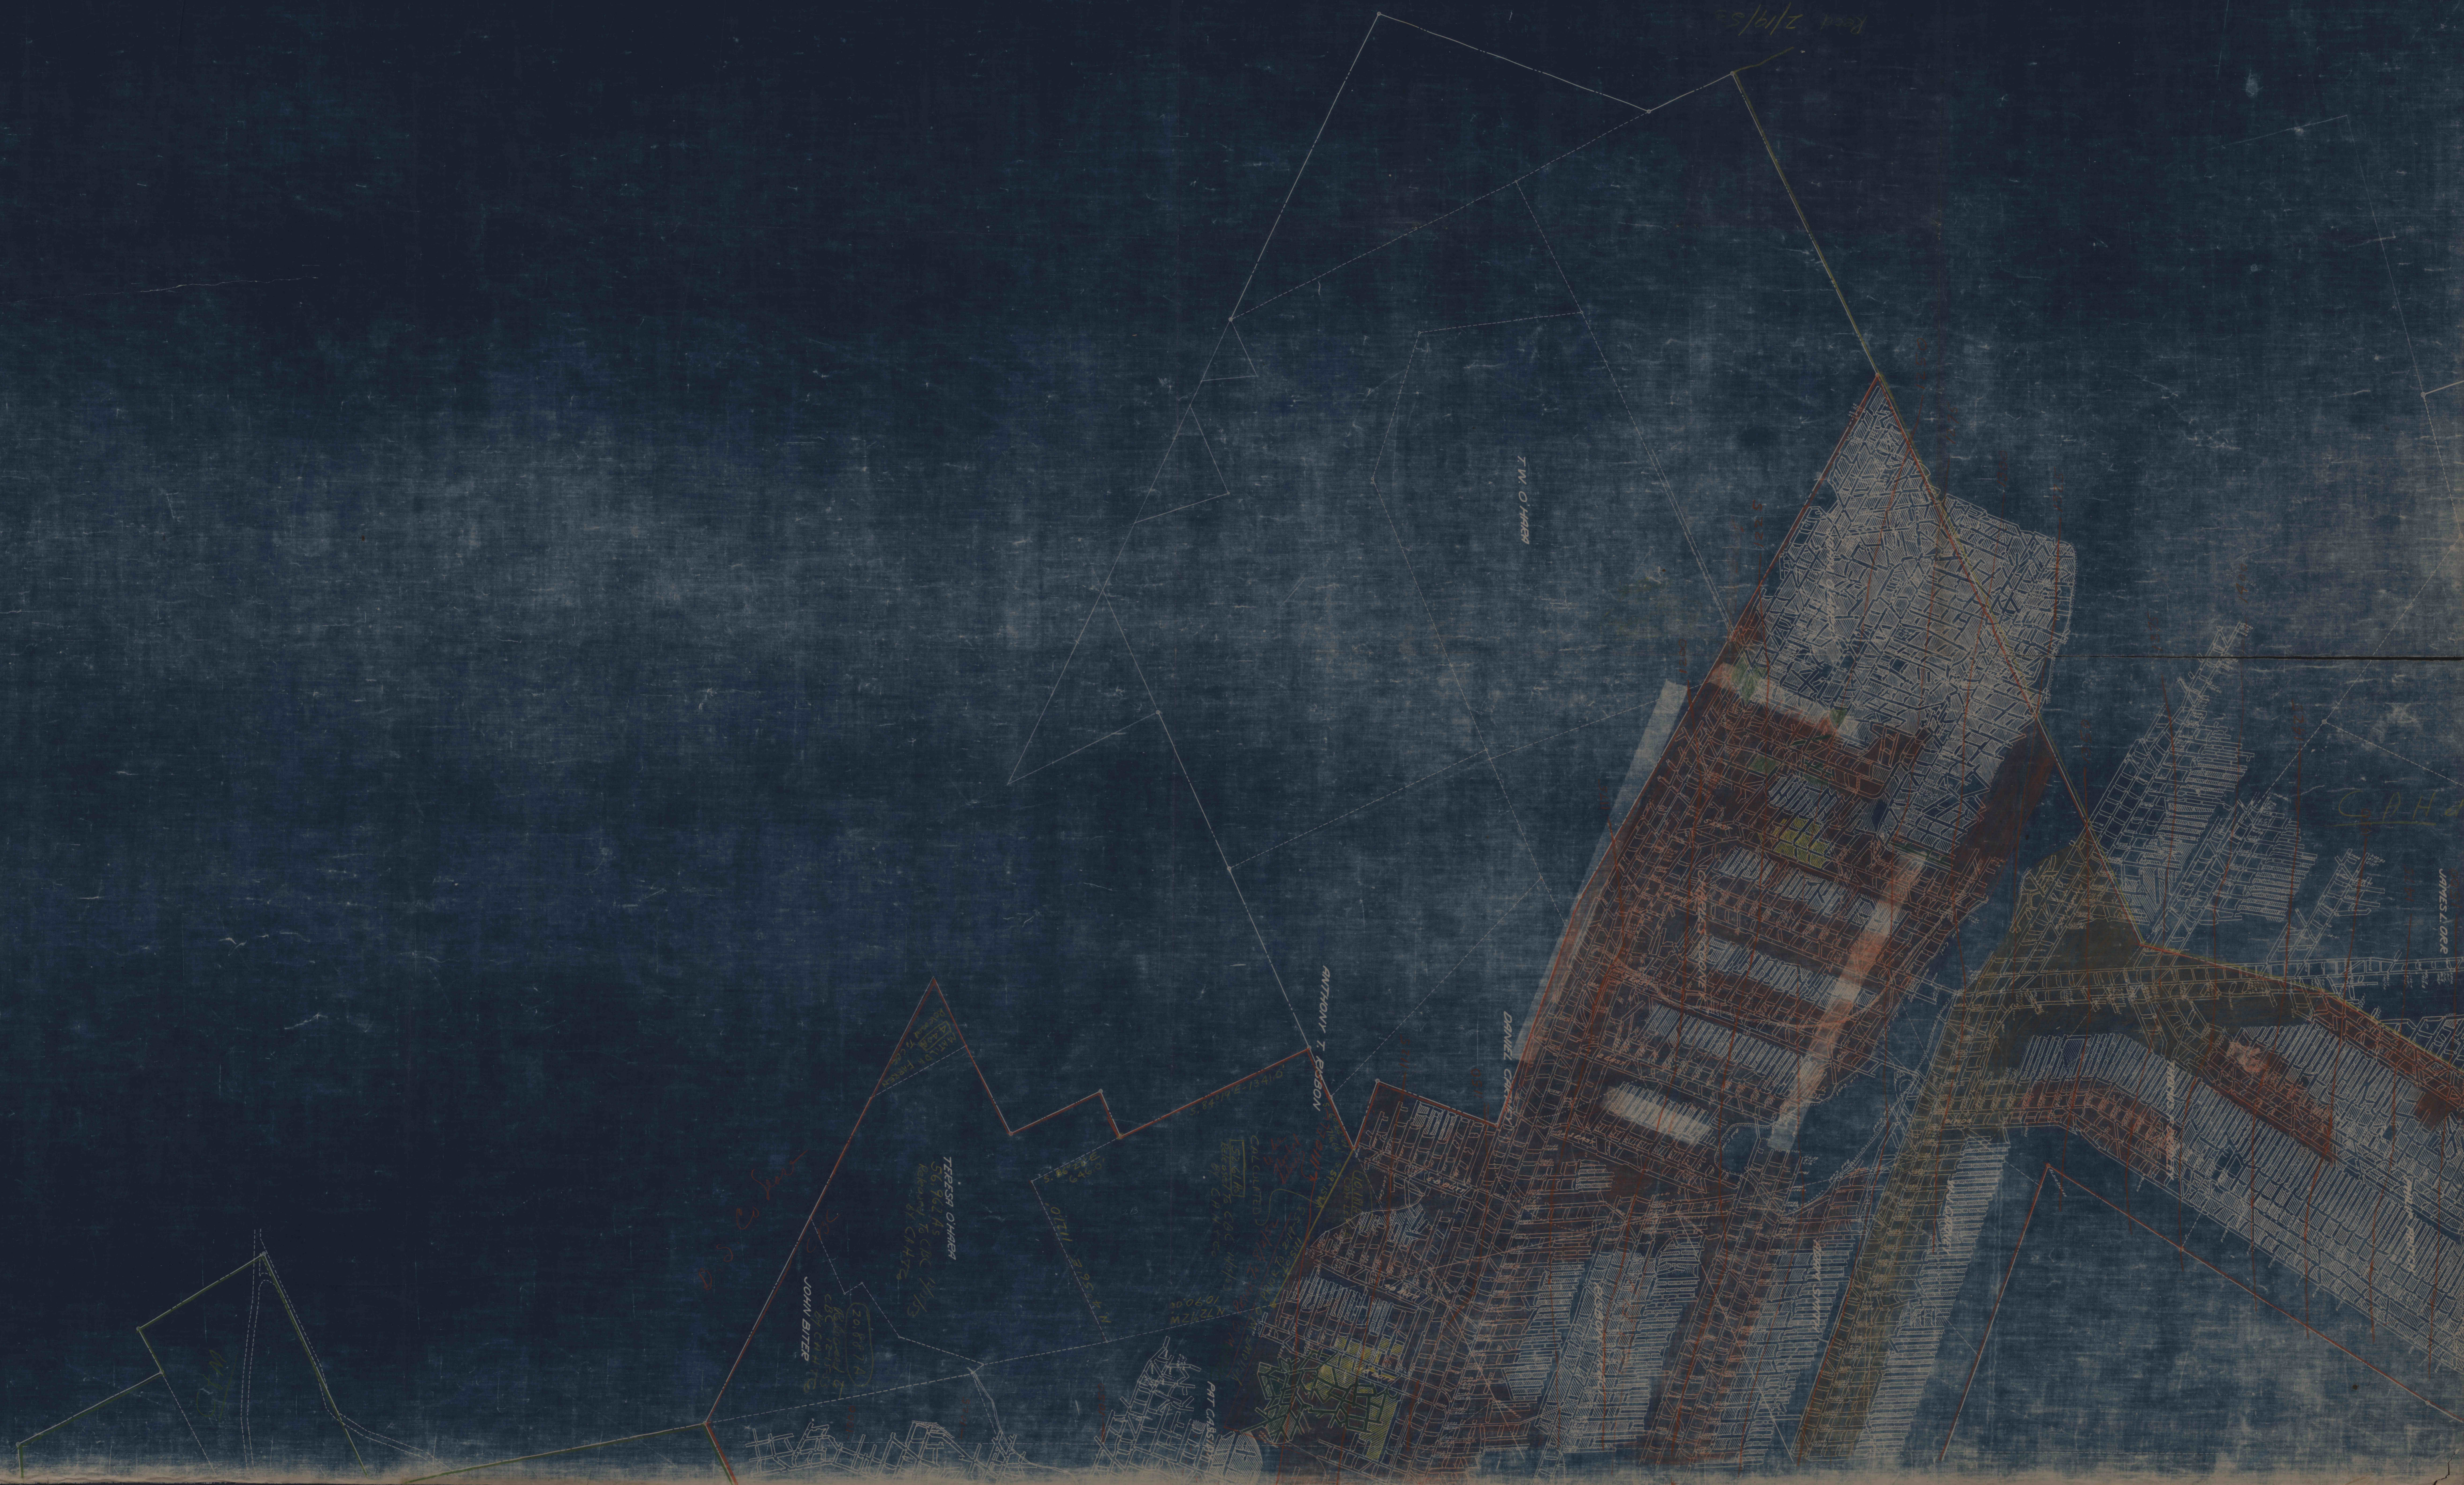

PROTINA  
1953