


Box 2/191

Box 2/191

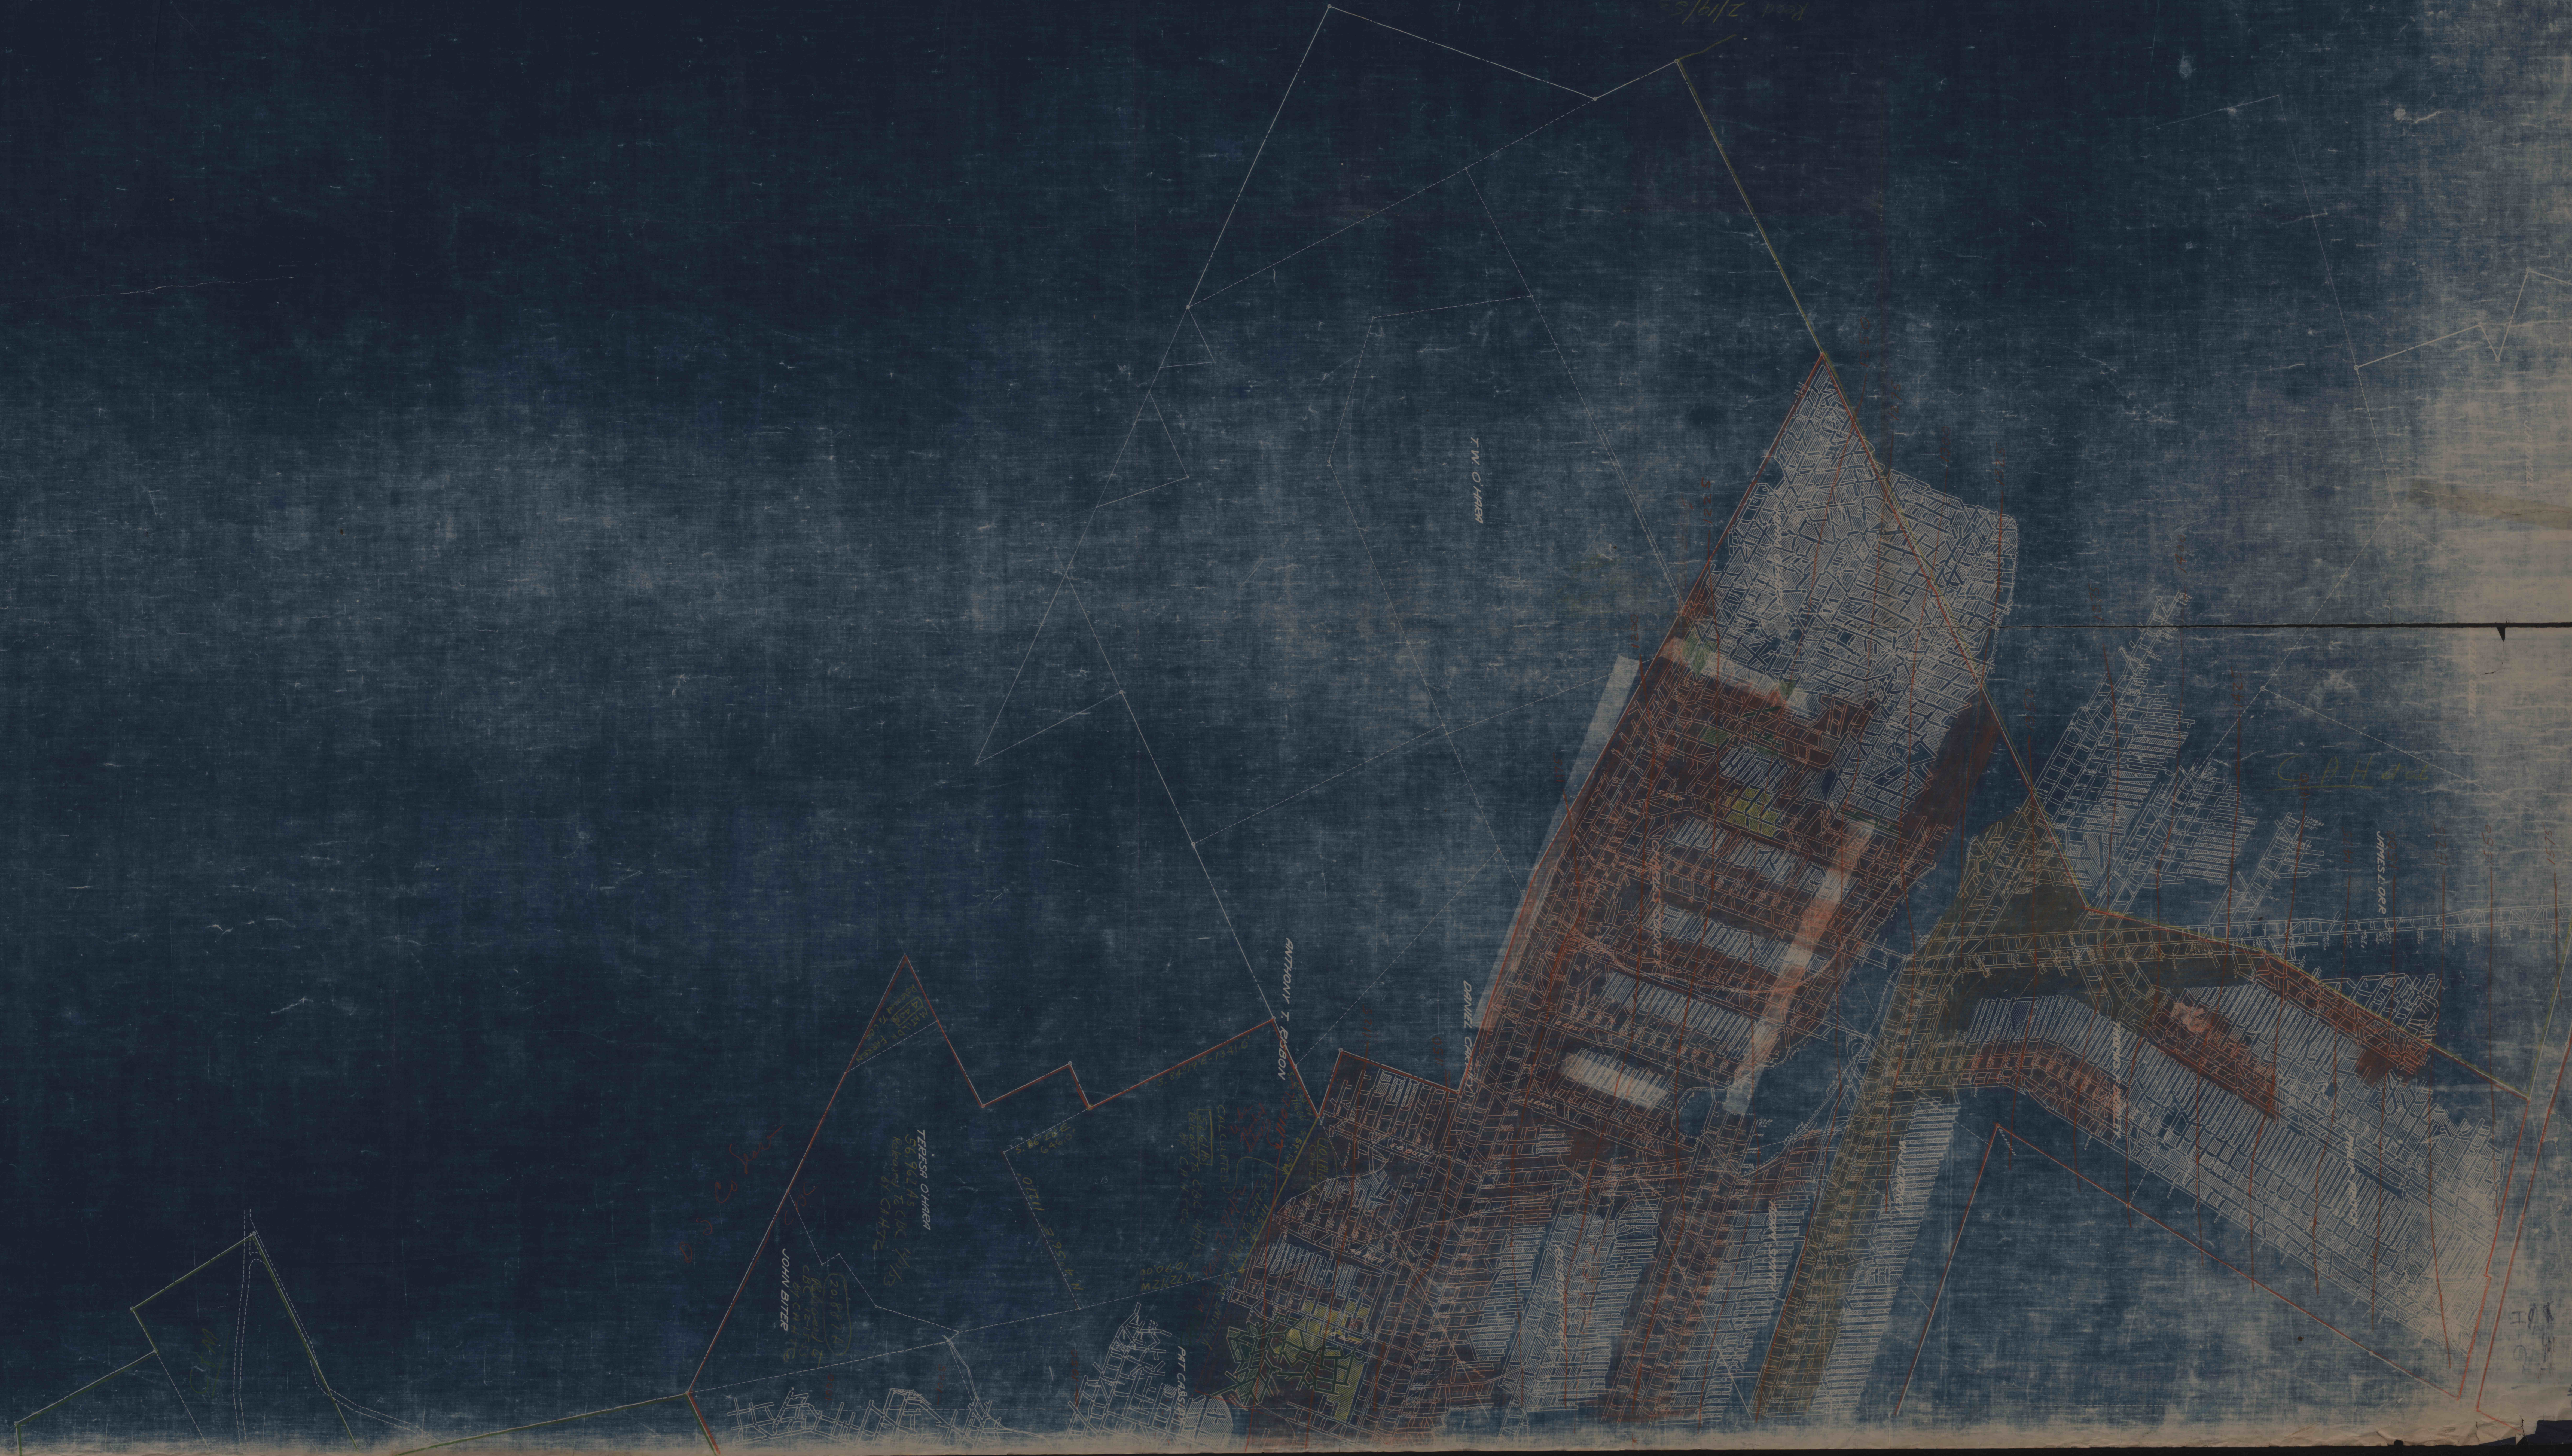

JOHN BITEE  
 1890  
 1891  
