


*Jameson's land
221 acres worked out of this mine
to see of 1857
about 200 ft to the north
discovered by
Jameson & Kingfield &

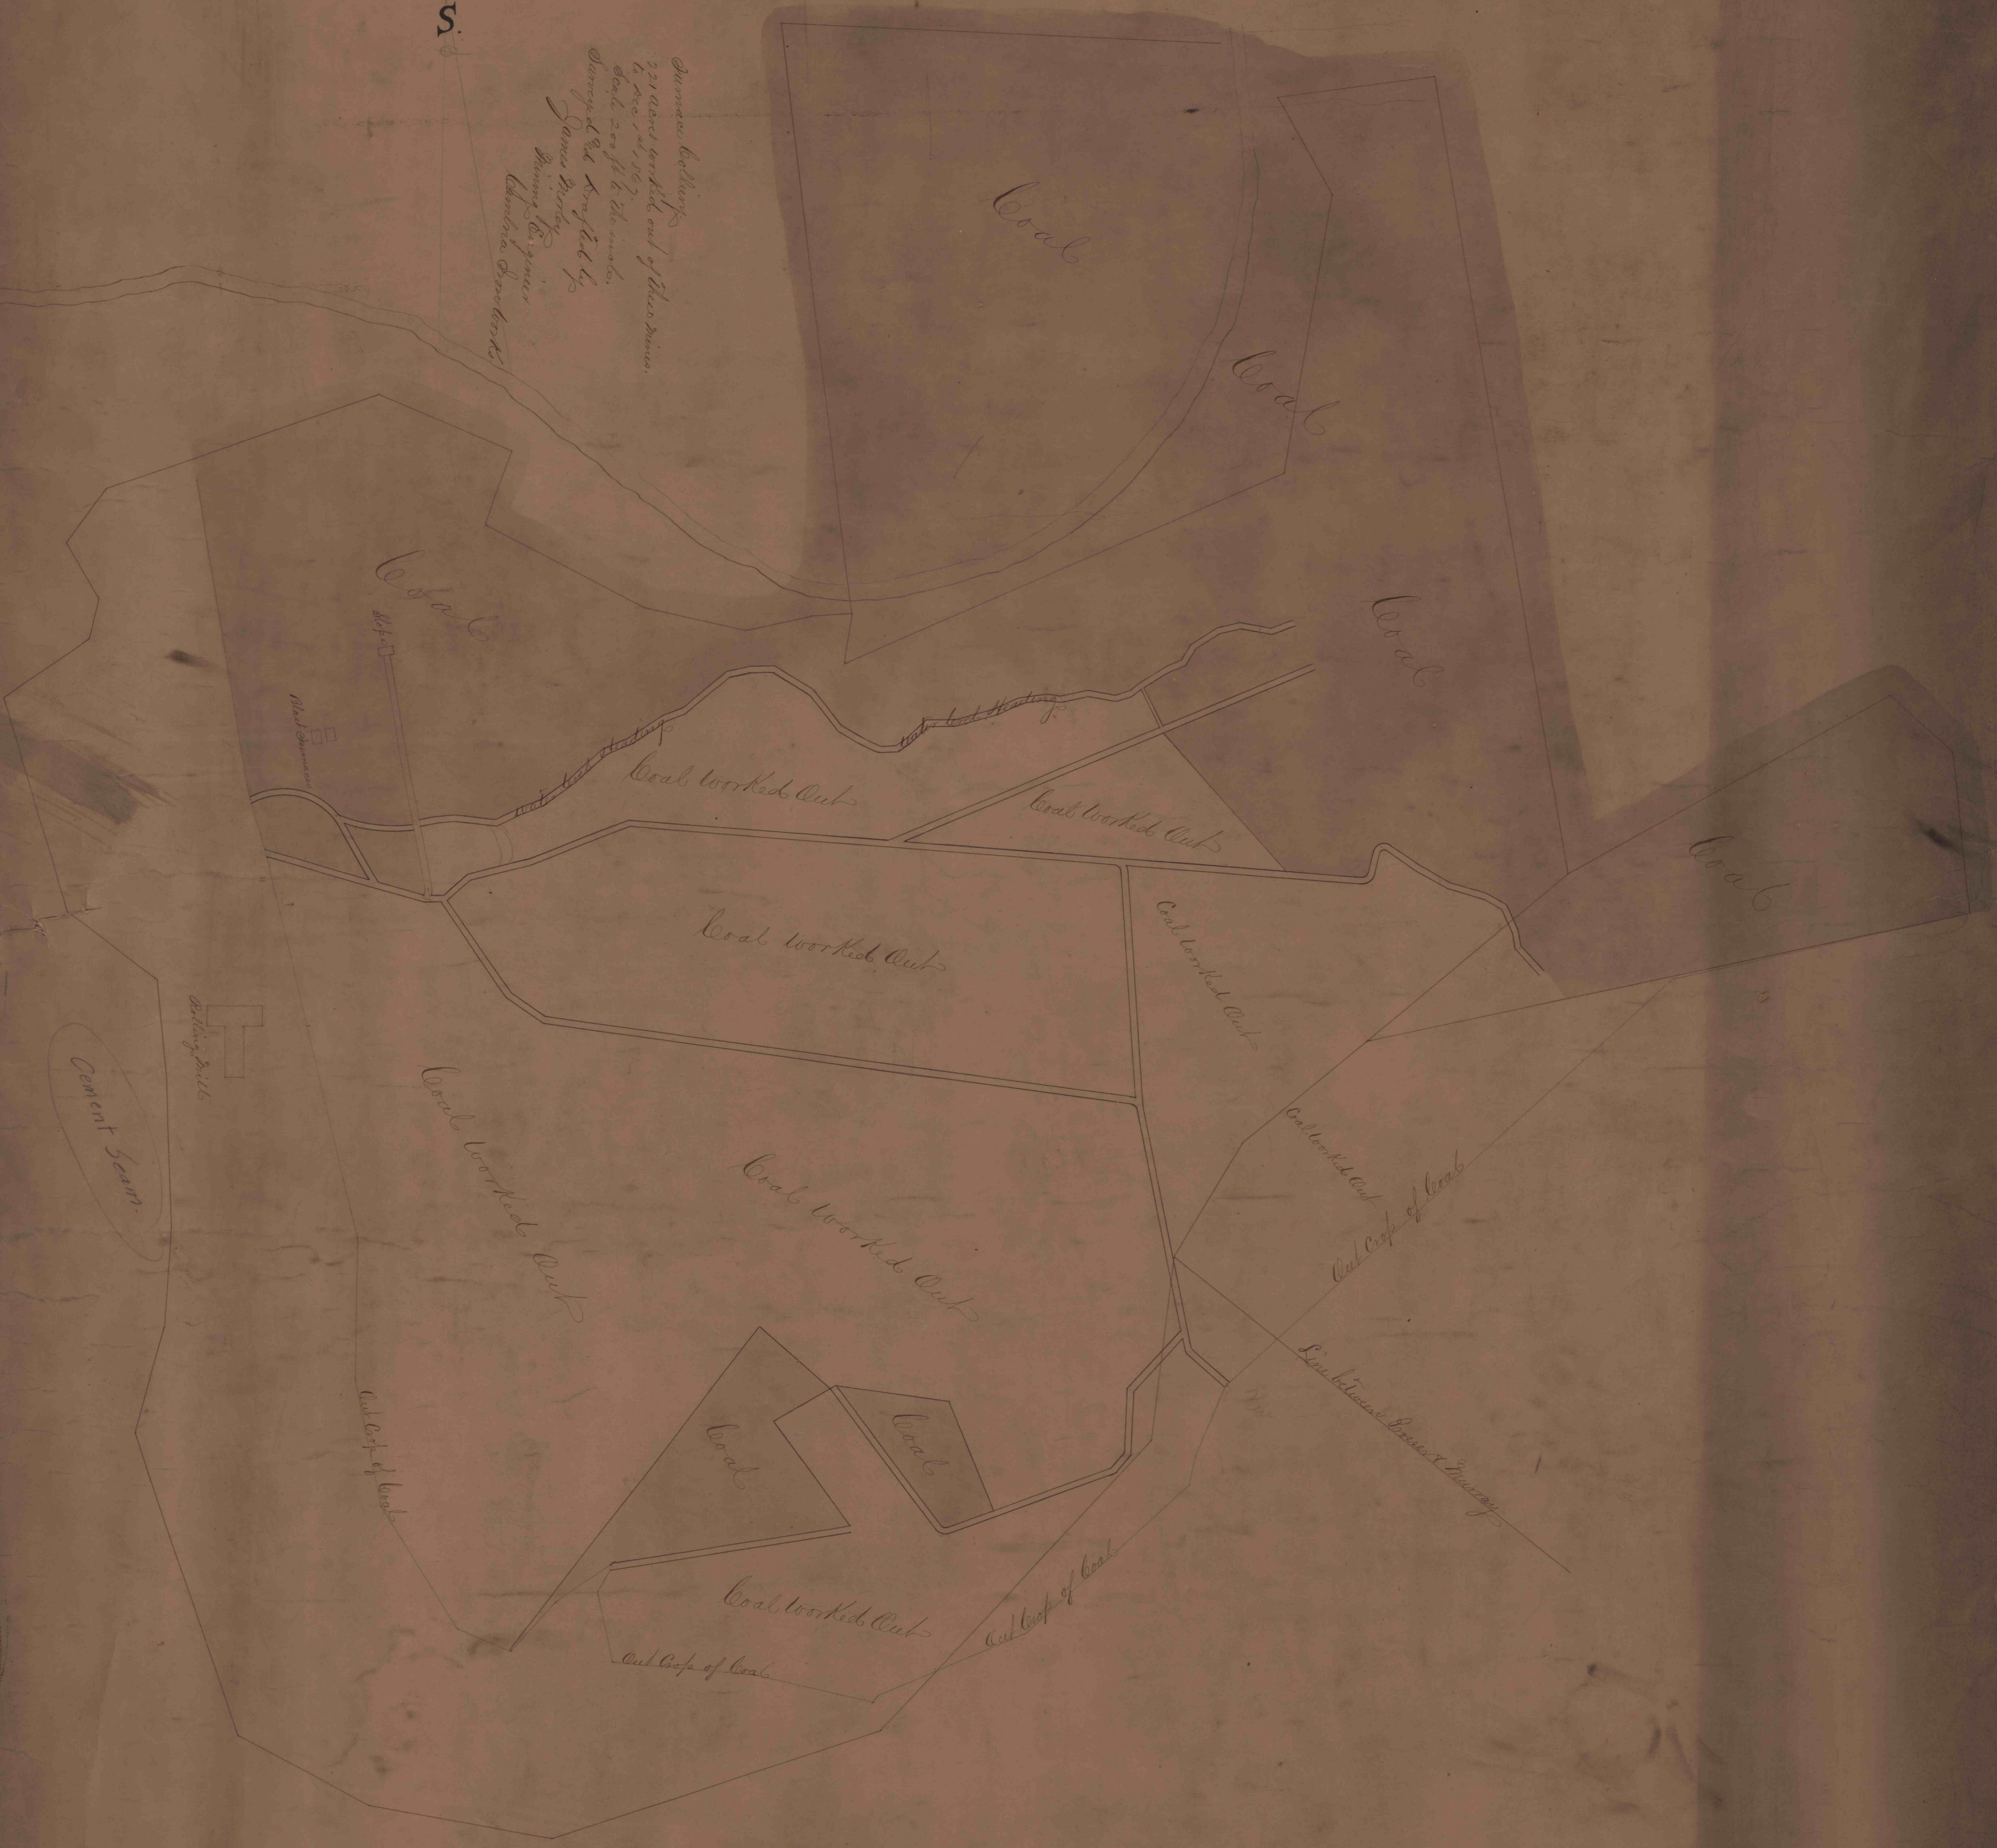

Concent Seam

Adit

Coal left of coal

Coal

Coal

Coal worked out

Coal left of coal

Subsidiary adit

Coal left of coal

Coal worked out

Coal worked out

Coal worked out

Coal worked out

Coal worked out

Coal

Coal

Coal

Coal

Coal