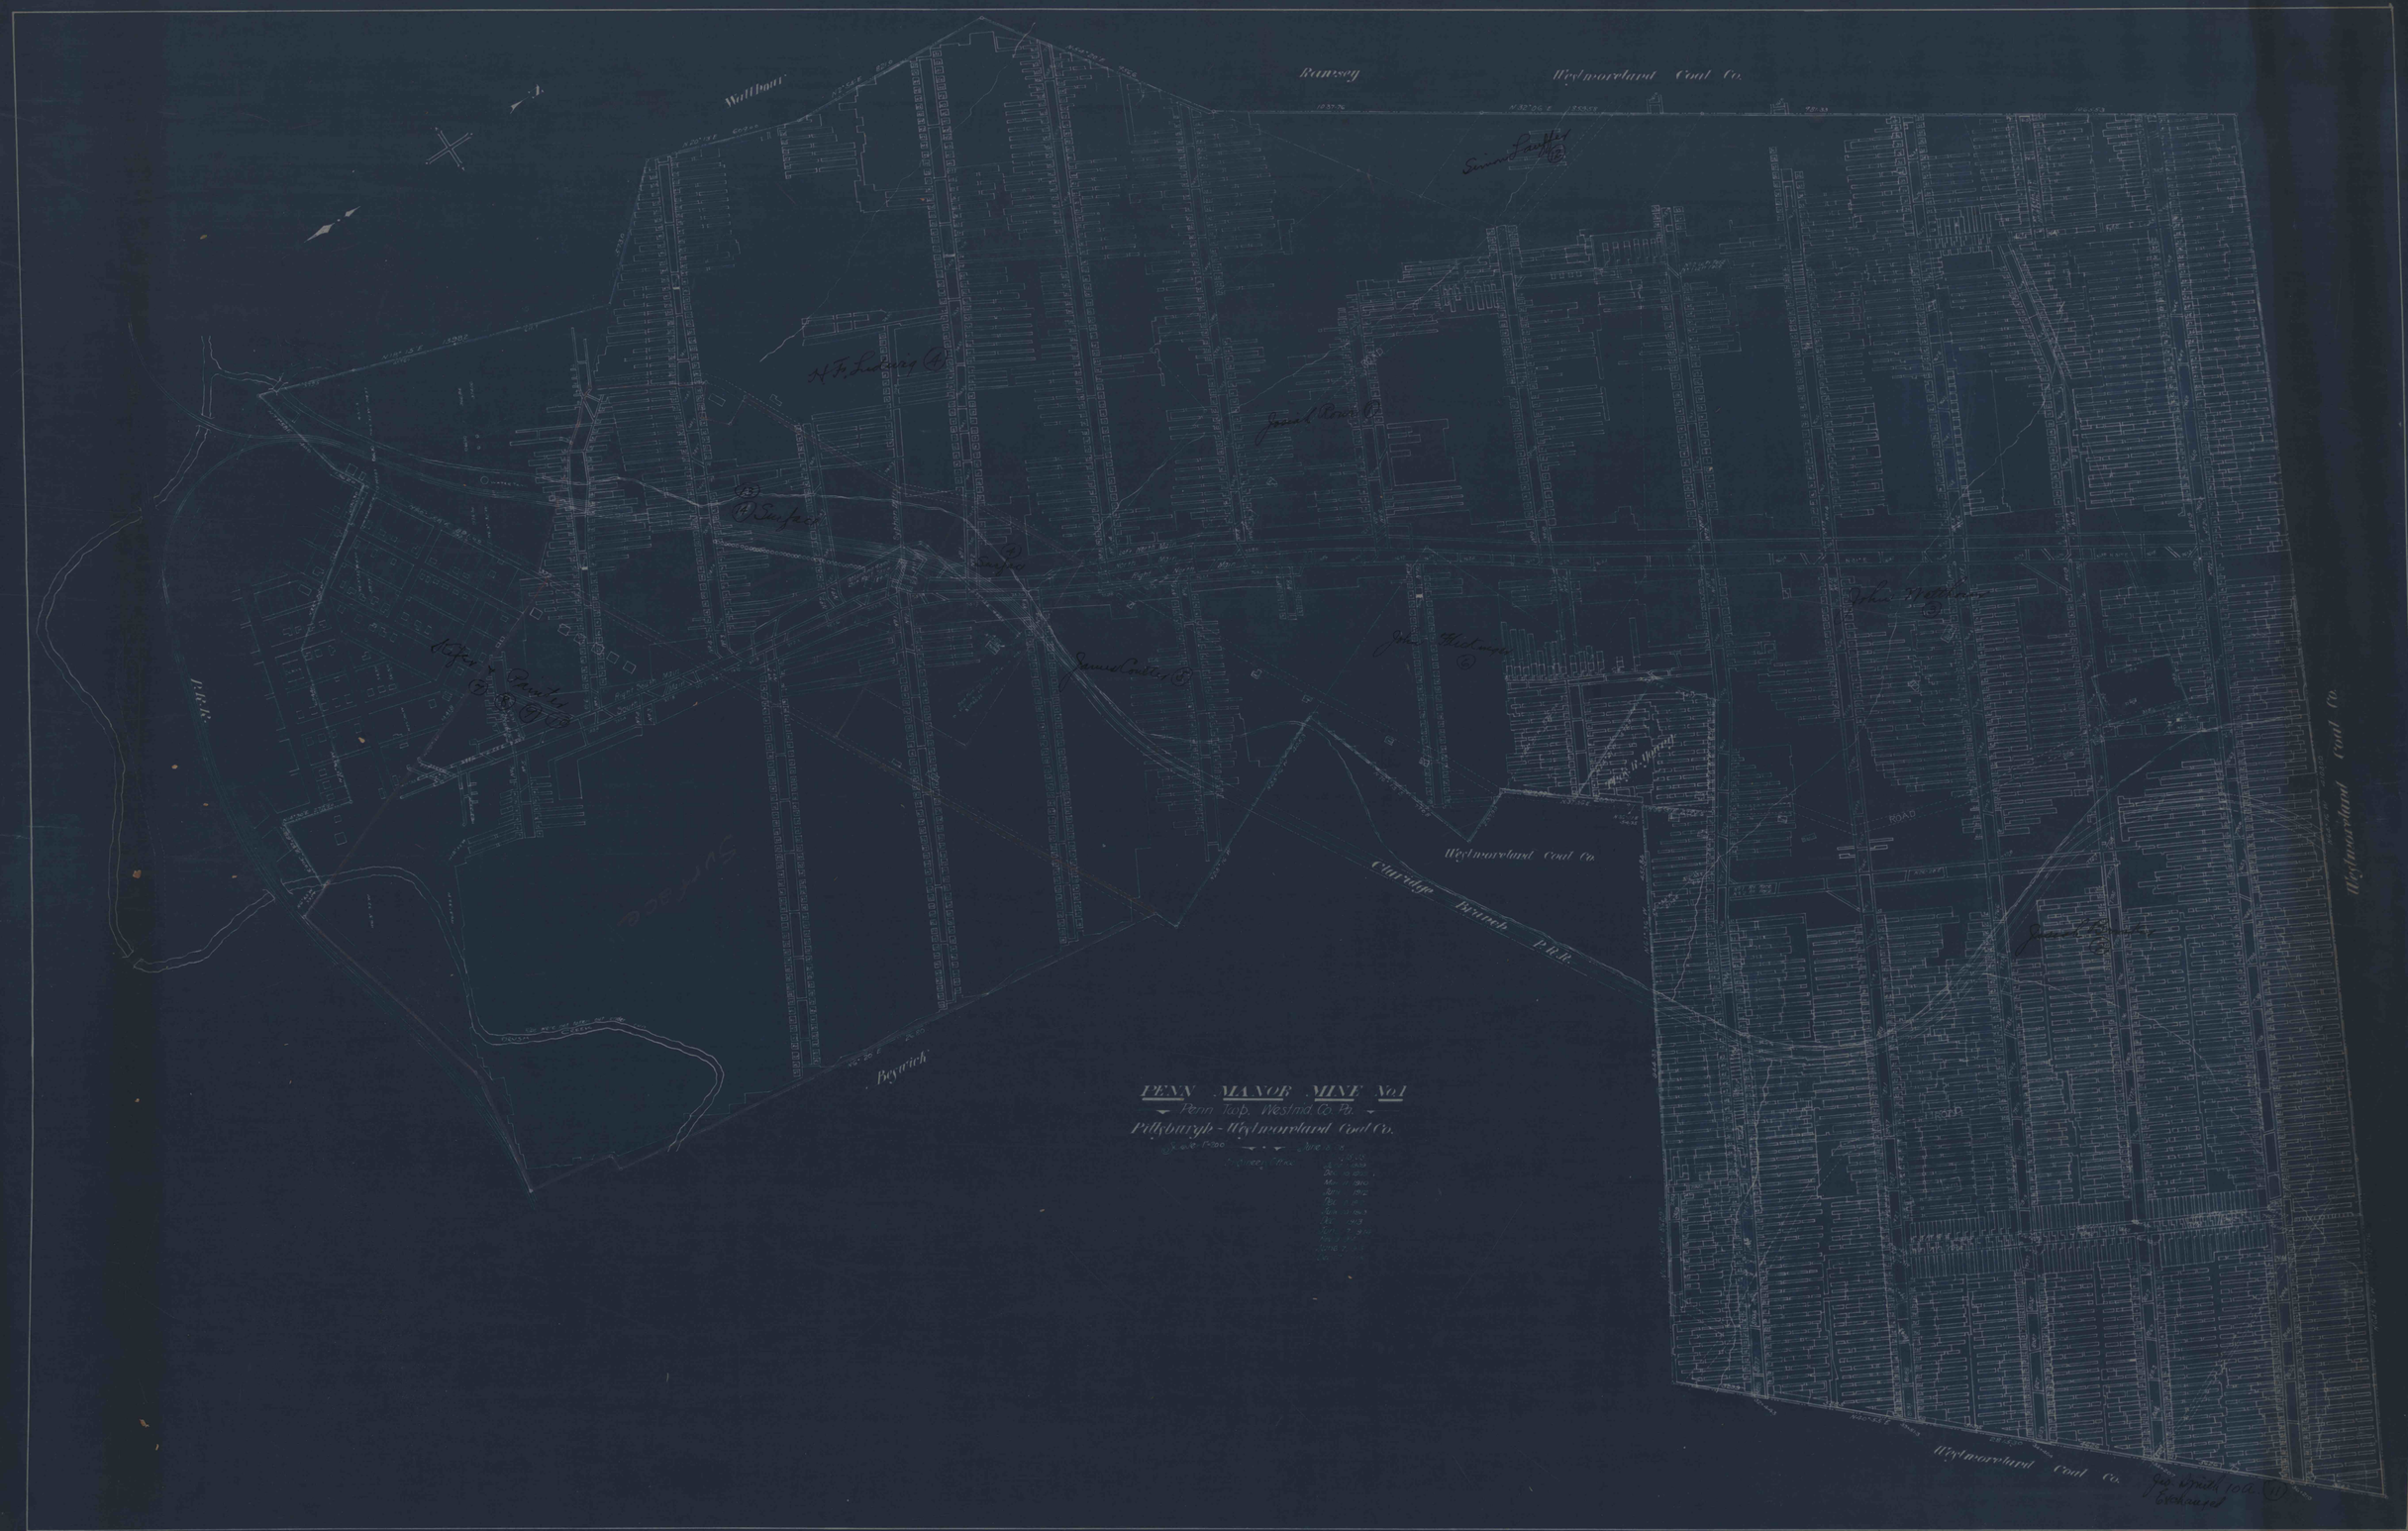
Wallbour
Ramsey
Westmoreland Coal Co.
Simon Lauffer
H. F. Ludwig
Josiah Rowe
Surface
Surface
Kifer & Pawley
James Cowley
John Thickinger
John Williams
Westmoreland Coal Co.
Claridge Branch P.R.R.
Beswick
Westmoreland Coal Co.
Westmoreland Coal Co.
Exchanged
PENN MANOR MINE No.1
Penn Twp. Westmd. Co. Pa.
Pittsburgh-Westmoreland Coal Co.