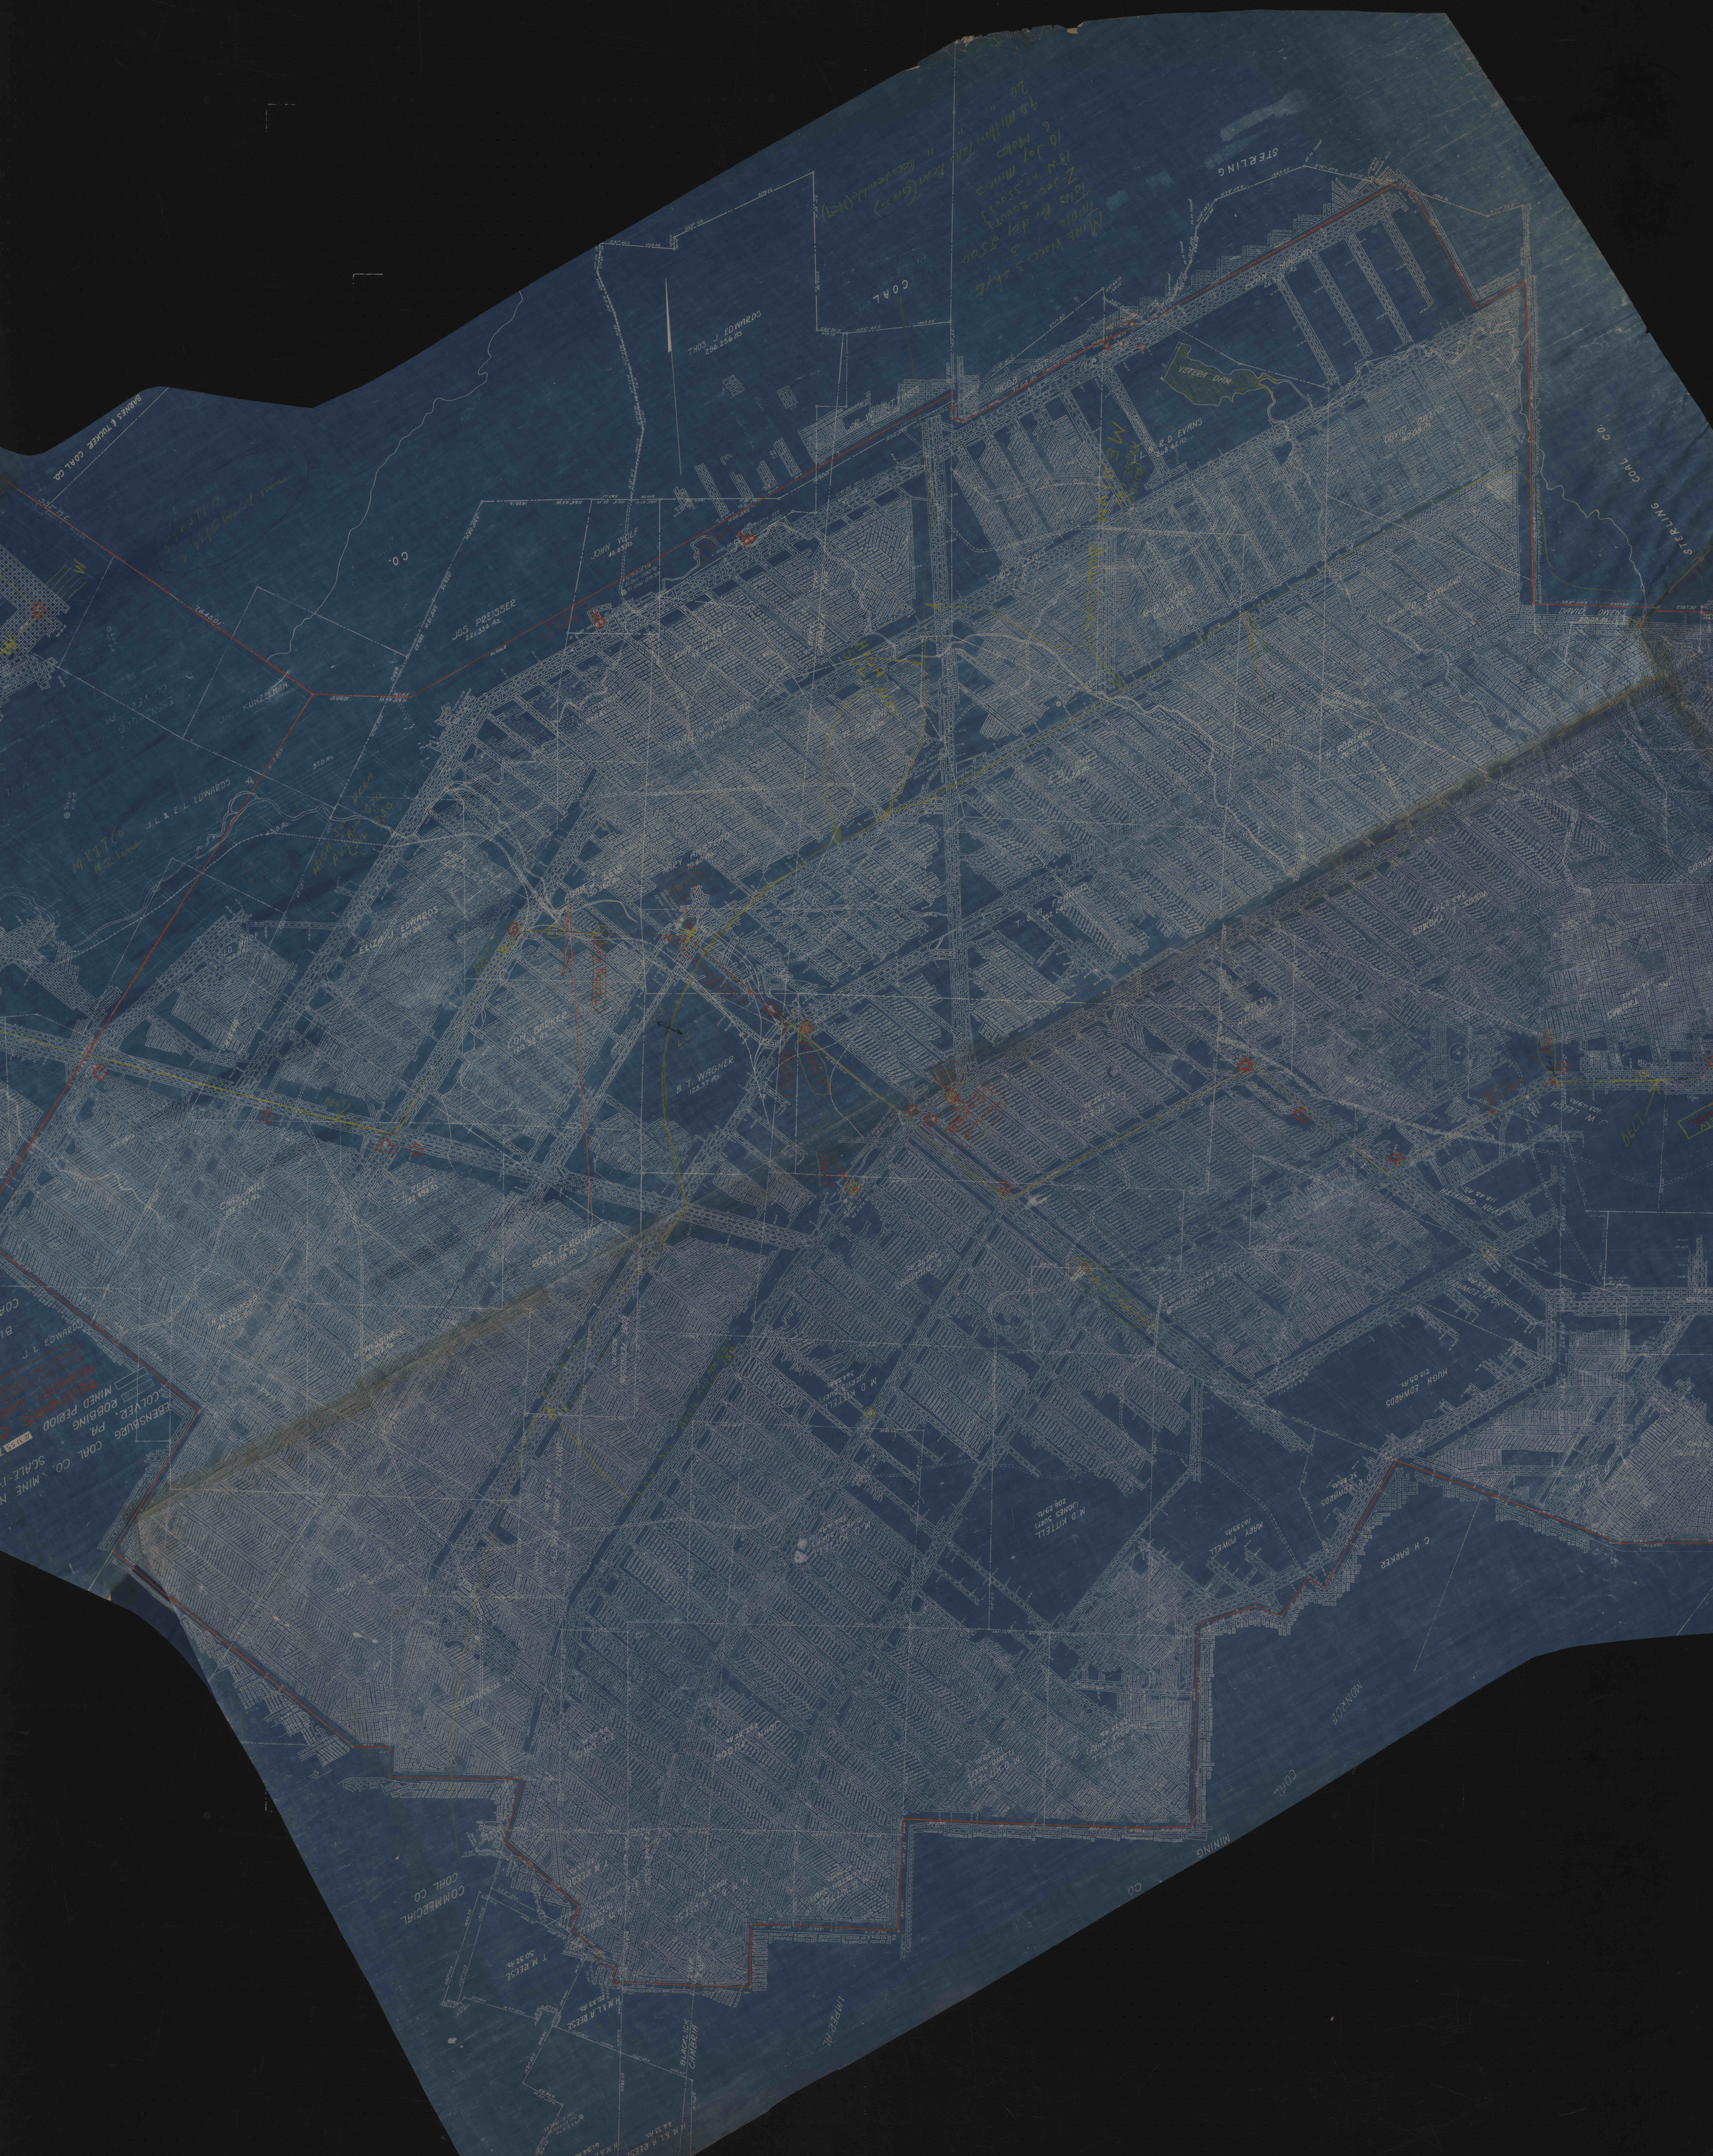
STERLING
COAL
THOS. J. EDWARDS
296.25 Ac.
VETERA DAM
DAVID OWENS
L. & R. D. EVANS
JOS. PREISSER
221.334 Ac.
JOHN WOLF
JNO. KUNZELMAN
J. L. & E. L. EDWARDS
ELIZA J. EDWARDS
LON. BARKER
120.38 Ac.
S. L. REED
POST FERGUSON
M. D. KITTELL
JONES SUCR.
MARY POWELL
HUGH EDWARDS
C. H. BARKER
COMMERCIAL COAL CO.
T. M. REESE
50.92 Ac.
H. M. & L. A. REESE
20.39 Ac.
H. M. & L. A. REESE
44.73 Ac.
H. M. & L. A. REESE
61.34 Ac.
BLACKLICK
CAMBRIA
MINING
MONROE
BARNES & TUCKER COAL CO.
MINED PEBOLD
ROBBING
COLVER, PA.
SCALE-
TRESPASS
PROPERTY LINE