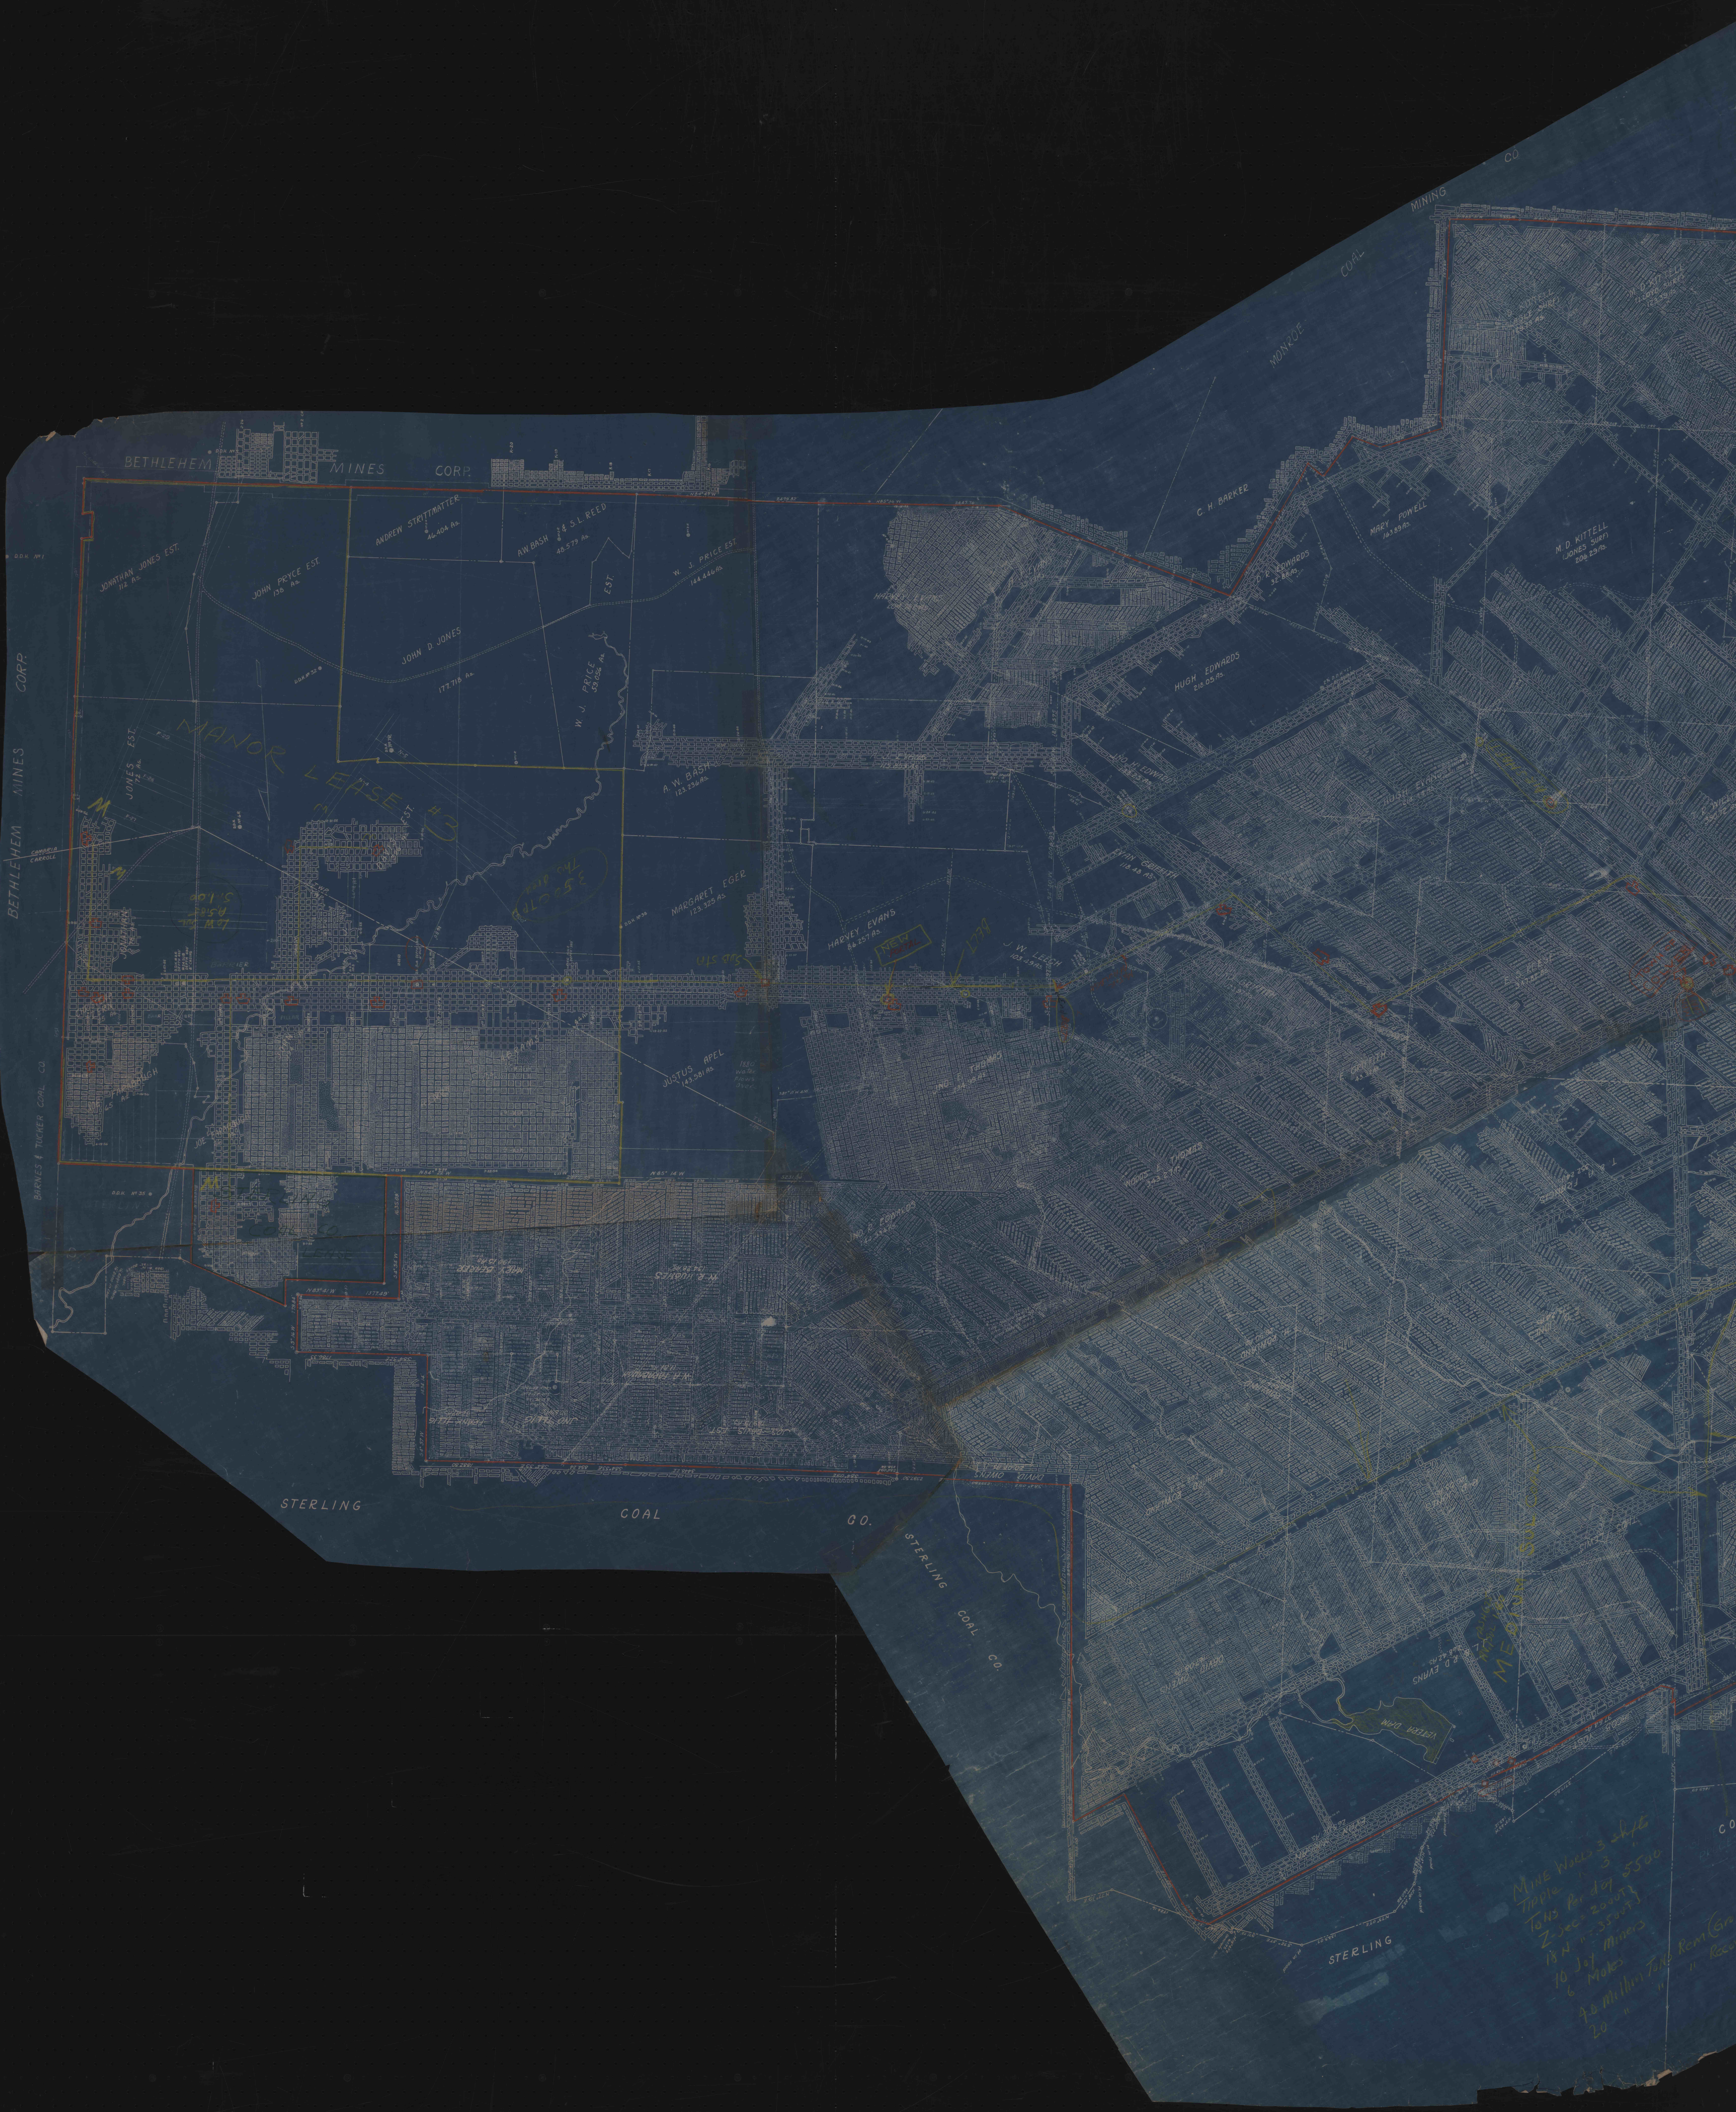
BETHLEHEM MINES CORP.
BETHLEHEM MINES CORP.
JONATHAN JONES EST. 112 As.
JOHN PRYCE EST. 138 As.
ANDREW STRITTMATTER 46.404 As.
A.W. BASH & S.L. REED 48.579 As.
W. J. PRICE EST. 144.446 As.
EST.
JOHN D. JONES 177.718 As.
W. J. PRICE 59.056 As.
A. W. BASH 123.236 As.
MARGARET EGER 123.325 As.
HARVEY EVANS 86.257 As.
J. W. LEECH 103.29 As.
JUSTUS APEL 143.581 As.
1880 Water Flows over
JONES EST. 72 As.
MANOR LEASE #3
CAMBRIA
CARROLL
BARRIER
Sub Sta
NEW
1798
BARNES & TUCKER COAL CO.
STERLING COAL CO. LEASE
MONROE COAL MINING CO
C. H. BARKER
D. R. EDWARDS 32.88 As.
MARY POWELL 163.89 As.
M. D. KITTELL (JONES SURF) 206.29 As.
HUGH EDWARDS 218.05 As.
JNO. H. EDWARDS
EVAN GRIFFITH 118.48 As.
HUGH EVANS
JNO. F. THOMAS
WOODS & THOMAS
JNO. R. EDWARDS
DAVID OWENS
R. D. EVANS
VETERA DAM
MEDIUM SUL COAL
STERLING COAL CO.
STERLING COAL CO.
STERLING
Mine Works 3 shift
Tipple " 3 "
Tons Per day 5500
Z-Sec 200UT
18N " 350UT
10 Joy Miners
6 Moles
40 Million Tons Rem (Gr
20 " " Rec