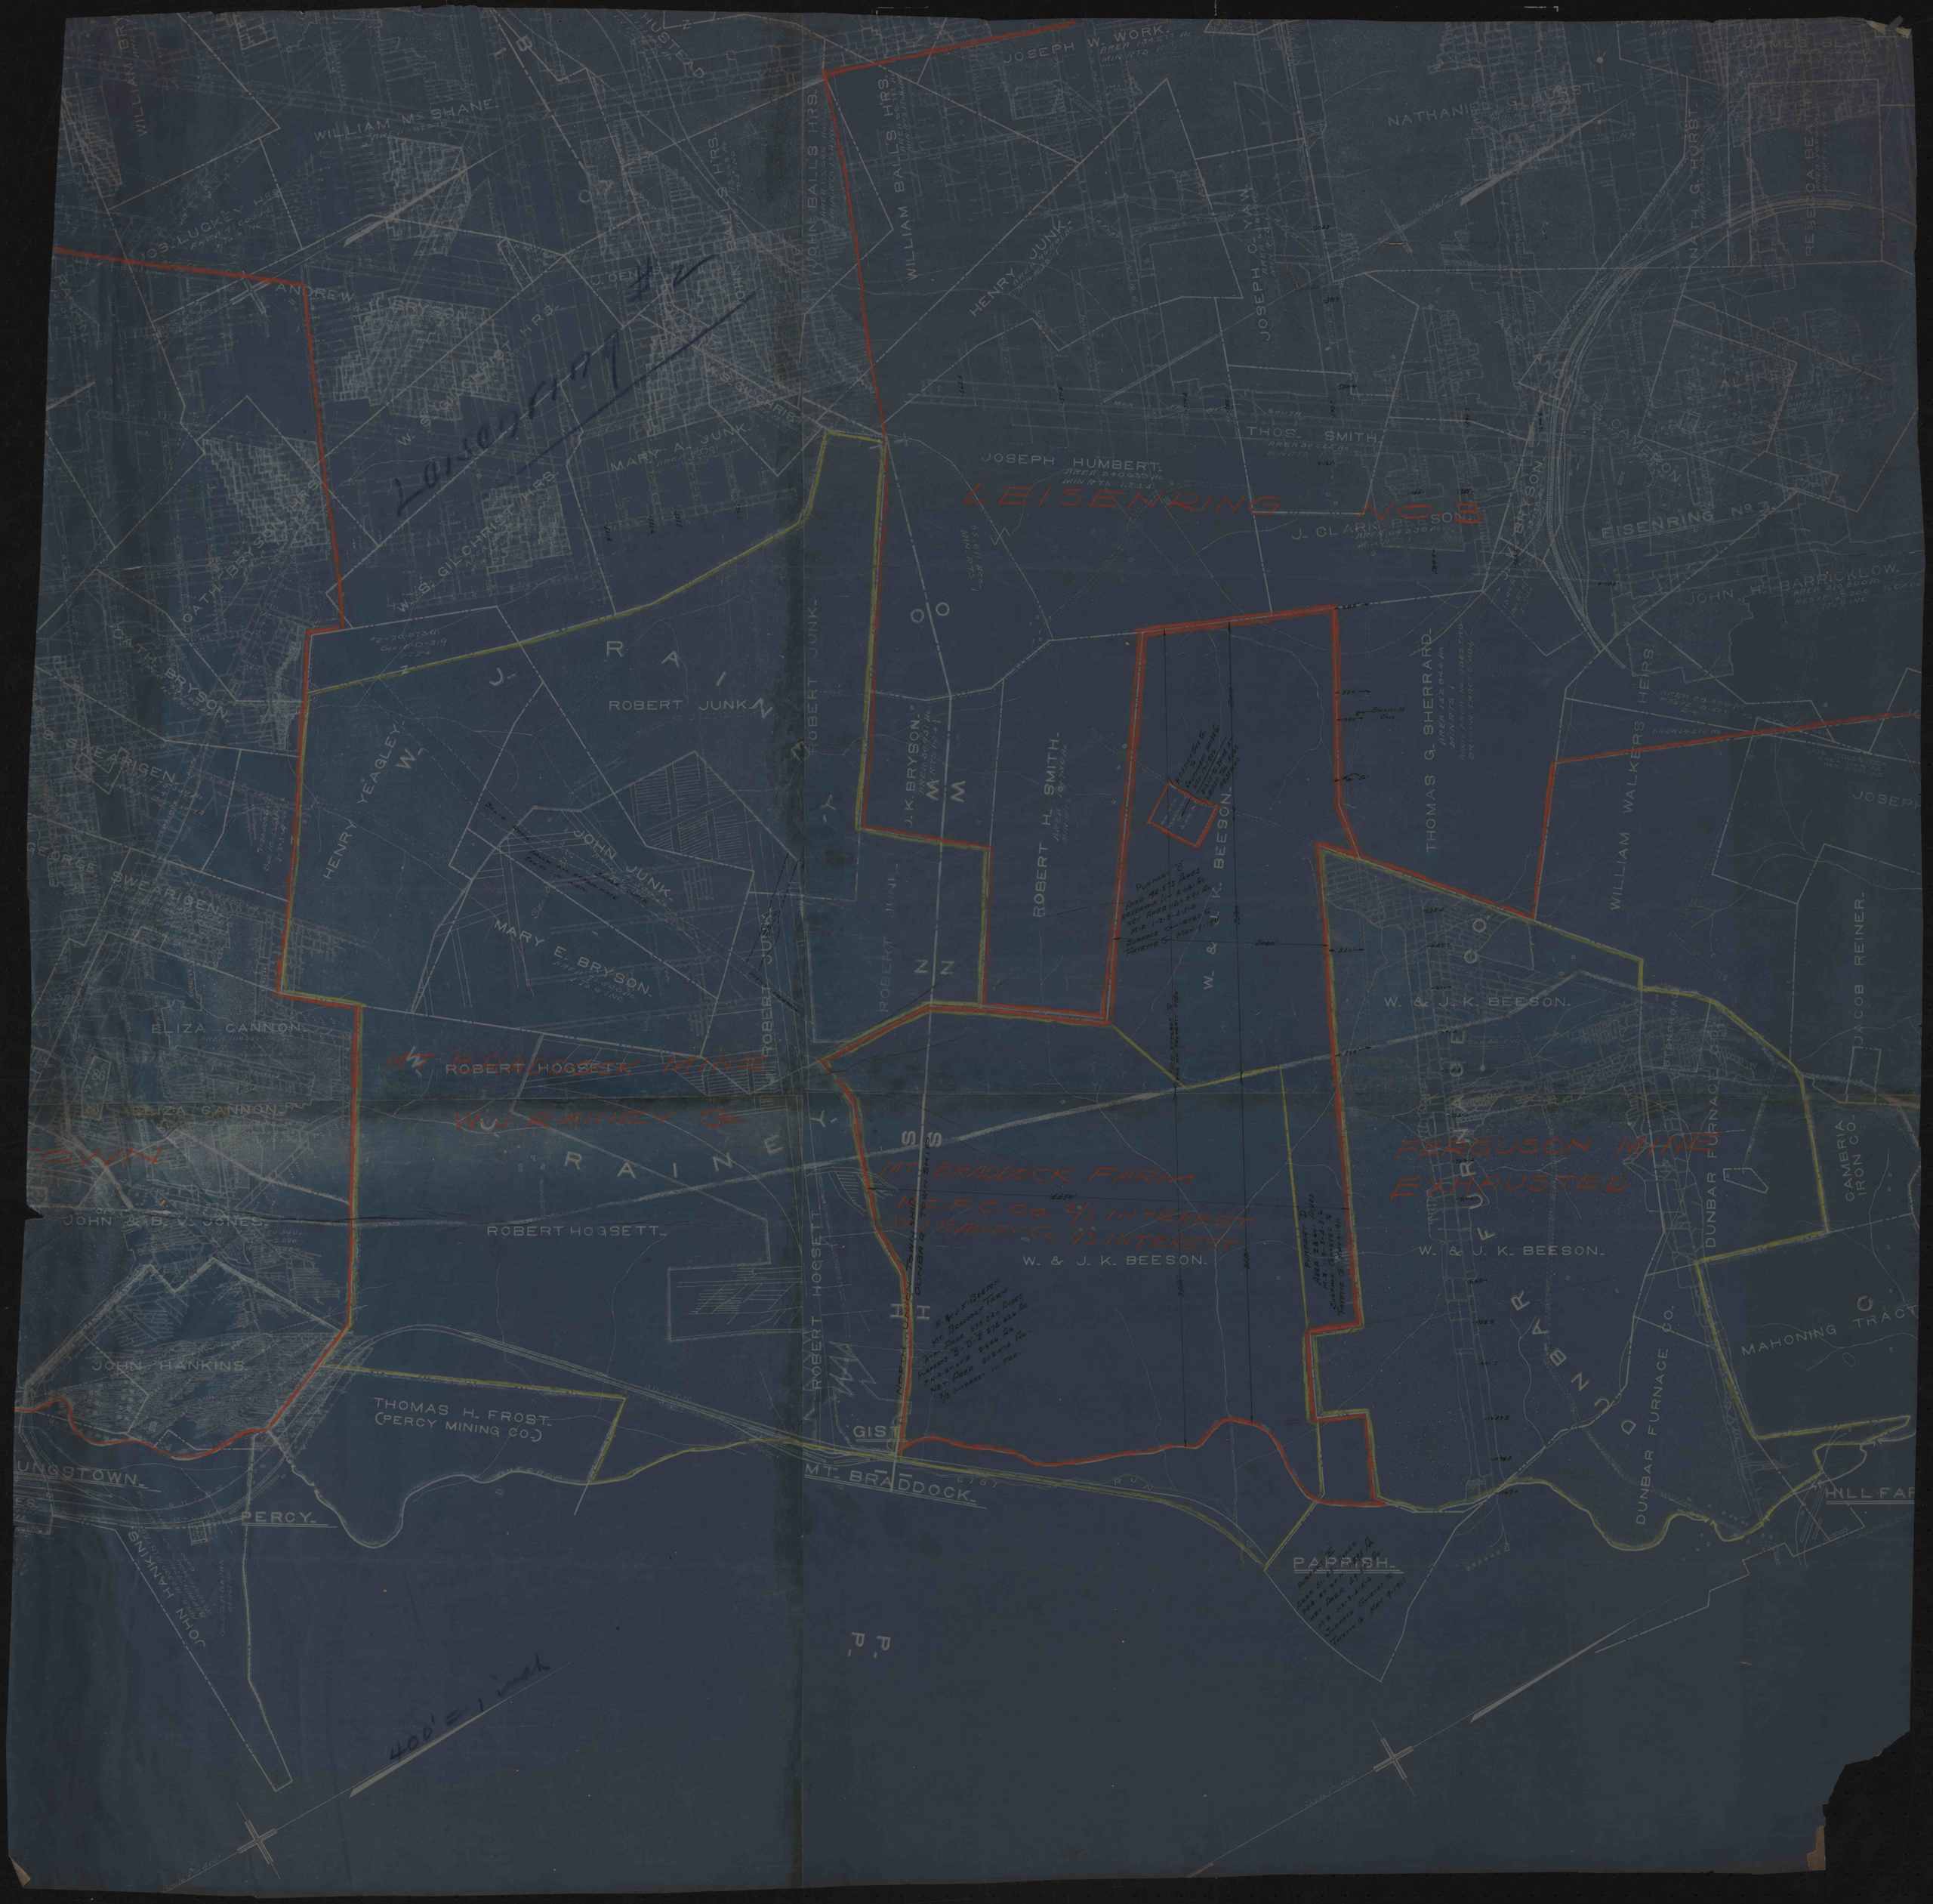

LEISENRING No 3
LEISENRING No 3
MT. BRADDOCK MINE
W. RAINEY CO.
MT. BRADDOCK FARM
P.C. F.C. CO. 2/3 INTEREST
W. RAINEY CO. 1/3 INTEREST
FERGUSON MINE
EXHAUSTED
JOSEPH W. WORK
WILLIAM McSHANE
JOS. LUCKEY HRS.
ANDREW J. BRYSON
WILLIAM BALLS HRS.
HENRY JUNK
JOSEPH C. YAW
NATHANIEL G. HURST
NATH. G. HURST
REBECCA BEATTY
JOSEPH HUMBERT
THOS. SMITH
J. CLARK BEESON
LEISENRING No 3
JOHN H. BARRICKLOW
MARY A. JUNK
W. S. GILCHRIST HRS.
CATH. BRYSON
CATH. BRYSON
ROBERT JUNK
HENRY YEAGLEY
JOHN JUNK
MARY E. BRYSON
J. K. BRYSON
ROBERT H. SMITH
W. & J. K. BEESON
THOMAS G. SHERRARD
WILLIAM WALKERS HEIRS
GEORGE SWEARIGEN
ELIZA CANNON
ROBERT HOGSETT
JOHN & B. V. JONES
JOHN HANKINS
THOMAS H. FROST
(PERCY MINING CO.)
MT. BRADDOCK
PERCY
PARRISH
DUNBAR FURNACE CO.
MAHONING TRACT
CAMBRIA IRON CO.
400' = 1 inch