


ENOCH WALSH WAR.

CAMBRIA IRON COMPANY
MINERAL

SEAM CABLEMINE
UPPER KITTANNING
OUTCROP OF THE "C" SEAM

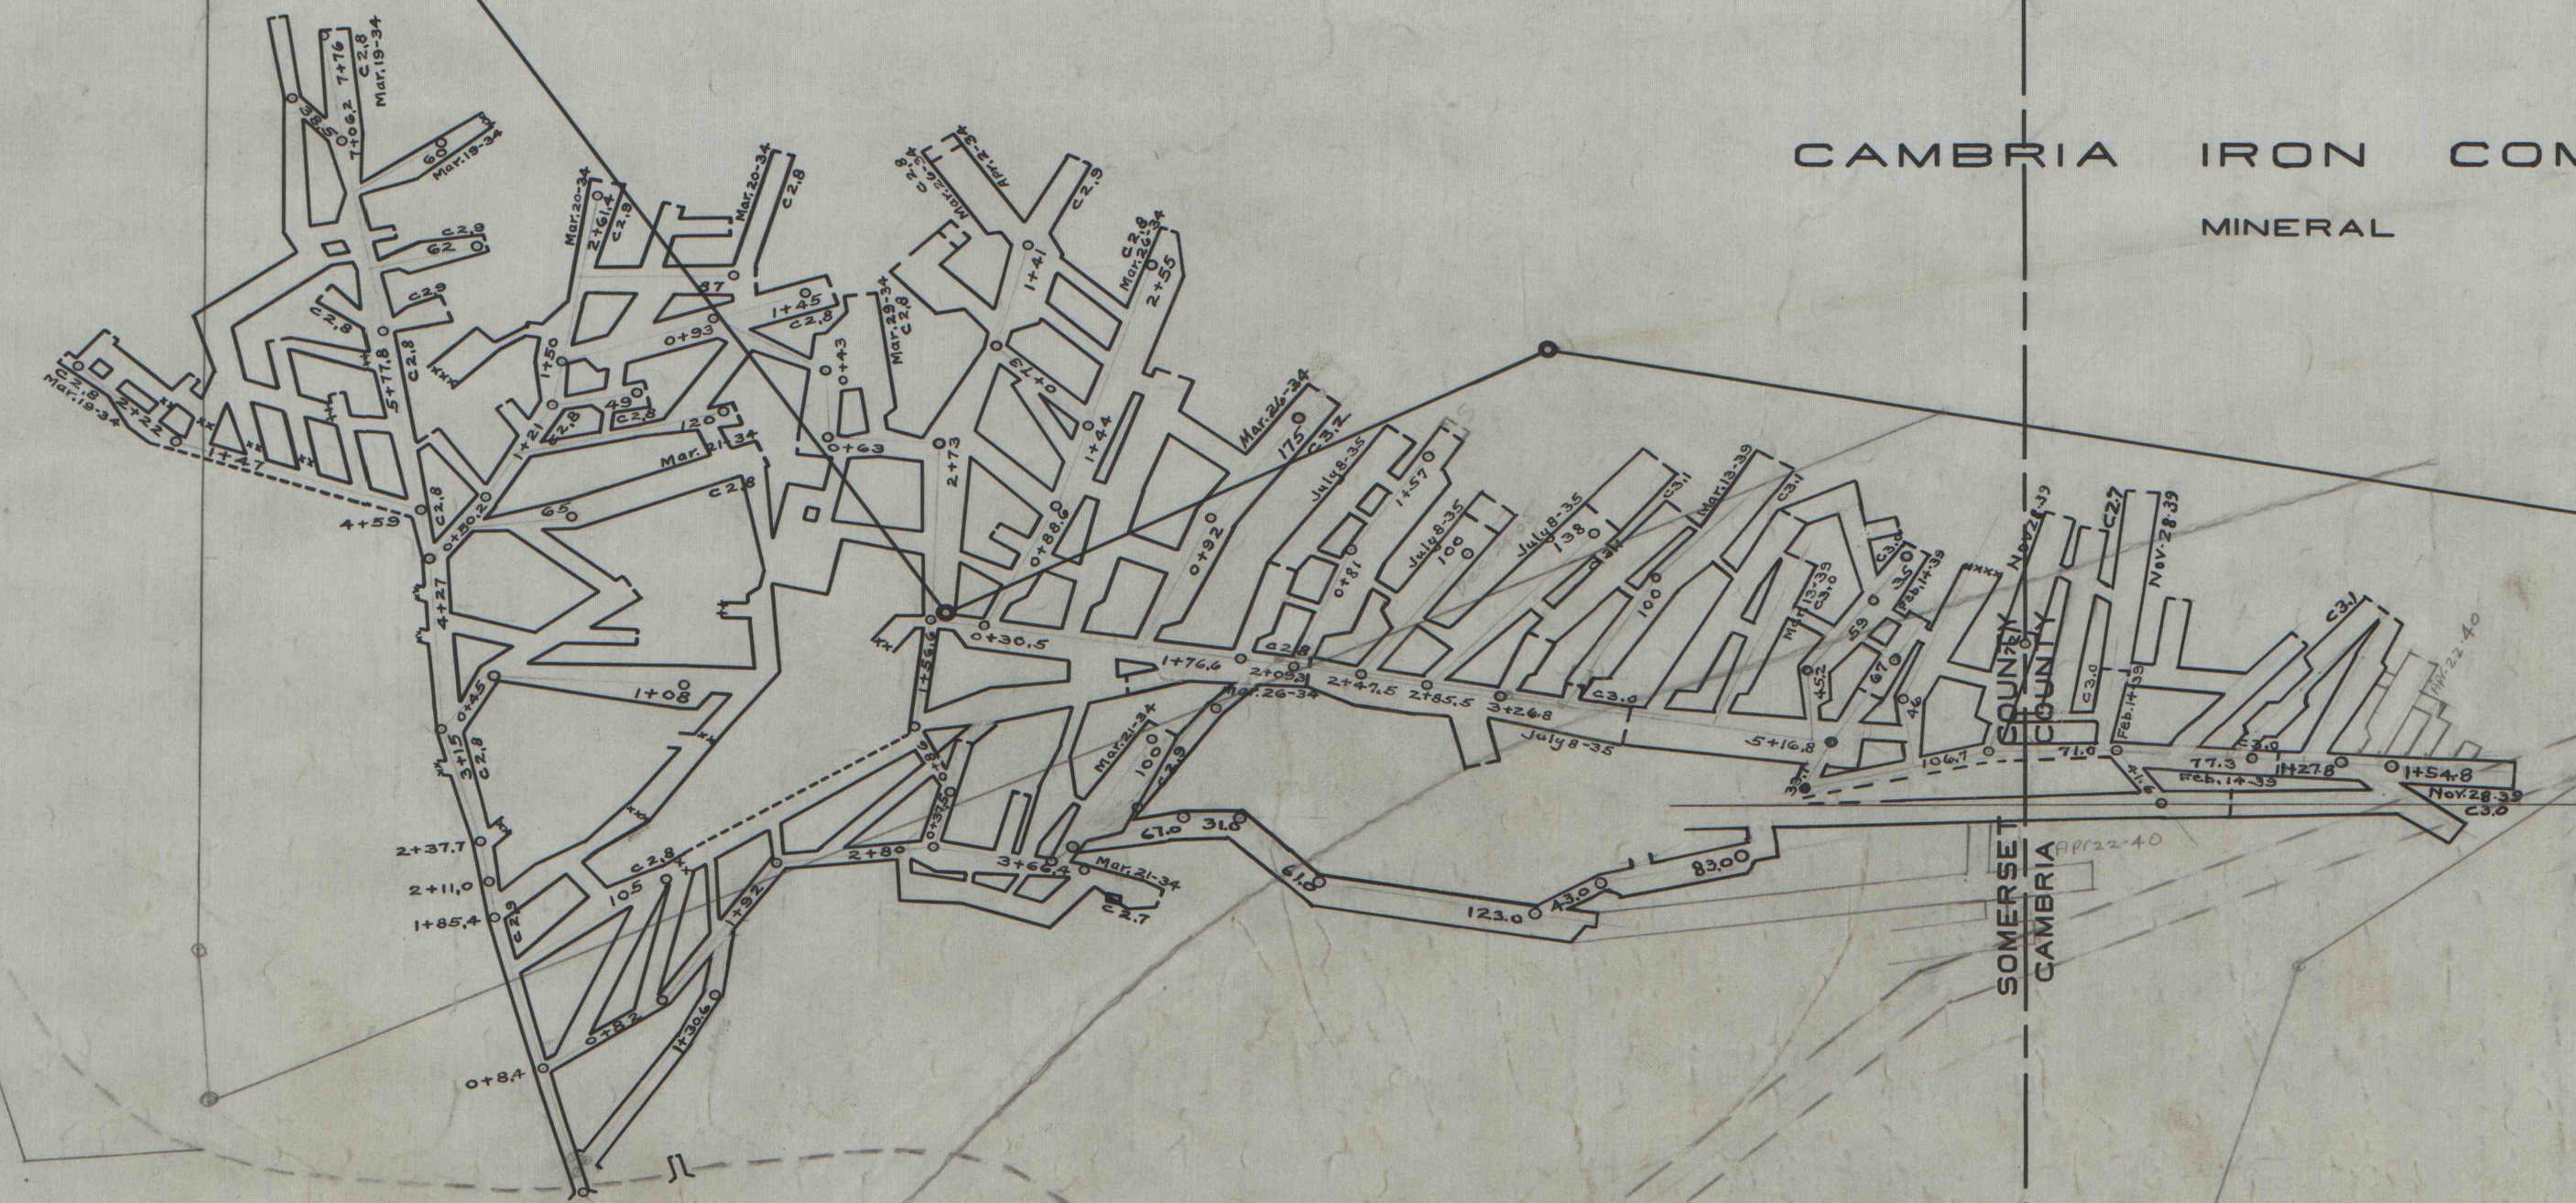

MAP OF WATSON MINE
"C" SEAM
SITUATE
CONEMAUGH TOWNSHIP, SOMERSET COUNTY,
PENNA.
SCALE 1"=100'
APRIL 6, 1934

52-A-272

D-9