


THOMAS DAVIS WAR.

CAMBRIA IRON CO.  
FEE

CHRISTOPHER LONG WAR.  
COLONIAL IRON CO.  
MINERAL

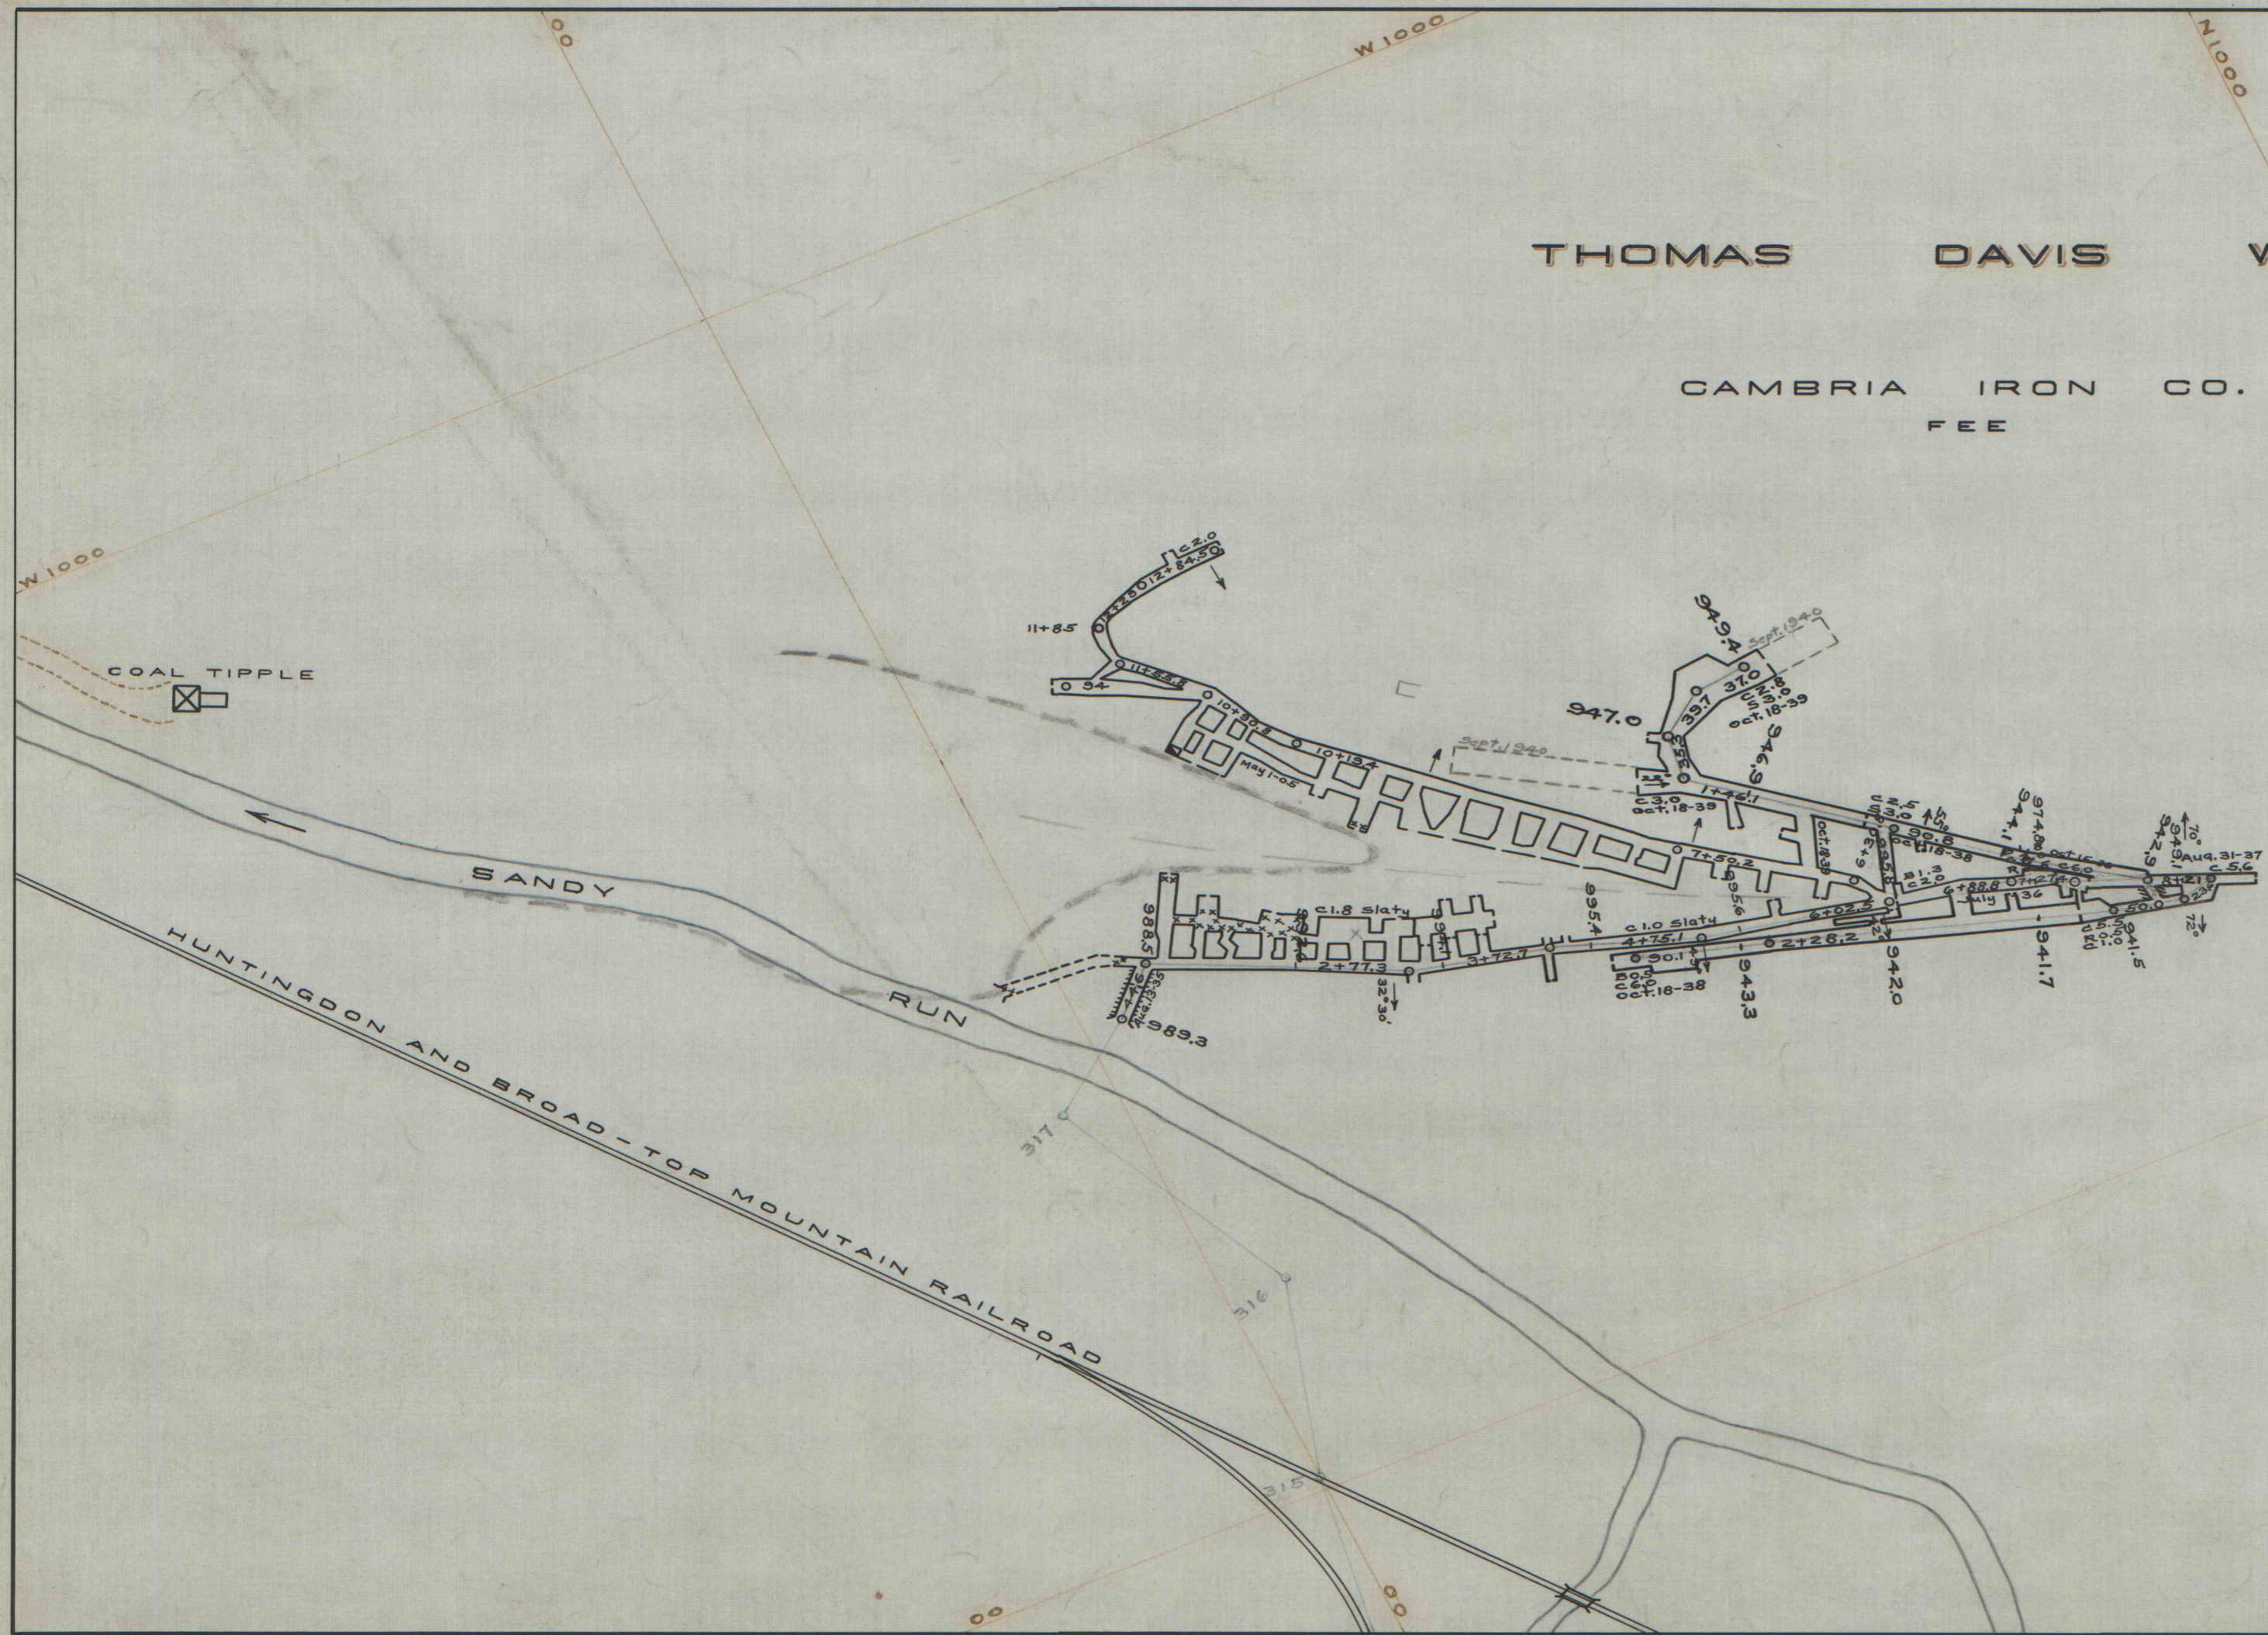

INDUSTRIAL COLLIERIES CORP.  
 MAP OF  
 DODSON MINE  
 BARNETT SEAM  
 BROAD-TOP TOWNSHIP  
 BEDFORD COUNTY PENNA.  
 SCALE 1"=100' JULY 3, 1936

52-A-293

D-9