


CAMBRIA MINING & MANUFACTURING COMPANY

CAMBRIA MINING & MANUFACTURING COMPANY  
"D" SEAM MINES ON PROPERTY  
SUMMERHILL & PORTAGE TWP'S  
CAMBRIA CO. - PENNA.  
APRIL - 1953

SCALE

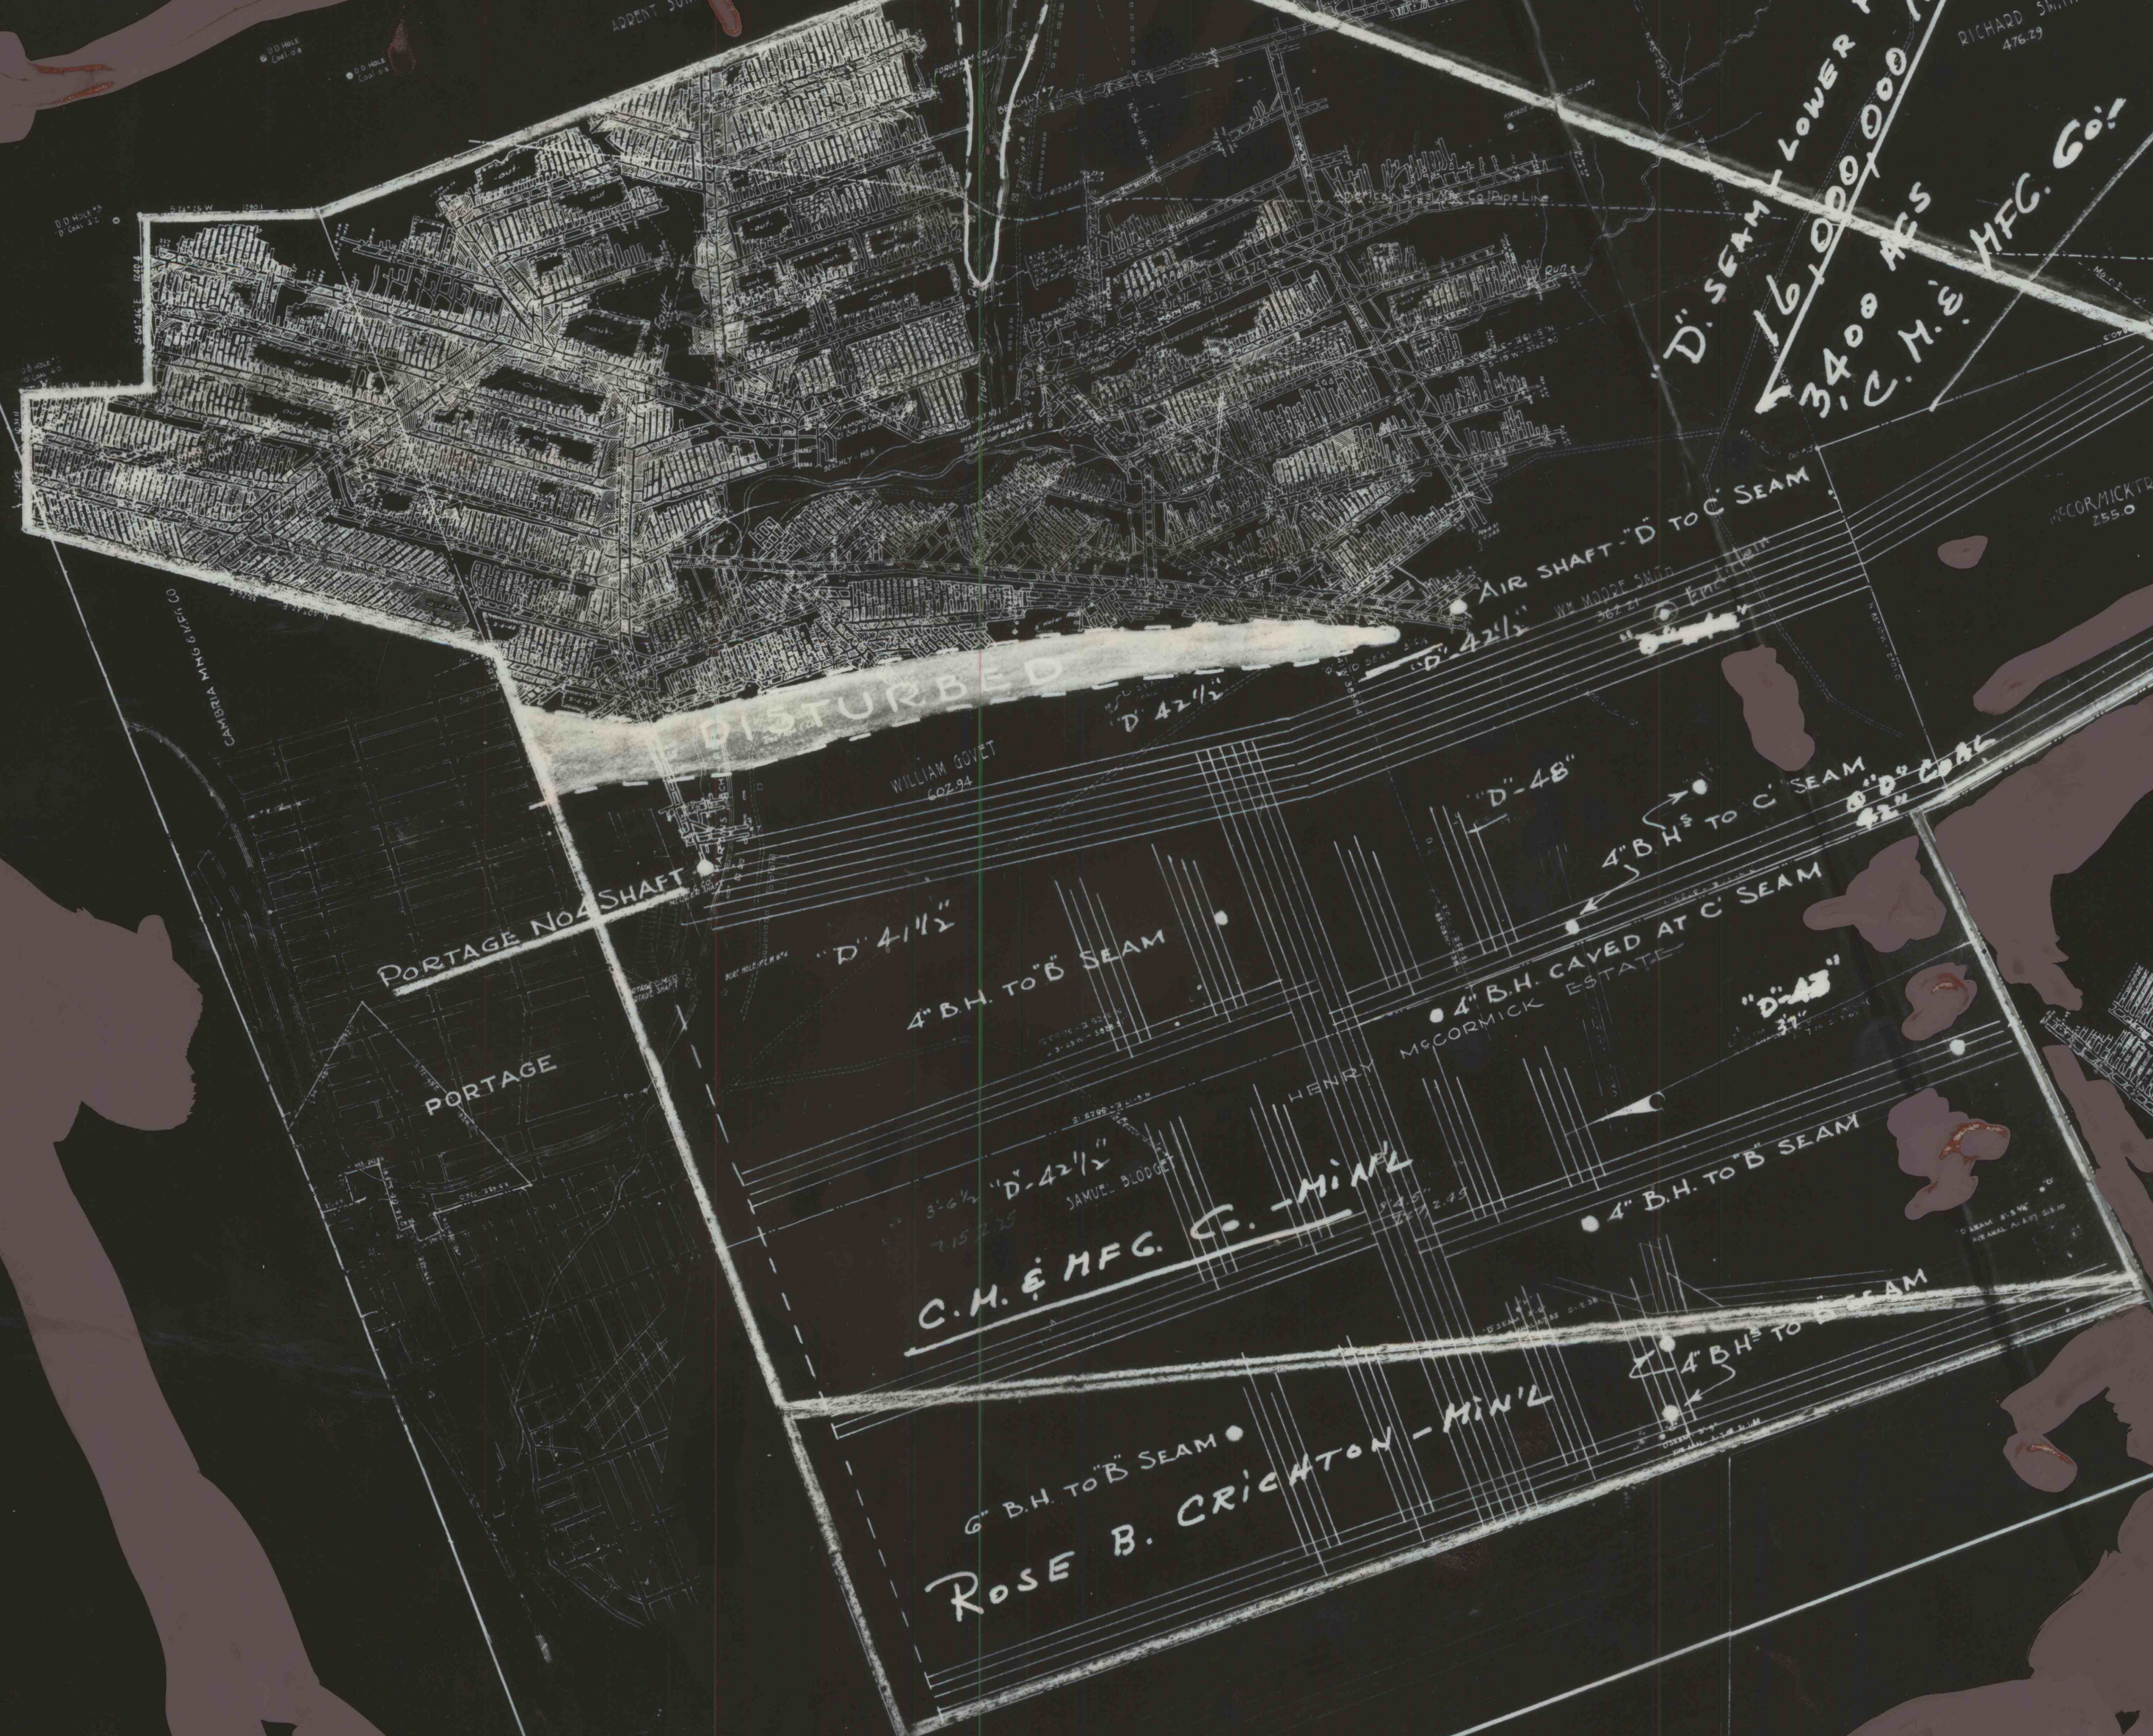

CA HUGHES & CO  
OUTCROP  
ACTIVE STRIPPING  
COAL - 40"

