


| OWNER | VALUATION      | SHEET | REAL ESTATE |
|-------|----------------|-------|-------------|
| 500   | 8019 6000 0001 | 5     | 5           |

(S 2367 0.0 TO 1.0)

|                                |                                     |
|--------------------------------|-------------------------------------|
| All Property to Con Rail       | <input checked="" type="checkbox"/> |
| Partial Conveyance to Con Rail | <input type="checkbox"/>            |
| No Property to Con Rail        | <input type="checkbox"/>            |
| IN                             | DATE                                |
| QD                             | 1/7/70                              |
| CAPTION:                       |                                     |
| Area to Con Rail 9.0 ± Ac      |                                     |

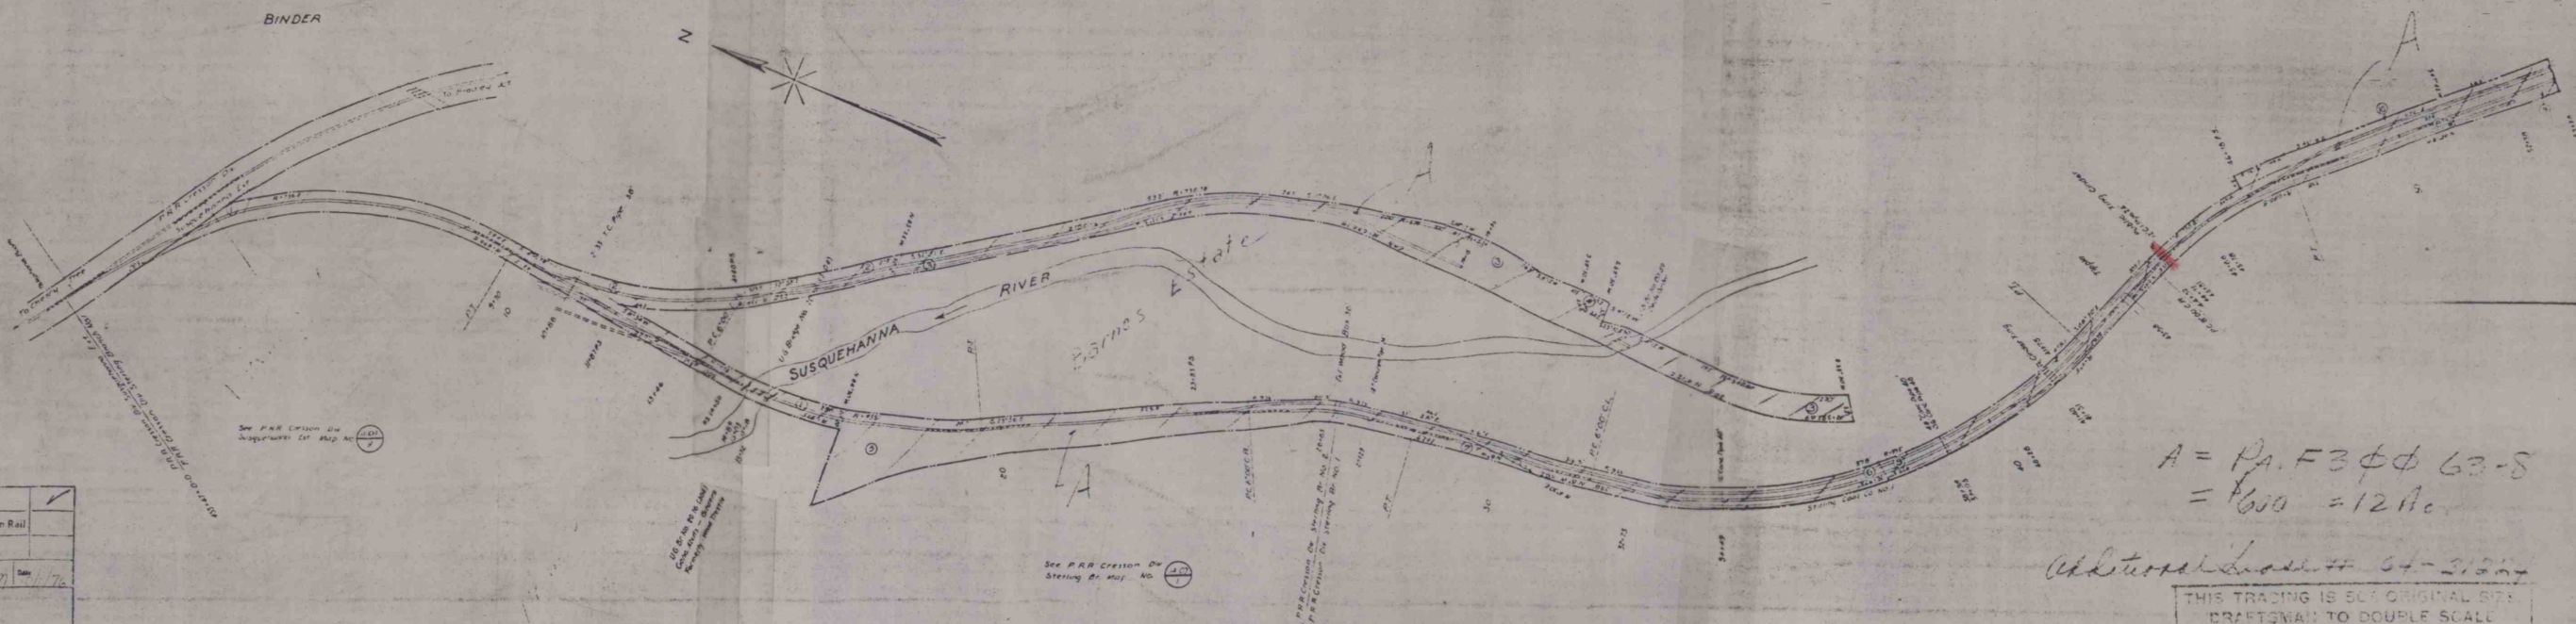

A = PA. F3 φ φ 63-8  
= 1600 = 12 Ac

Additional Land 64-2100

THIS TRACING IS 50% ORIGINAL SIZE  
CRAFTSMAN TO DOUBLE SCALE

EASTERN PENNA. DIV. CRESSON DIV.

|                                             |                                             |
|---------------------------------------------|---------------------------------------------|
| Current as of Dec. 31st, 1968, No. Revision | Current as of Dec. 31st, 1968, No. Revision |
1"=200'

Atlas NO. 103 P. map pp. 15-16