OWNER	VALUATION SECTION	SUB DIV.	SHEET NUMBER	REAL ESTATE REGION
500	8024	1100	0001	5

(S 2146 0.0 TO 1.0)

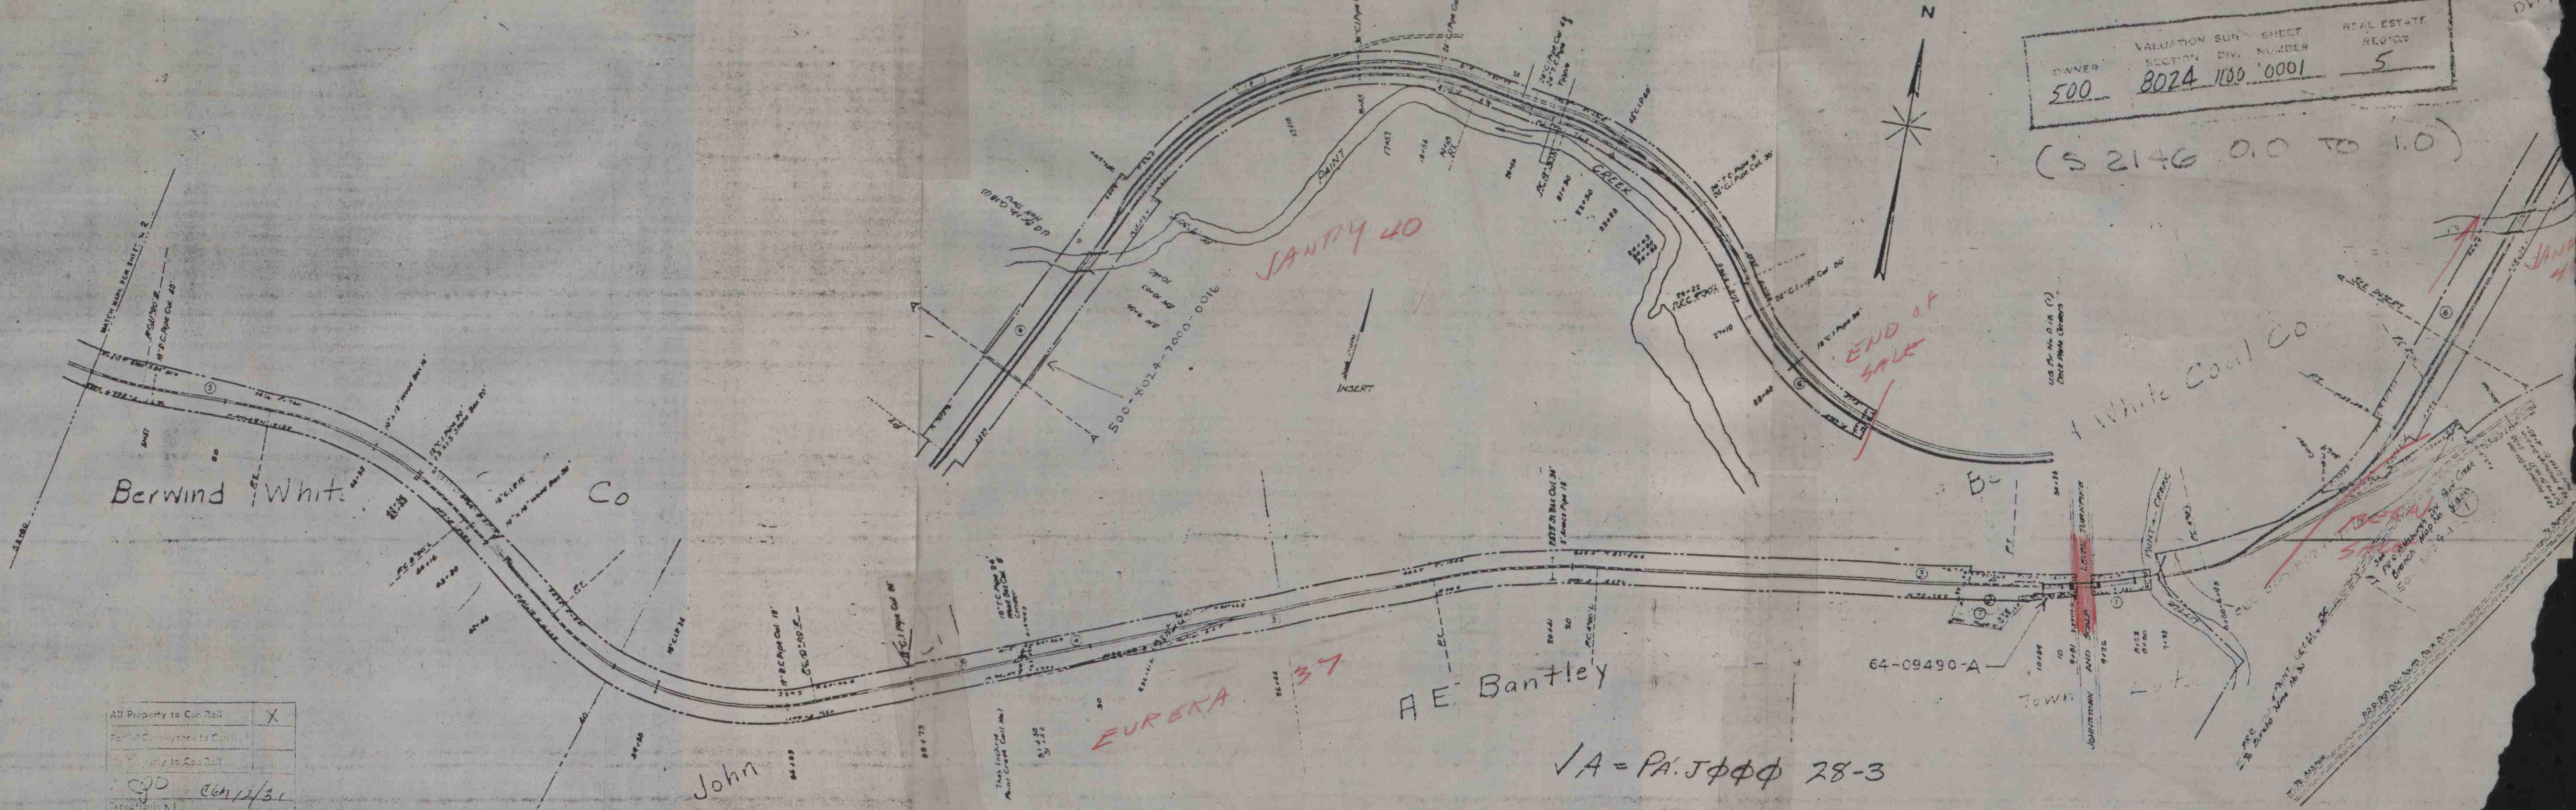

√A = PA. J000 28-3

All Property to Con Rail	X
Partial Conveyance to Con Rail	
No Property to Con Rail	

GJO CGH 12/31

Exceptions: None

Area to Con Rail: 11.4 ± Ac

CORRECT AS OF DEC 31	REVISED YES	REVISED NO
[illegible]		
[illegible]	✓	
[illegible]		
[illegible]		
[illegible]		
[illegible]		X
[illegible]		
[illegible]		
[illegible]		✓
1959		✓
1957		
1956		✓

Correct as of Dec. 31st, 1955- No Revision
Correct as of Dec. 31st, 1954- No Revision
Correct as of Dec. 31st, 1953- No Revision
Correct as of Dec. 31st, 1952- No Revision
Correct as of Dec. 31st, 1951- No Revision
Correct as of Dec. 31st, 1950- No Revision
Correct as of Dec. 31st, 1949- Map Revised
Correct as of Dec. 31st, 1948- No Revision
Correct as of Dec. 31st, 1947- No Revision
Correct as of Dec. 31st, 1946- No Revision
Correct as of Dec. 31st, 1945- No Revision
Correct as of Dec. 31st, 1944- No Revision
Correct as of Dec. 31st, 1943- No Revision

Correct as of Dec. 31st, 1942- No Revision
Correct as of Dec. 31st, 1941- No Revision
Correct as of Dec. 31st, 1940- Map Revised
Correct as of Dec. 31st, 1939- No Revision
Correct as of Dec. 31st, 1938- Map Revised
Correct as of Dec. 31st, 1937- No Revision
Correct as of Dec. 31st, 1936- No Revision
Correct as of Dec. 31st, 1935- Map Revised
Correct as of Dec. 31st, 1934- No Revision
Correct as of Dec. 31st, 1933- No Revision
Correct as of Dec. 31st, 1932- No Revision
Correct as of Dec. 31st, 1931- No Revision
Correct as of Dec. 31st, 1930- No Revision

Correct as of Dec 31st 1979 No Revision
Correct as of Dec 31st 1978 Map Revised
Correct as of Dec 31st 1977 Map Revised
Correct as of June 30th [illegible] No Revision
Correct as of June 30th [illegible] No Revision
Correct as of June 30th [illegible] No Revision
Correct as of June 30th [illegible] No Revision
Correct as of June 30th [illegible] No Revision
Correct as of June 30th [illegible] Map Revised
Correct as of June 30th [illegible] No Revision
Correct as of June 30th [illegible] No Revision
Correct as of June 30th [illegible] No Revision

NOTE
STATION 0+00 ON THIS MAP EQUALS STATION [illegible]
[illegible] MAP NO. 1 [illegible]

CORRECT:

[illegible]

1" = 200'

THIS TRACING IS [illegible] ORIG
DRAFTSMAN TO DO

WESTERN PENNA. DIV.

RIGHT OF WAY AND T

PENNSYLVANIA R

EUREKA BRANC

STATION 0+00 TO STAT

SCALE

OFFICE OF VALUATION ENG
PHILADELPHIA, PA

Scalp Level Boro Cambria Co., PA

Drawer No. 70 B. Map No. 1 & 2 - also Drawer No 70 - Map 27