


(S 2147 0.0 TO 1.0)

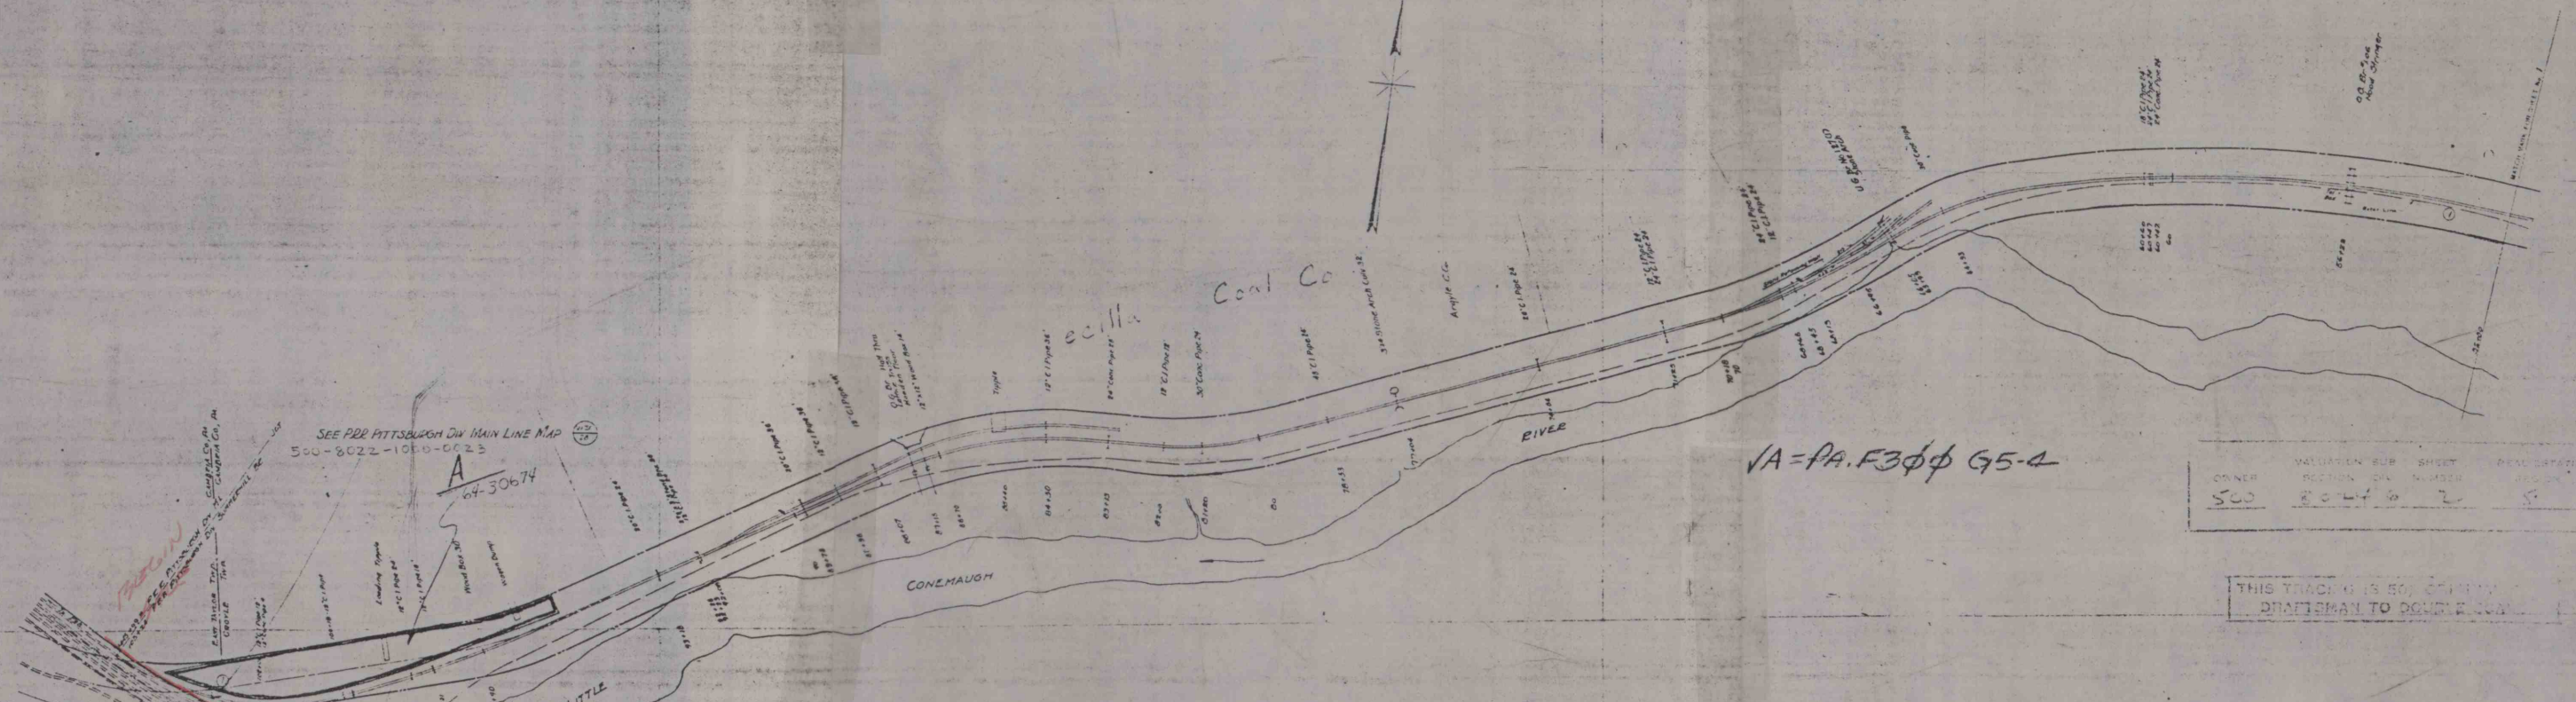

SEE P22 PITTSBURGH DIV MAIN LINE MAP
500-8022-1000-0023

A 64-30674

VA=PA.F3φφ G5-4

OWNER	VALUATION	SUB	SHEET	SECTION	CH	NUMBER	DEAL	DATE
500	2004	0	2	5				

THIS TRACK IS SO OF THE
DRAFTERMAN TO DOUBLE

ALL Property to Con Rail	X
Partial Conveyance to Con Rail	
No Property to Con Rail	
EXC	000 - 06/17/2/31
EXC	None
Area to Con Rail	13.5+ AC

Correct as of Dec 31st, 1952 No Revision	Correct as of Dec 31st, 1952 No Revision	Correct as of Dec 31st, 1952 No Revision

WESTERN PENNA. DIV. PITTSBURGH DIV.

RIGHT OF WAY AND TRACK MAP
PENNSYLVANIA RAILROAD
SUMMERHILL BRANCH
STATION 52+00 TO STATION 40+00

1"=200'

