


(S 2144 1.0 TO 2.0)

OWNER	VALUATION	SUBJECT	REAL ESTATE
523	8000	2	

2144

THIS TRACKING IS FOR ONE TRACK
DRAFTSMAN TO DOUBLE

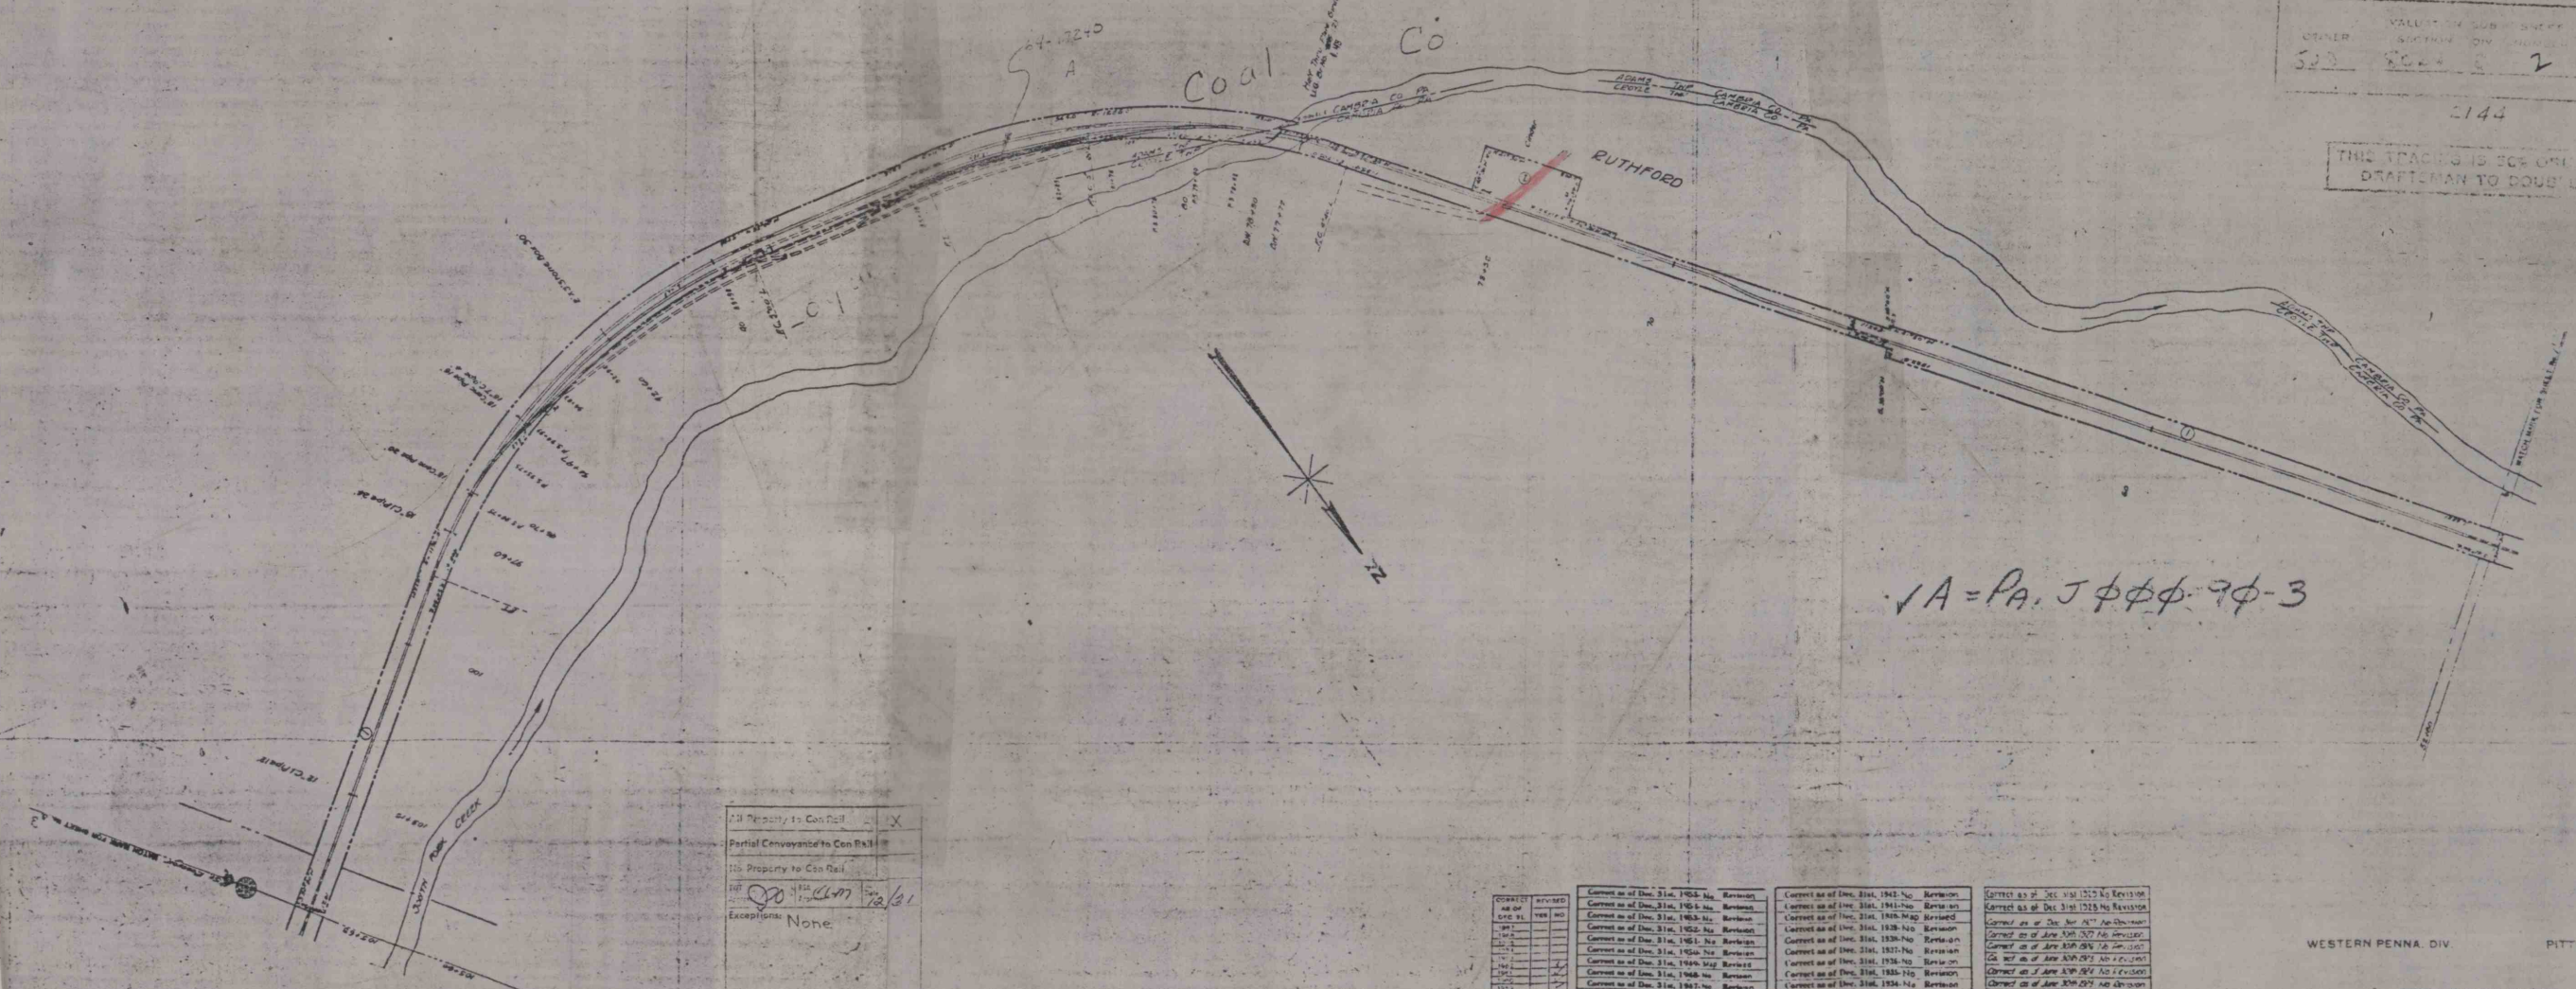

1A = PA. J φ φ φ 7 φ - 3

All Property to Con Rail	X
Partial Conveyance to Con Rail	
No Property to Con Rail	
Exceptions	None

DATE	REVISION	DESCRIPTION

WESTERN PENNA. DIV. PITTSBURGH DIV.

RIGHT OF WAY AND TRACK MAP
PENNSYLVANIA RAILROAD
BEAVER BRANCH
STATION 21100 TO STATION 20140
SCALE 1" = 200'

