


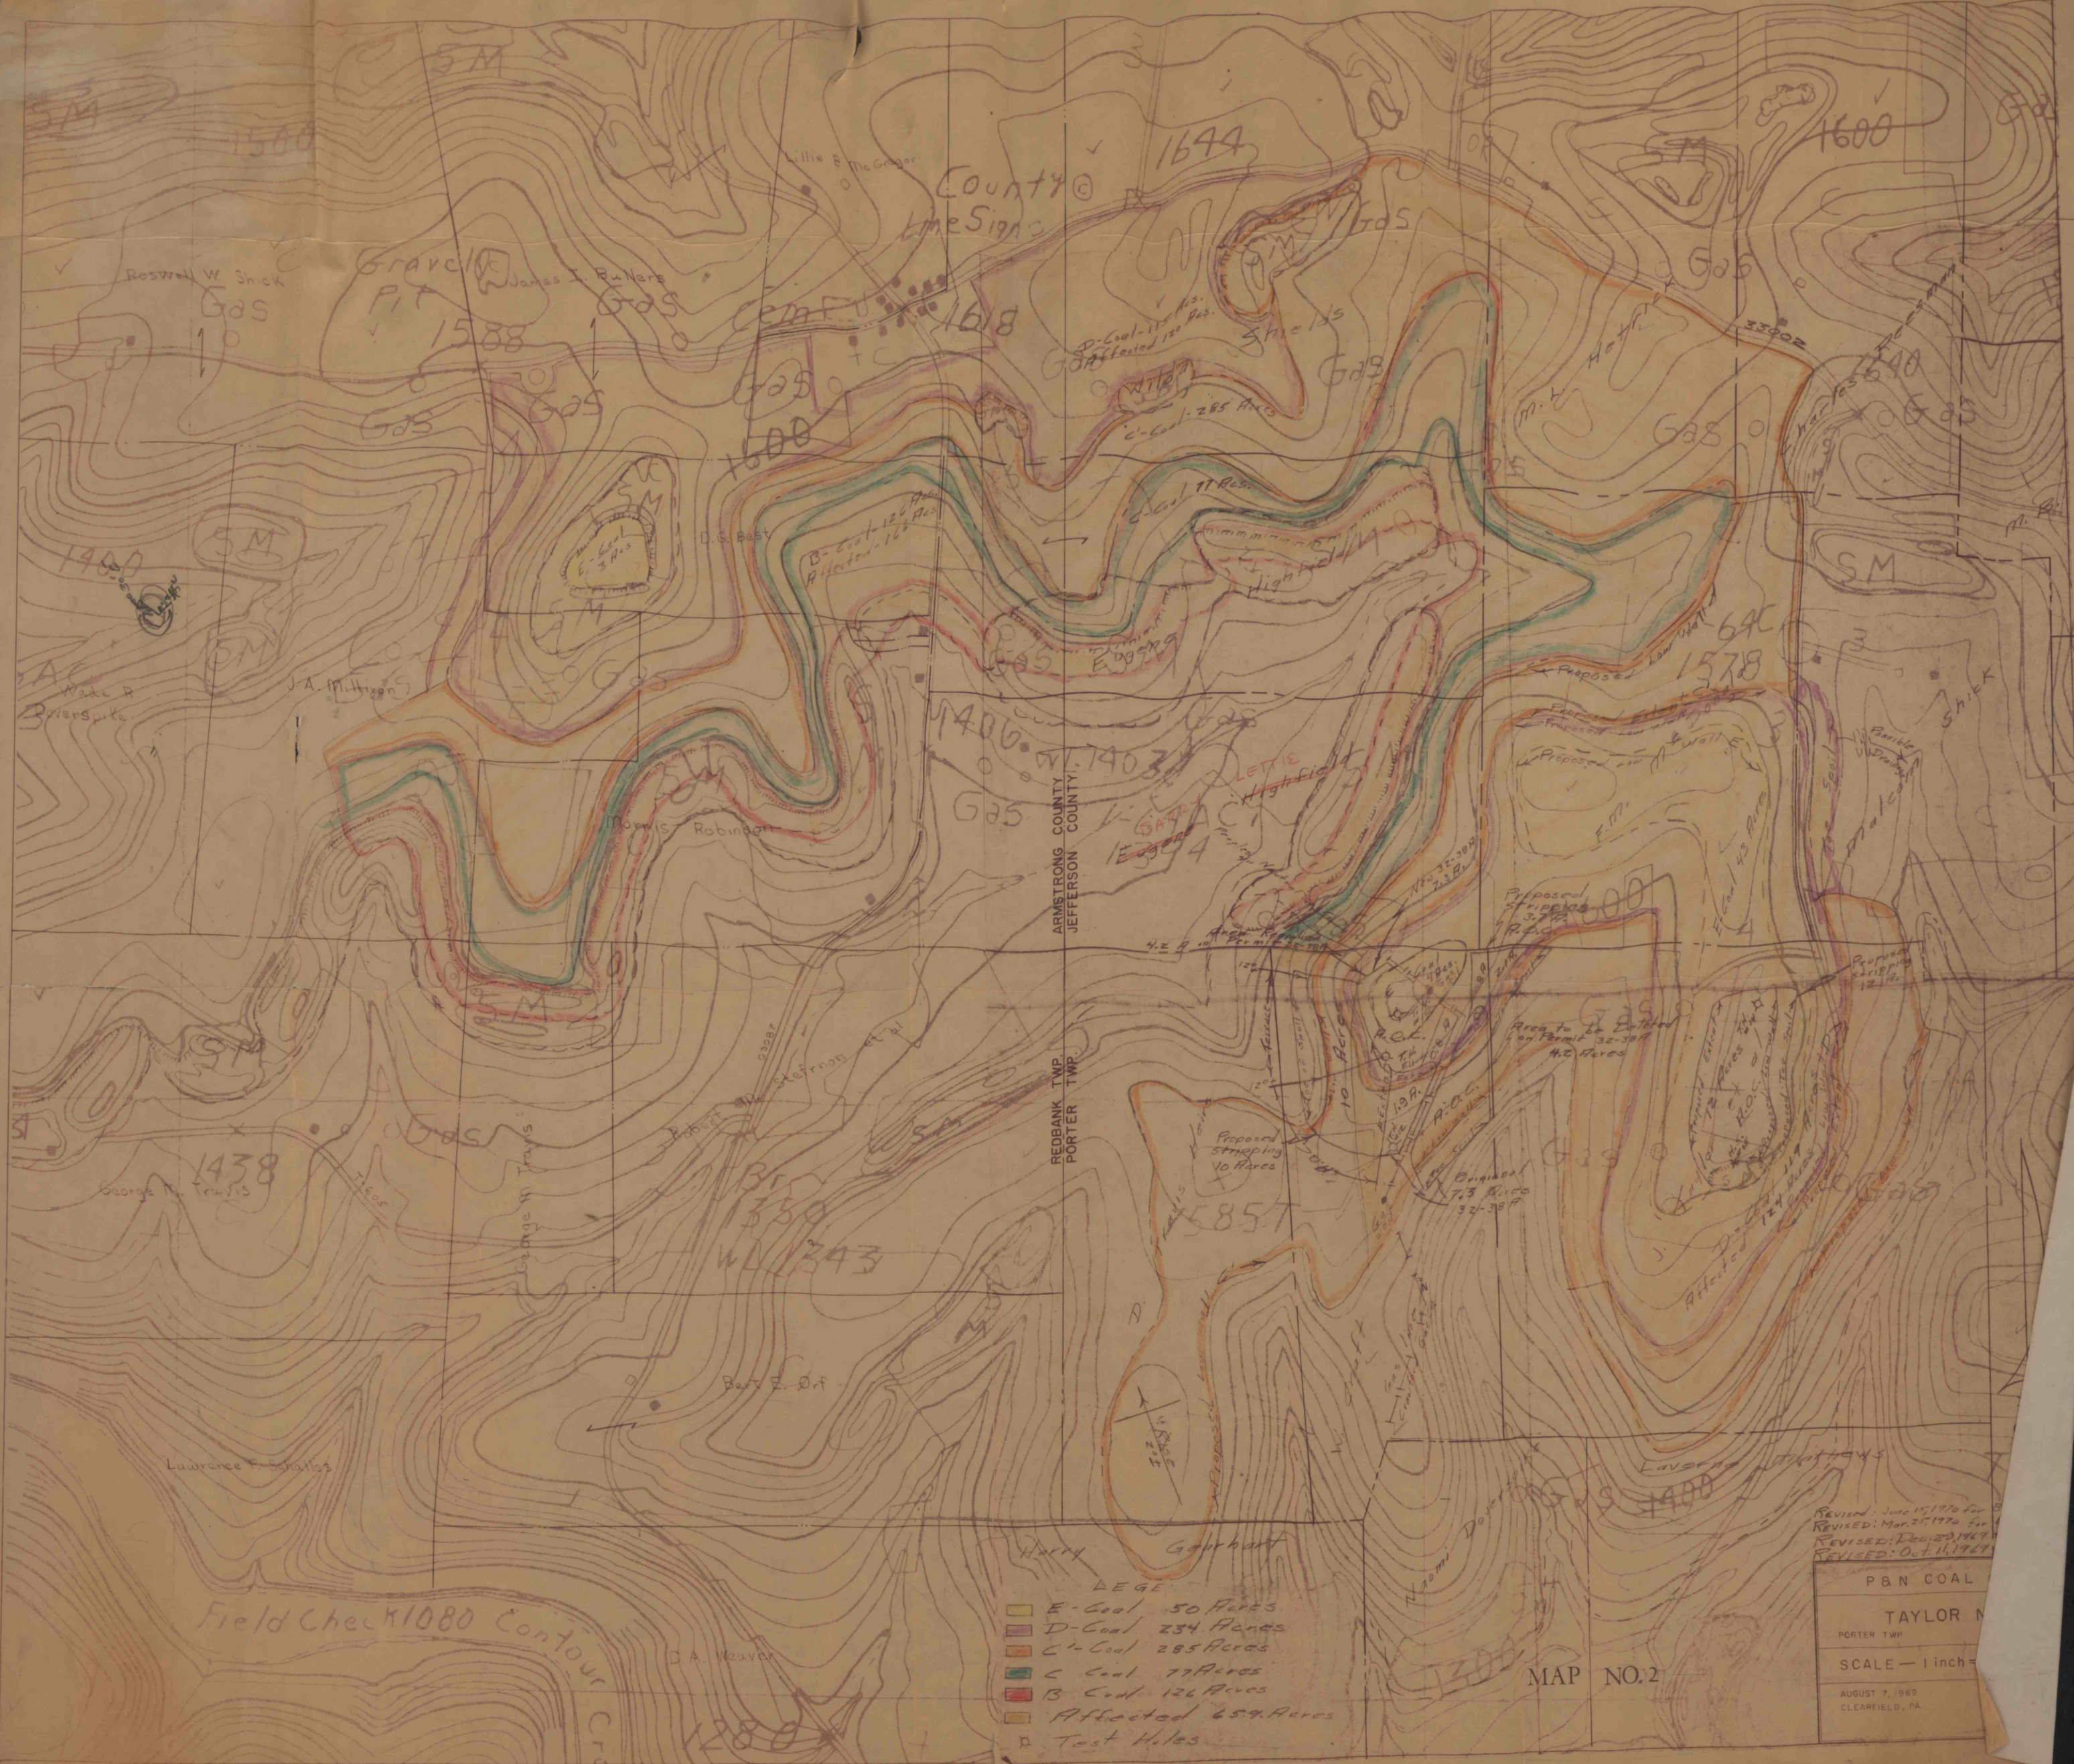

County 40
Line Signs

ARMSTRONG COUNTY
JEFFERSON COUNTY

REDBANK TWP.
PORTER TWP.

- LEG
- E-Coal 50 Acres
 - D-Coal 234 Acres
 - C-Coal 285 Acres
 - C-Coal 77 Acres
 - B-Coal 126 Acres
 - Affected 659 Acres
 - Test Holes

MAP NO. 2

Revised: June 15, 1970 for B
Revised: Mar 25, 1970 for C
Revised: Dec 29, 1969
Revised: Oct 11, 1967

P&N COAL

TAYLOR N

PORTER TWP

SCALE - 1 inch =

AUGUST 7, 1969

CLEARFIELD, PA