


LEASED FROM
MOYER & SEYLER,
85 Ast

LEASED FROM
JOHN P. ENTERLINE
75 Ast

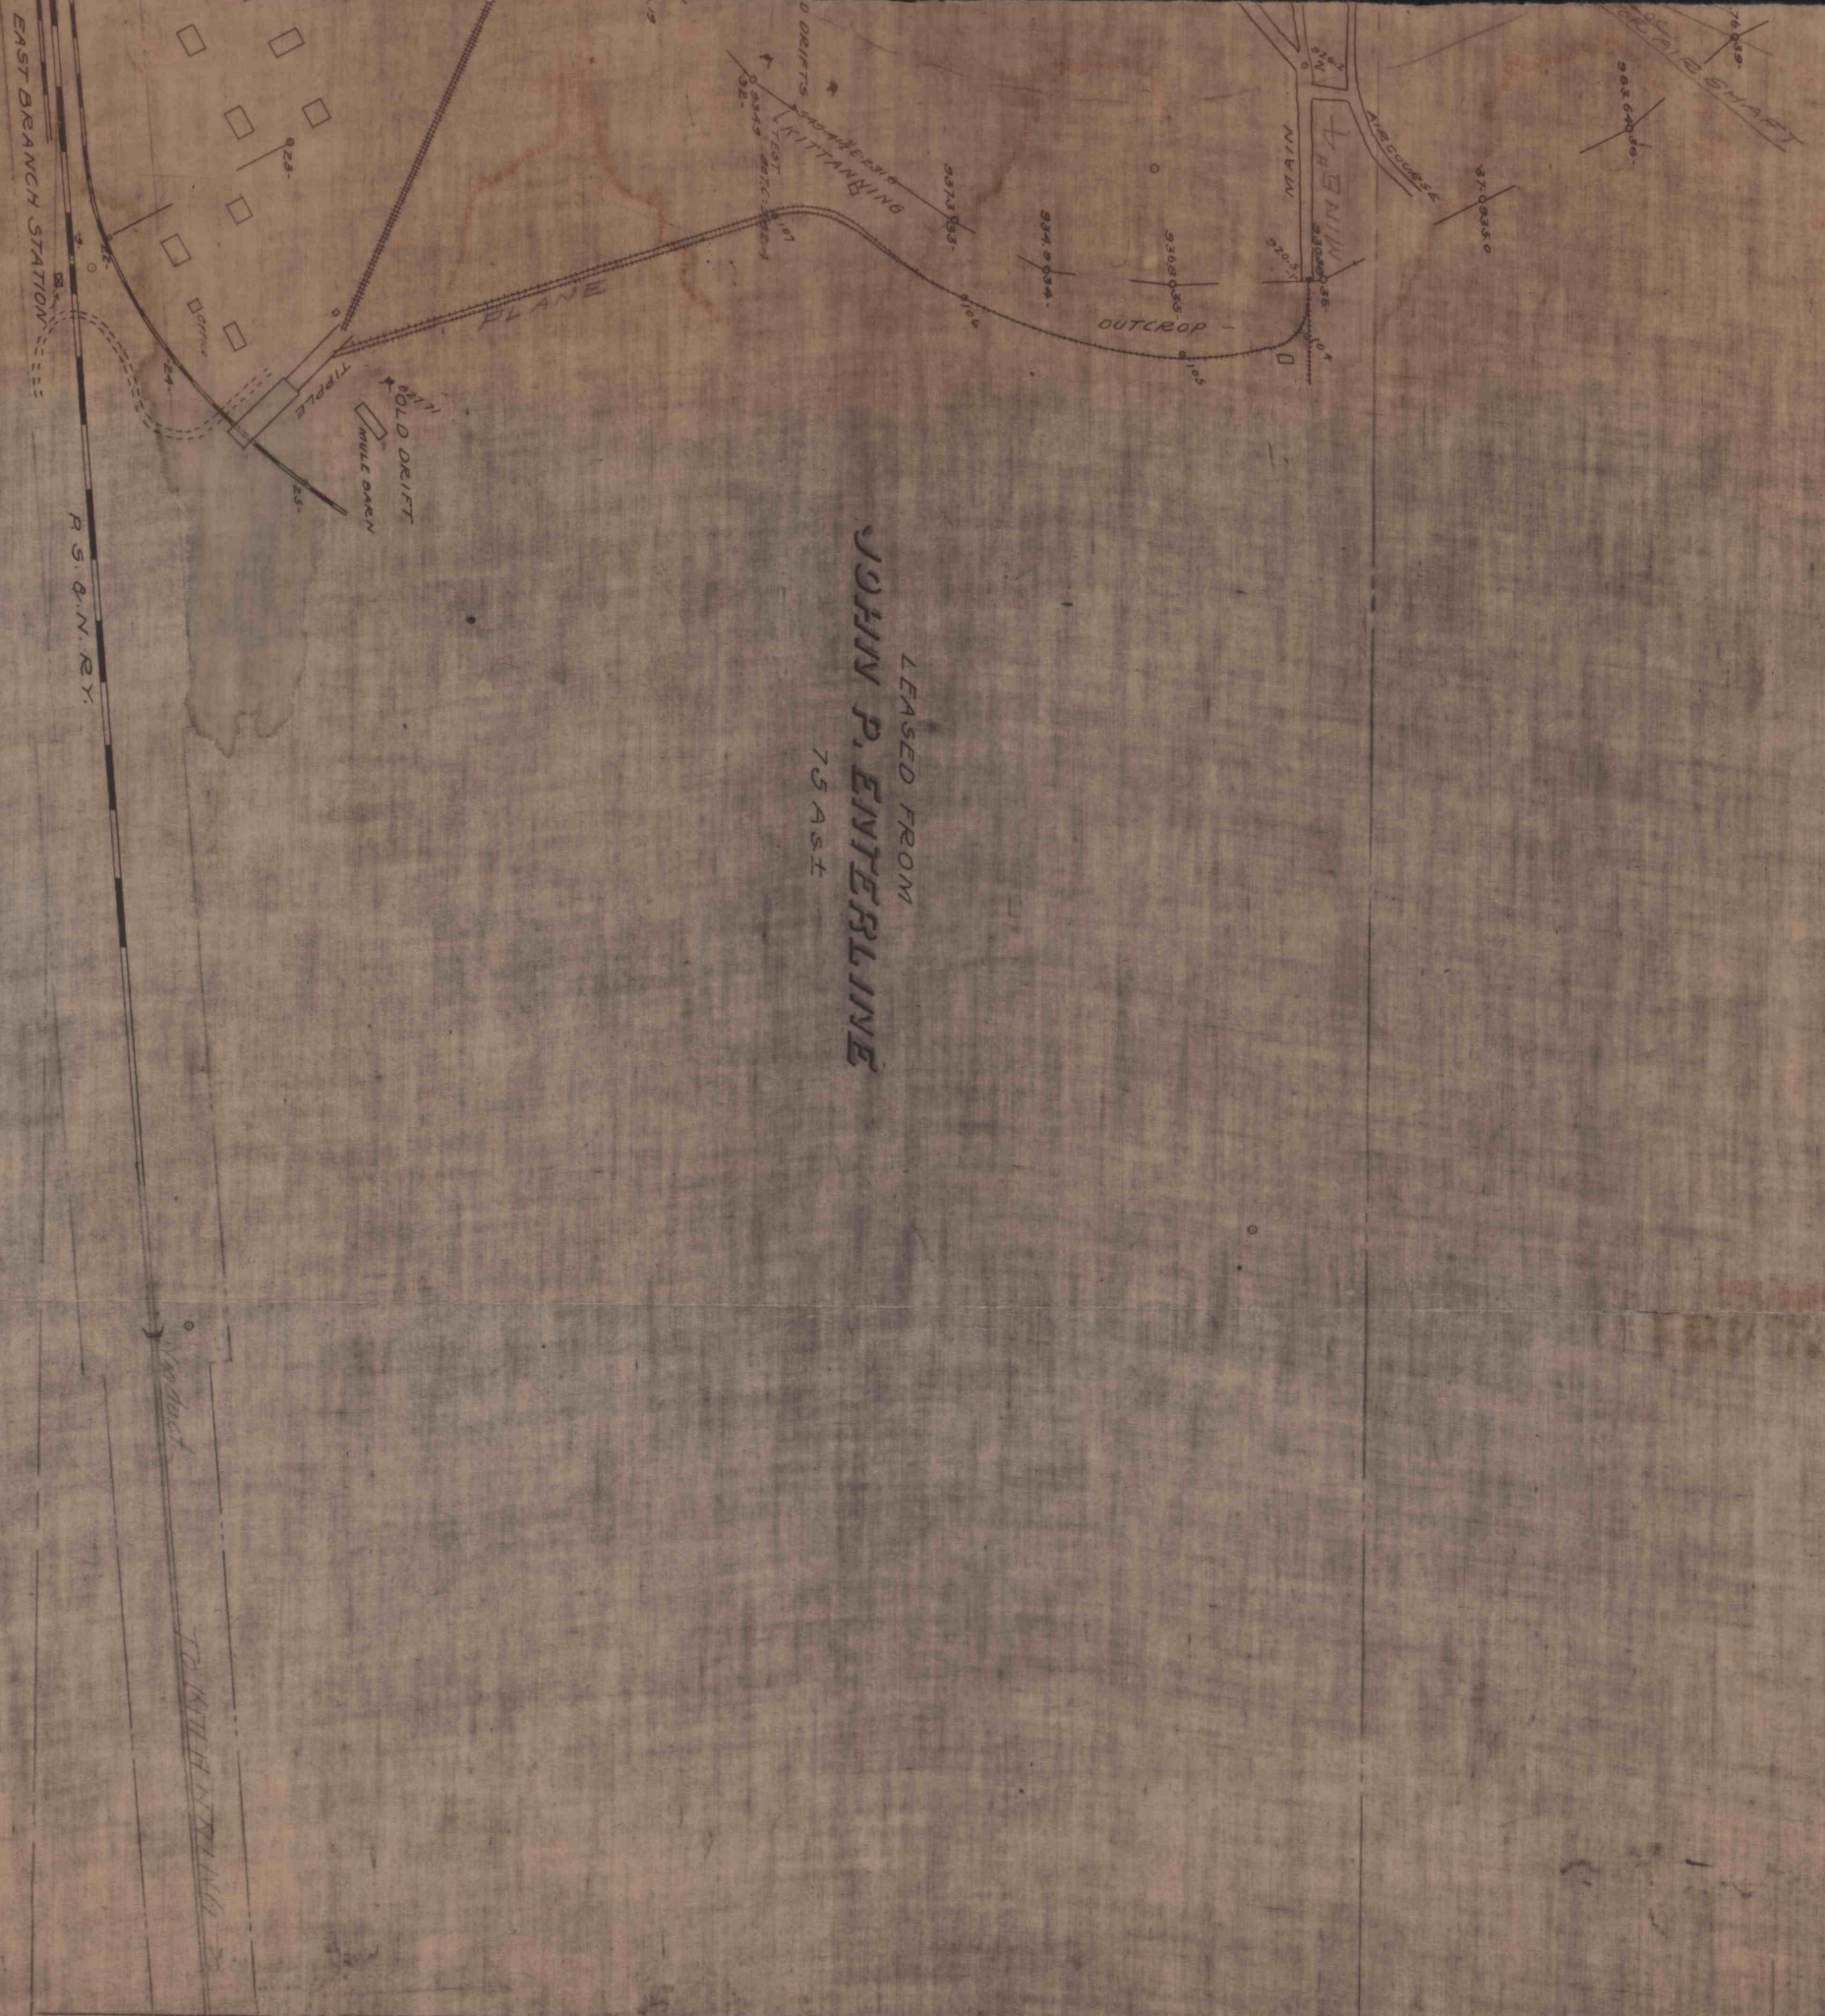

RODGERS EST

EAST BRANCH COAL CO.

COAL OPERATIONS IN-

OLIVER TWP, JEFFERSON CO, PA.

SCALE: 1"=100'

Office of
E. W. Hesse, Engr.
Dubois, Pa.

Surveyed:
Oct 10-16-1920
Dec 15-17-1921

40000 154 171