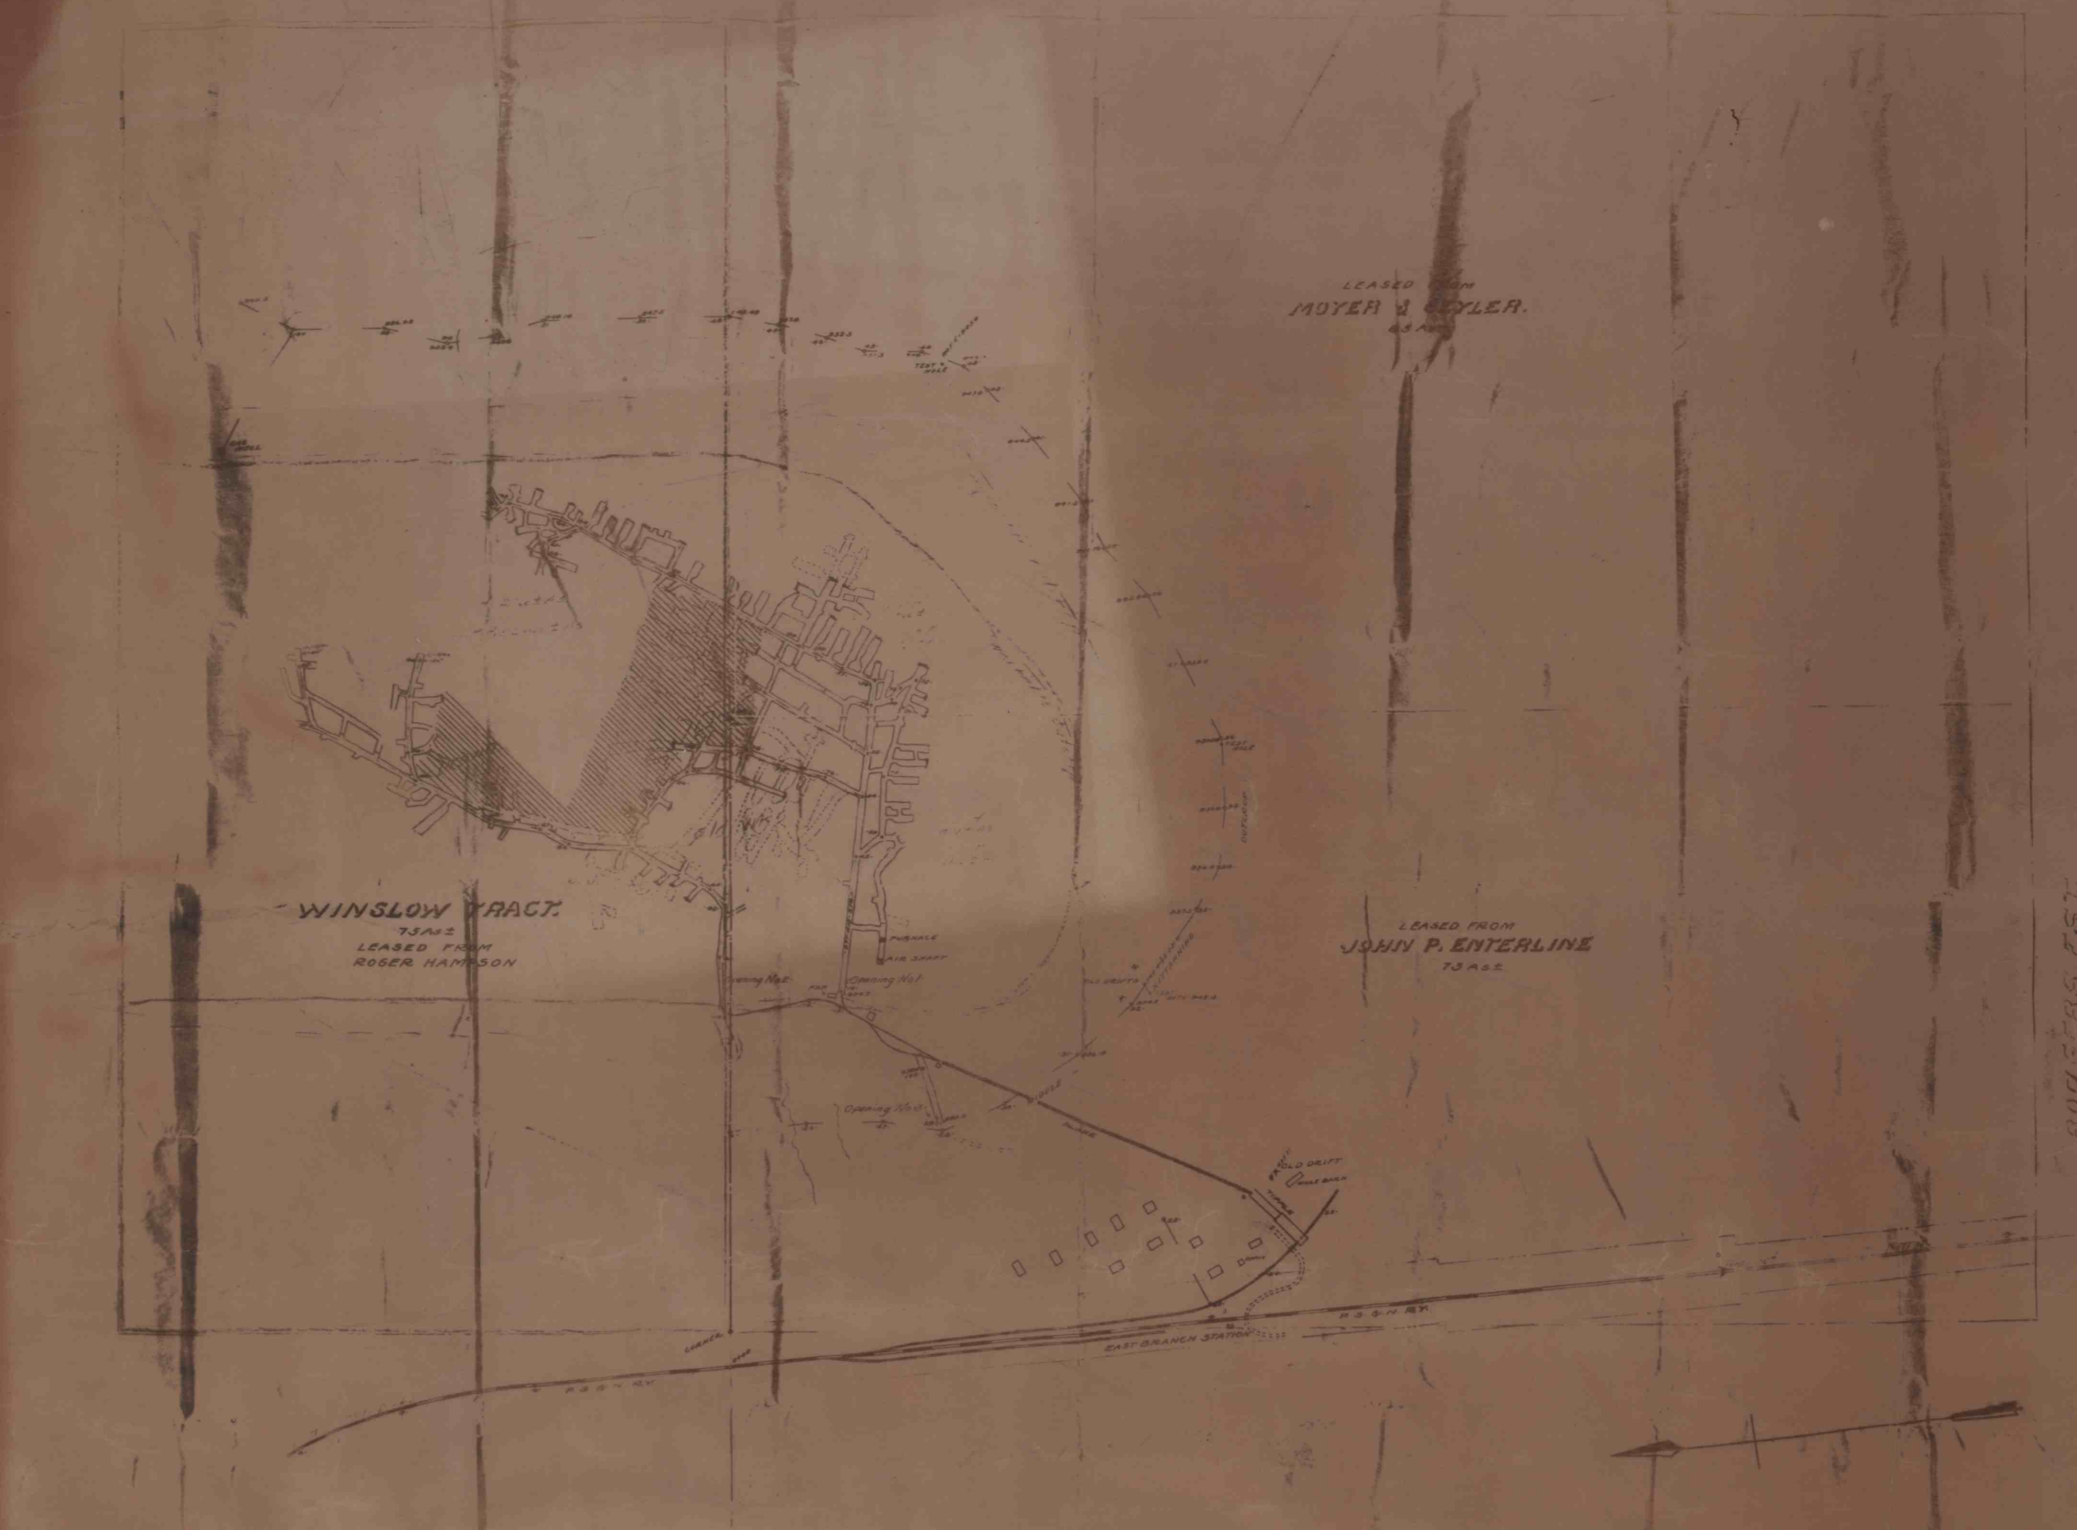

EAST BRANCH COAL CO.

COAL OPERATIONS IN
OLIVER TWP. JEFFERSON CO. PA.
SCALE: 1" = 100'

Office of
[illegible]
DuBois, Pa.

Surveyed
[illegible]

03013 233 31X 303864