




LEGEND
E-Cul 128 Acres
D-Cul 132 Acres
Total Area Affected 260 Acres
Drainage Area Affected
Existing Highways
Existing Drainage
Water Samples

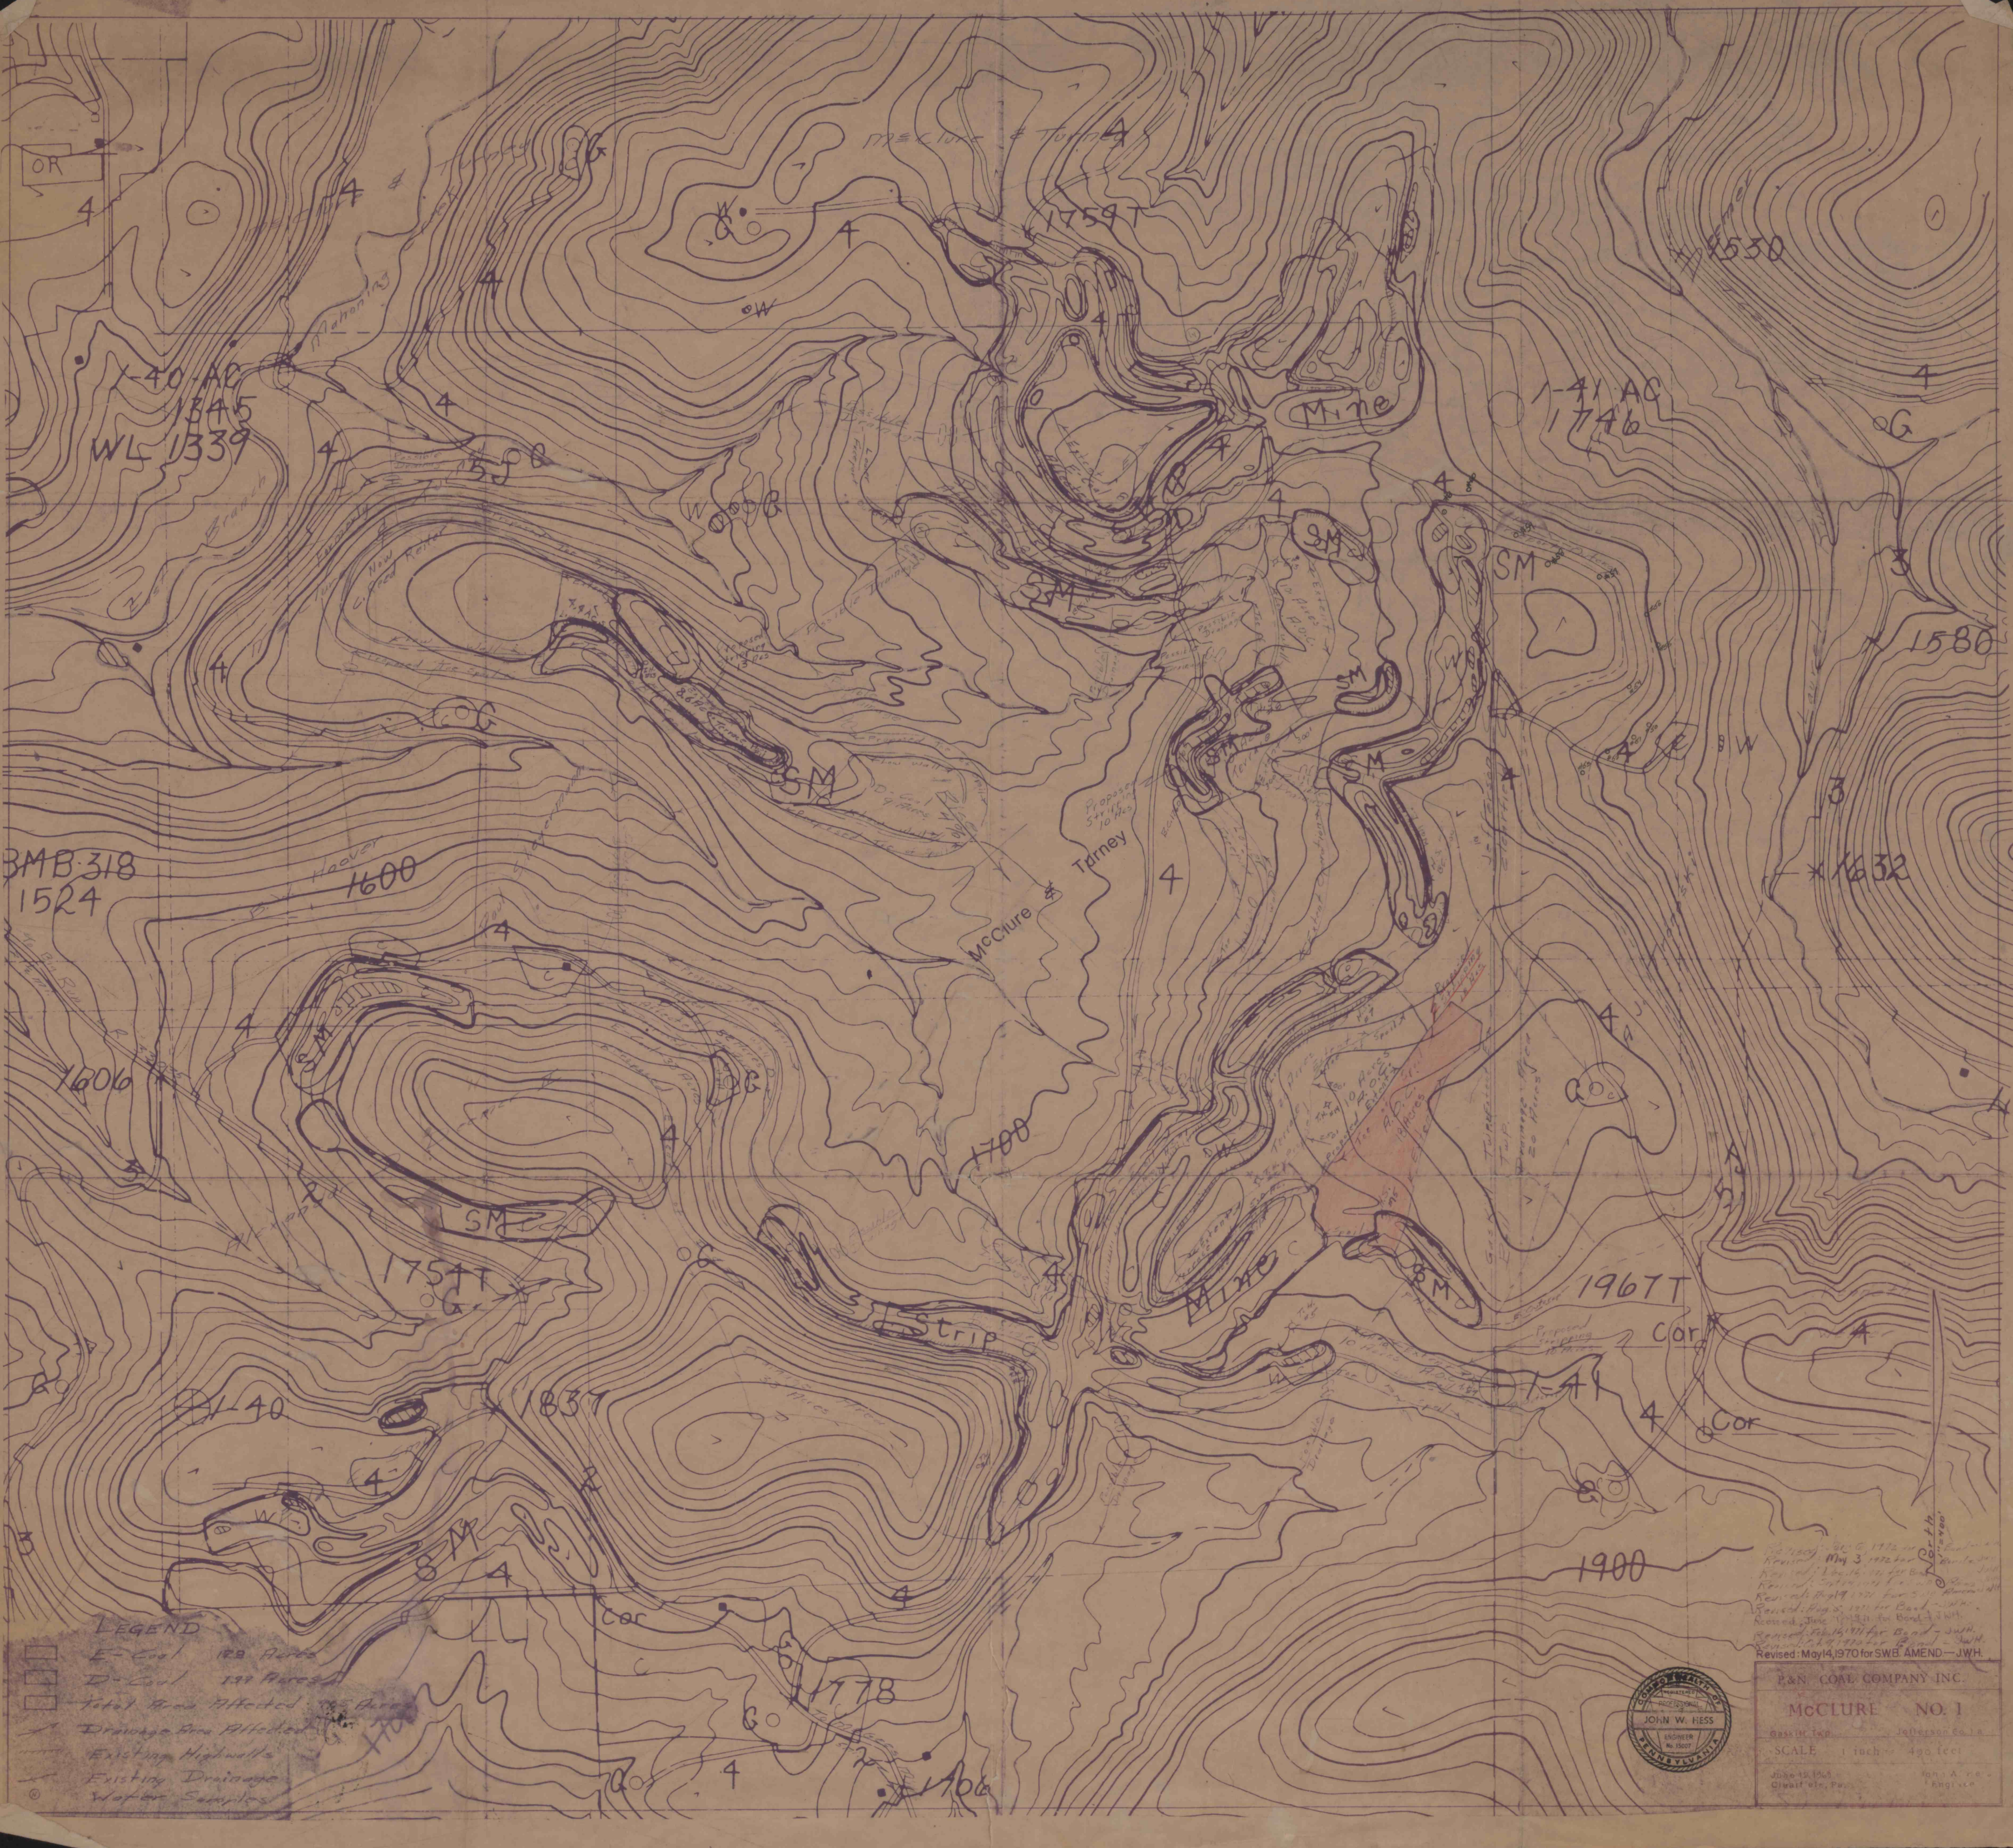

Revised: May 14, 1970 for SWB AMEND-JWH.
P&N COAL COMPANY INC.
McCLURE NO. 1
GRAPHIC SCALE 1 inch = 400 feet
June 12, 1965
Givens v. P. Co.