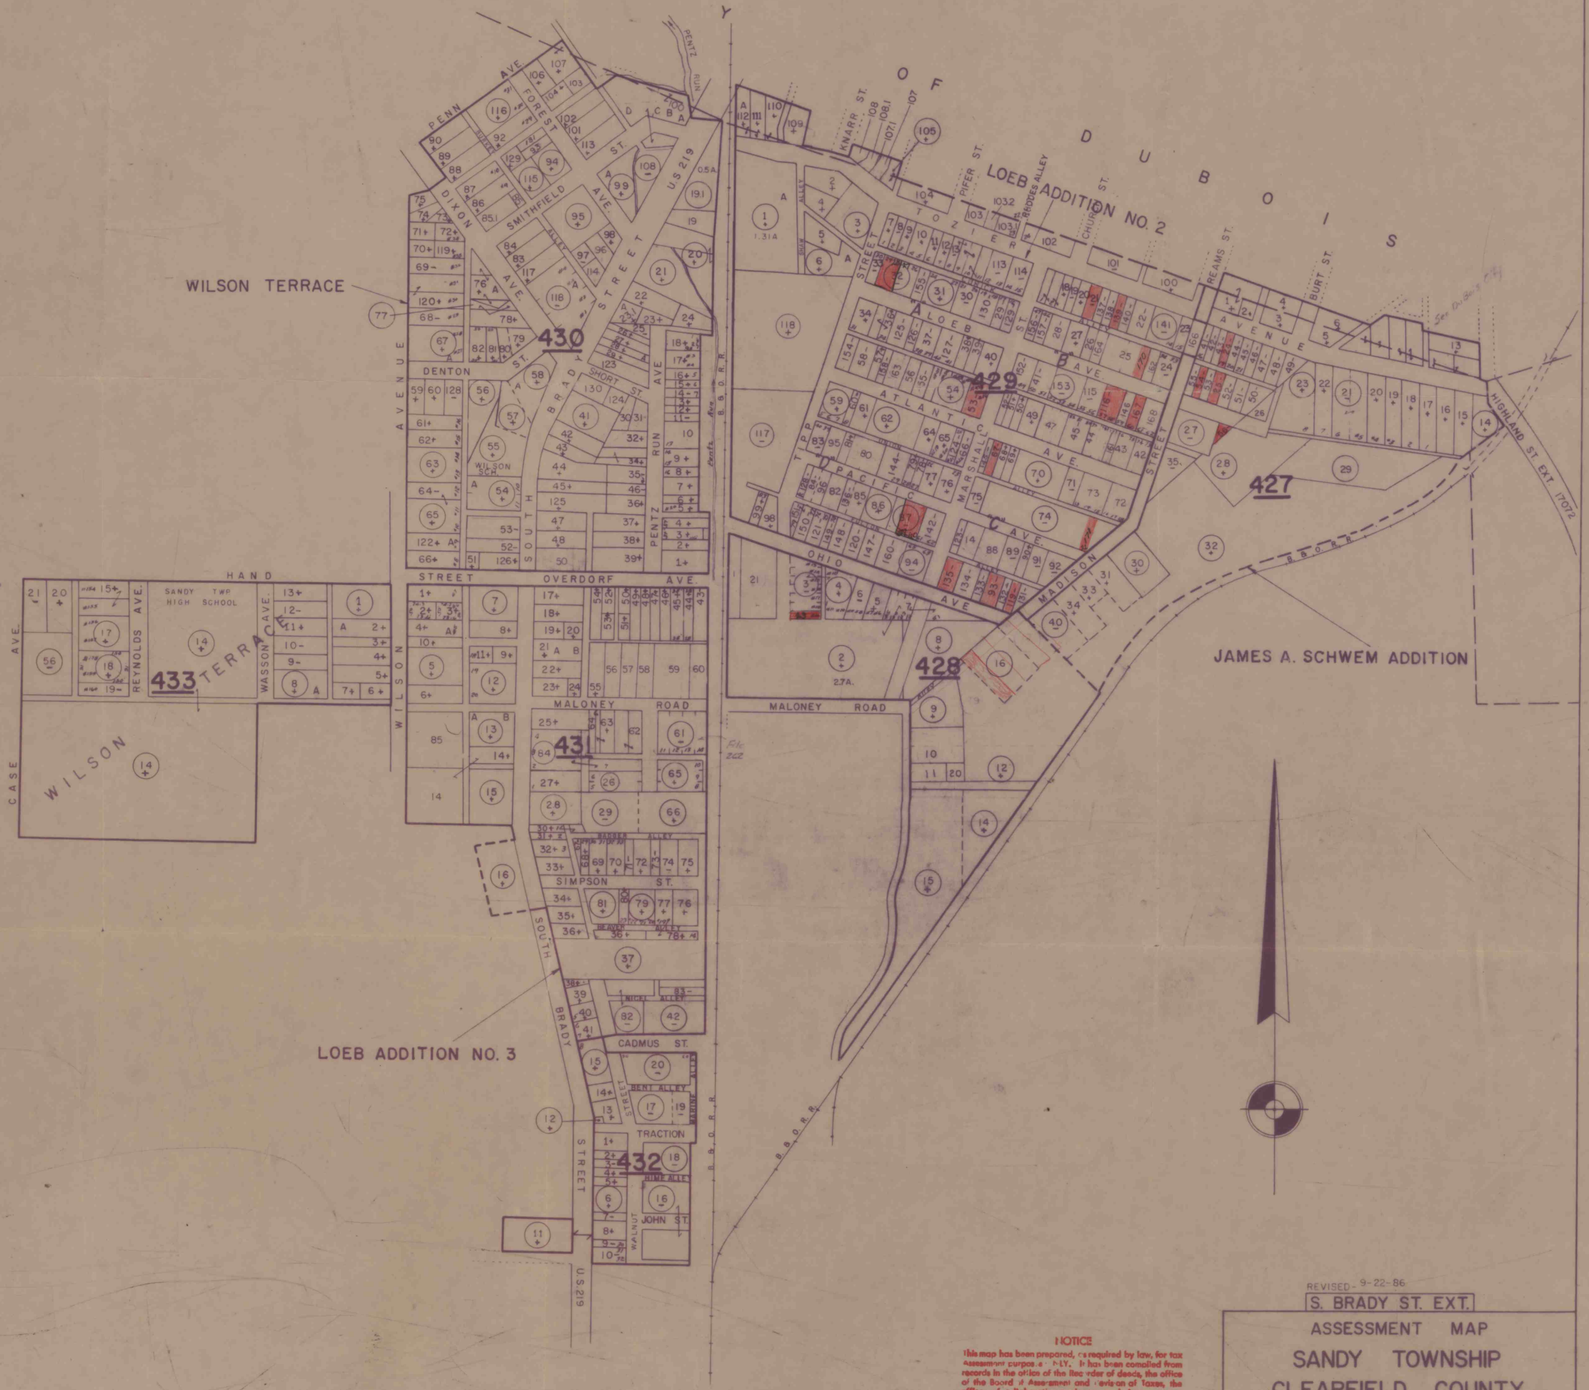


NOTICE

This map has been prepared, as required by law, for tax assessment purposes ONLY. It has been compiled from records in the office of the Recorder of Deeds, the office of the Board of Assessment and Revision of Taxes, the office of collaborating engineers, and, in some cases from field work.

The Clearfield County Board of Assessment and Revision of Taxes

REVISED - 9-22-86

S. BRADY ST. EXT.

ASSESSMENT MAP

SANDY TOWNSHIP

CLEARFIELD COUNTY

PENNSYLVANIA

SCALE 1" = 200' AD - 1956

ENLARGEMENTS NO.	MAP NO.
427,428,429,430,431,432,433	B4

5/08/85

427

1. Kautz, Welthea
2. Kautz, Welthea
3. King, John J.
5. Johnson, Donald L.
13. Bechert, B. A.
14. Lane, Margaret
15. Lane, James H.
17. Weichman, Richard
18. Kalesky, William
19. Rensel, Dallas F.
20. Whitmyer, Wm. T.
21. Gedek, Joseph
22. Gedek, Joseph
23. Gedek, Joseph
26. Misiewicz, Edward
27. Gedeck, Joseph
28. Gedek, Joseph J.
29. Gedek, Joseph J.
30. Dessck, James J.
31. Hoover, Herbert W.
32. Hoover, Herbert W.
33. Jackson, Bessie
34. Hoover, Herbert W.
35. Godek, Joseph
40. Russell, F. Heirs
41. Kautz, Welthea
42. Sekula, Brian S.
44. Sherry, Toni M.
45. Scott, Thomas K.
47. Scott, Thomas K.

428

1. Babcock Lumber Co.
2. Marmon Group, Inc.
3. C. C. I. D. A.
4. C. C. I. D. A.
5. Triangle Auto Spring
6. C. C. I. D. A.
7. Marmon Group, Inc.
8. Karetski, Anna
9. Kolash, Twila G.
10. Masonis, Albert
11. Maleef, Francis
12. Romanak, David
14. Angelo, Betty F.
15. Kolash, William
16. Romanak, David
20. Masonis, Mary A.
21. Pace Precision Tool

429

1. Babcock Lumber Co.
2. Zurinski, Anthony
3. Zurnisky, Anthony
4. Shaffer, Robert A.
5. Pearce, William L.
6. Ross, Ronald C. Sr.
7. Angeletti, Thomas M.
8. McNiel, William B.
9. McNeil, William B.
10. McNeil, William B.
11. McNeil, William B.
12. McNeil, William B.
13. Glowacki, Francis
14. Bloom, George
18. Phillips, Henry F.
19. Senes, William J.
20. Senes, William J.
22.
23. Sekula, Brian S.
24. Salada, Robert S.
25. Salada, Robert S.
26. Hellen, Lemuel E.
27. Hellen, Lemuel E.
28.
29. Phillips, Henry F.
30. Novitsky, Anthony
31. Novitsky, Anthony
34. Johnson, Edward A.
36. Johnson, Edward A.
37. Phillips, Thomas
38. Pindrock, Alex J.
39. Pindrock, Alex J.
40. Mikelonis, Agnest
41. Samanka, John P.
42. Roseman, John
43. Roseman, John
44. Kessler, Daniel
45. Unknown
47. Reed, Velma
49. Misiewicz, Edward
50. Myers, Robert A.
51. Myers, Robert A.
54. Misiewicz, Edward
55. Bloom, George
56. Misiewicz, Edward
57. Lewis, Laura A.
59. Seary, John E.
60. Seary, John E.
61. Barrett, Lynda N.
62. Smith, James W.
64. Scull, John E.
65. Zilleox, Bruce M.
66. Zilleox, Bruce M.
68. Admin. of Va
69. Waseleski, Stanley
70. Solida, Donald L.
71. Solida, Donald L.
72. Roseman, John P.
73. Bloom, George
76. Preston, Rodney R.
77. Poole, Edward L.
79. Olson, Margaret M.
80. Burton, Gerald
81. Kurtz, Joseph
82. Triangle Auto Spring
83. Scott, Thomas K.
85. DeJohn, Richard
86. Salada, Donald J.
88. Mowery, Kim
89. Griffith, Anne
90. Griffith, Anne
91. Griffith, Anne
94. Marmon Group, Inc.
95. Kurtz, Joseph
96. Spinda, George A.
98. Armelovich, John
99. Harw, Kenneth
101. Main, William A.

429

102. Clont, Wm. D.
103. Allen, John A.
103.1 Roy, Karen J.
103.2 USDA - FHA
104. Hoover, Arvon
105. Duttry, Joyce M.
107. Kennelly, Harold
107.1 Bundy, Donald R.
108. Rupert, John
108.1 Bundy, Donald E.
109. Updyke, Everett
110. Schmidt, Leona
111. Folta, Frederick
112. Updyke, Everett
113. Phillips, Henry F.
114. Phillips, Henry
115. Davis, Miriam L.
116. Unknown
117. C. C. I. D. A.
118. Babcock Lumber Co.
120. Marmon Group, Inc.
121. Marmon Group, Inc.
122. Scott, Thomas K.
123. Triangle Auto Spring
124. Zilleox, Bruce M.
125. Phillips, Thomas H.
126. Phillips, Thomas H.
127. Phillips, Thomas H.
128. Triangle Auto Spring
129. Phillips, Henry F.
130. Phillips, Henry
132. Clfd. Co.
134. Clfd. Co.
140. Clfd. Co.
141. Spencer Land Co.
142. Weir, Charles A.
144. Olson, Margaret M.
146. Morse, Robert
147. Marmon Group, Inc.
148. Marmon Group, Inc.
149. Marmon Group, Inc.
150. Marmon Group, Inc.
151. Marmon Group, Inc.
152. Samanka, John P.
154. Barrett, Frank T.
156. Hollen, Lemuel E.
157. Hollen, Lemuel E.
158. Misiewicz, Edward
160. Marmon Group, Inc.
161. Roseman, John
162. Salada, Robert S.
163. Bloom, George
164. Salada, Robert S.

430

1. Zawansky, Alfred
2. Boyer, Gerald W.
3. Howatt, Thomas S.
4. Shaffer, Robert M.
5. Shaffer, Robert M.
6. Powers, Judy
7. Stump, Lloyd F.
8. Sherkosky, John
9. Kopshina, Leroy H.
10. Sayers, Martha S.
11. Wilson, Louis C.
12. Wilson, Louis C.
13. Wilson, Louis
14. Getz, Delores
15. Getz, Delores
16. Ferguson, Perry M.
17. Bovaird, Frederick
18. Bovaird, Frederick
19. Rosio, James R.
19.1 Rosio, James R.
20. Pifer, John A.
21. Neasinger, Wm. Jr.
22. K & M, Inc.
23. Marshall, Elsie M.
23.1 Zilleox, Clara I.
24. Marshall, Elsie M.
25. Paglie, Nick F.
26. Paglie, Nick F.
27. Watt, James
28. Peters, James Heirs
29. McKee, Robert E.
30. LaBenne, Richard G.
31. Strum, Lewis H. Jr.
32. Rusonis, Alphonse
34. Lyons, Charles
35. Tabone, Philip J.
36. Schott, Thomas E.
37. Aravich, Thomas J.
38. Brasseur, Edgar F.
39. Graham, Ruby A.
41. Hanes, John A.
42. Hand, William C.
43. Shaddock, Russell
44. Tabone, Philip J.
45. Mauk, Fred
46. Schott, Thomas E.
47. Tabone, Philip J.
48. Henry, Robert W.
50. Lepionka, Michael
51. Watson, Edward Jr.
52. Minns, Clarence L.
53. Minns, Clarence L.
54. Beshada, John I.
55. Wilson School Bldg.
56. Wells, Ralph
57. Beggs, Ruth A.
58. K. J. Depco, Inc.
59. Lukens, Mary K.
60. Mt. Zion U. Meth. Ch
61. Mackin, Marie T.
62. Harvey, Mary
63. Marshall, David L.
64. Sprague, Gerald E.
65. Sprague, Gerald E.
66. Calvert, George E.
67. Mt. Zion Meth. Ch.
68. Mt. Zion Meth Ch.
69. Watson, Edward Jr.
70. Watson, Edward Jr.
71. Snyder, Harold
72. Brunswick, Jacob M.
73. Brunswick, Jeffrey
74. Brunswick, Jeffrey
75. Marsh, Earl E.
76. Hasselback, Walter W.

430

77. Watson, Arthur
78. Kweder, Albert
79. Heitzenrether, G.
80. Kwederwich, Albert
81. Cessna, Roxie
82. Heller, Cletas
83. Sandy Elect. House
84. Sandy Hose Co. #1
85. Pudya, Lamar
85.1 Puyda, Lamar
86. Pittsley, James
87. Smith, Gary L.
88. Olson, Patricia
89. Karch, Albert
90. Aravich, Eugene
92. Smith, Lee A.
93. Depra, Sam
94. Carlson, Robert
95. Sandy Hose Co. #1
96. Haley, Kenneth A.
97. Haley, Kenneth A.
98. Farulski, Dorothy
99. Golub, Yale
100. U-Stor-It
101. Atkinson, Frederick
102. Atkinson, Frederick
103. Bearfield, William A.
104. Berfield, William A.
106. Wingrove, H. Floyd
107. Harwick, Leland
108. Comm. of Penna.
113. Felts, Paul
114. Smith, Robert L.
115. Dixon, Francis Jr.
116. Liedl, Ann C.
117. Previs, Stephen R.
118. London, Raymond
119. Brunswick, Jacob M.
120. McNight, Patricia E.
122. Calvert, Loretta E.
123. Frankoski, Rose
124. Hanes, John A.
125. Tebone, Philip J.
126. Minns, Clarence L.
128. Mt. Zion Meth. Ch.
129. Reasinger, James E.
130. Hanes, John A.
131. Kalgren, Mark A.

431

1. Chollock, Gary J.
2. Godek, Thomas J.
3. Kautz, Errol R.
4. Smith, Richard A.
5. Carr, James
6. Beers, William A.
7. Snyder, Cloyd B.
8. Snyder, Cloyd B.
9. Hand, Charles
10. Hand, Emery
11. Hand, Emery C.
12. Ellenberger, Budd C.
13. Bledose, Howard R.
14. Schoch, Jacqueline L.
15. Verry, Francis A.
16. Cherry, Joseph
17. Dilts, Janice R.
18. Stanton, Samuel
19. Droney, Eleanor J.
20. Sekula, Yolanda M.
21. Sekula, Stanley
22. Sekula, Stanley
23. Babarsky, Ralph
24. Sekula, Stanley
25. Heilburn, Ethel
26. Scollins, John
27. Laman, Richard J.
28. Laman, Richard
29. Laman, Richard J.
30. McGlinsky, Kathryn
31. Lazor, Joseph
32. Lawson, Robert G.
33. Rake, Jacqueline L.
34. Yesnesky, Stanley
35. Cativera, Ronald A.
36. Gearhart, William
37. Beck, John L.
38. Beck, John L.
39. Beck, John L.
40. Kuntz, Laura A.
41. Stottish, Marlene
42. Mowrey, Harry L.
43. Okonski, Donald M.
44. Okonski, Donald M.
45. Knittle, Robert C.
46. Knittle, Robert C.
47. Smith, Howard A.
48. Kessler, Dorothy M.
49. Lee, Marilynn
50. Ferrie, Charles
51. Peoples Sav. & Loan
52. O'Donell, Floyd R.
53. Shrauger, Calvin D.
54. Whitehouse, Leroy J.
55. Kessler, Clair
56. Chittister, F. L.
57. Sikora, Edward E.
58. London, R. Wayne
59. August, James J.
60. Tubbs, LaMar A.
61. Scollins, John
62. Frantz, Earl
63. Gelnett, Cecil E.
64. Klebacha, Leo J.
65. Marshall, Elsie M.
66. Duffalo, Ann
67. Shaffer, James
68. Shaffer, J. A.
69. Kuruvilla, Joy C.
70. Rogman, John R.
72. Heberling, Joseph
73. Salada, Alberta L.
75. Salada, Alberta L.
76. Gilbert, Edward J.
77. Gilbert, Edward J.
78. Gilbert, Edward J.
79. Stanton, Thomas
80. Stanton, Thomas
81. Owens, Floyd
82. Beck, John L.

432

83. Mowrey, Harry L.
84. Laman, Richard
85. Deitch, Marlin D.

432

1. Tests, James D.
2. Tests, James D.
3. Tests, James D.
4. Frantz, Donald R.
5. Cerle, Bradley E.
6. Bowers, Shirley M.
7. Rhodes, Ronald A.
8. Rhodes, Ronald A.
10. Fertzer, Harold
11. Snyder, Arthur
12. Johnson, Paul L.
13. Johnson, Paul L.
14. Cewie, William
15. Striegel, Lowell
16. Tests, James
17. Abraczinskas, J.
18. Tests, James D.
19. Johnson, Paul L.
20. Kerman, Fred

433

1. Burkett, Kathryn
2. Calvert, John
3. McFall, John E.
4. Bailey, Elodia J.
5. Tomb, F. K.
6. Haun, Charles
7. Wells, Theodore
8. Divins, Robert
9. Divins, Robert
10. Divins, Robert
11. Divins, Robert
12. Divins, Robert
13. Williams, R.
14. Sandy Twp. School
15. Paune, Samuel
17. Bedell, Orin
18. Smith, Donald
19. Brendle, Edward
20. Garthwaite, N.
21. Pierce, Robert
56. Reitz, Thomas E.

(429)

#93 Compass Coal Co Lots 53/54 Lock

#67 Compass Coal Co Lot #2

#167 Compass Coal Lot #60

#53 Compass Coal Co Lots #46/47

#21 Compass Coal Co Lots #6

#139 Compass Coal Lot #9

#170 Compass Coal Co Lot #30 #27

#25 Compass Coal Co Lot #29

#24 Compass Coal Co Lot #18