


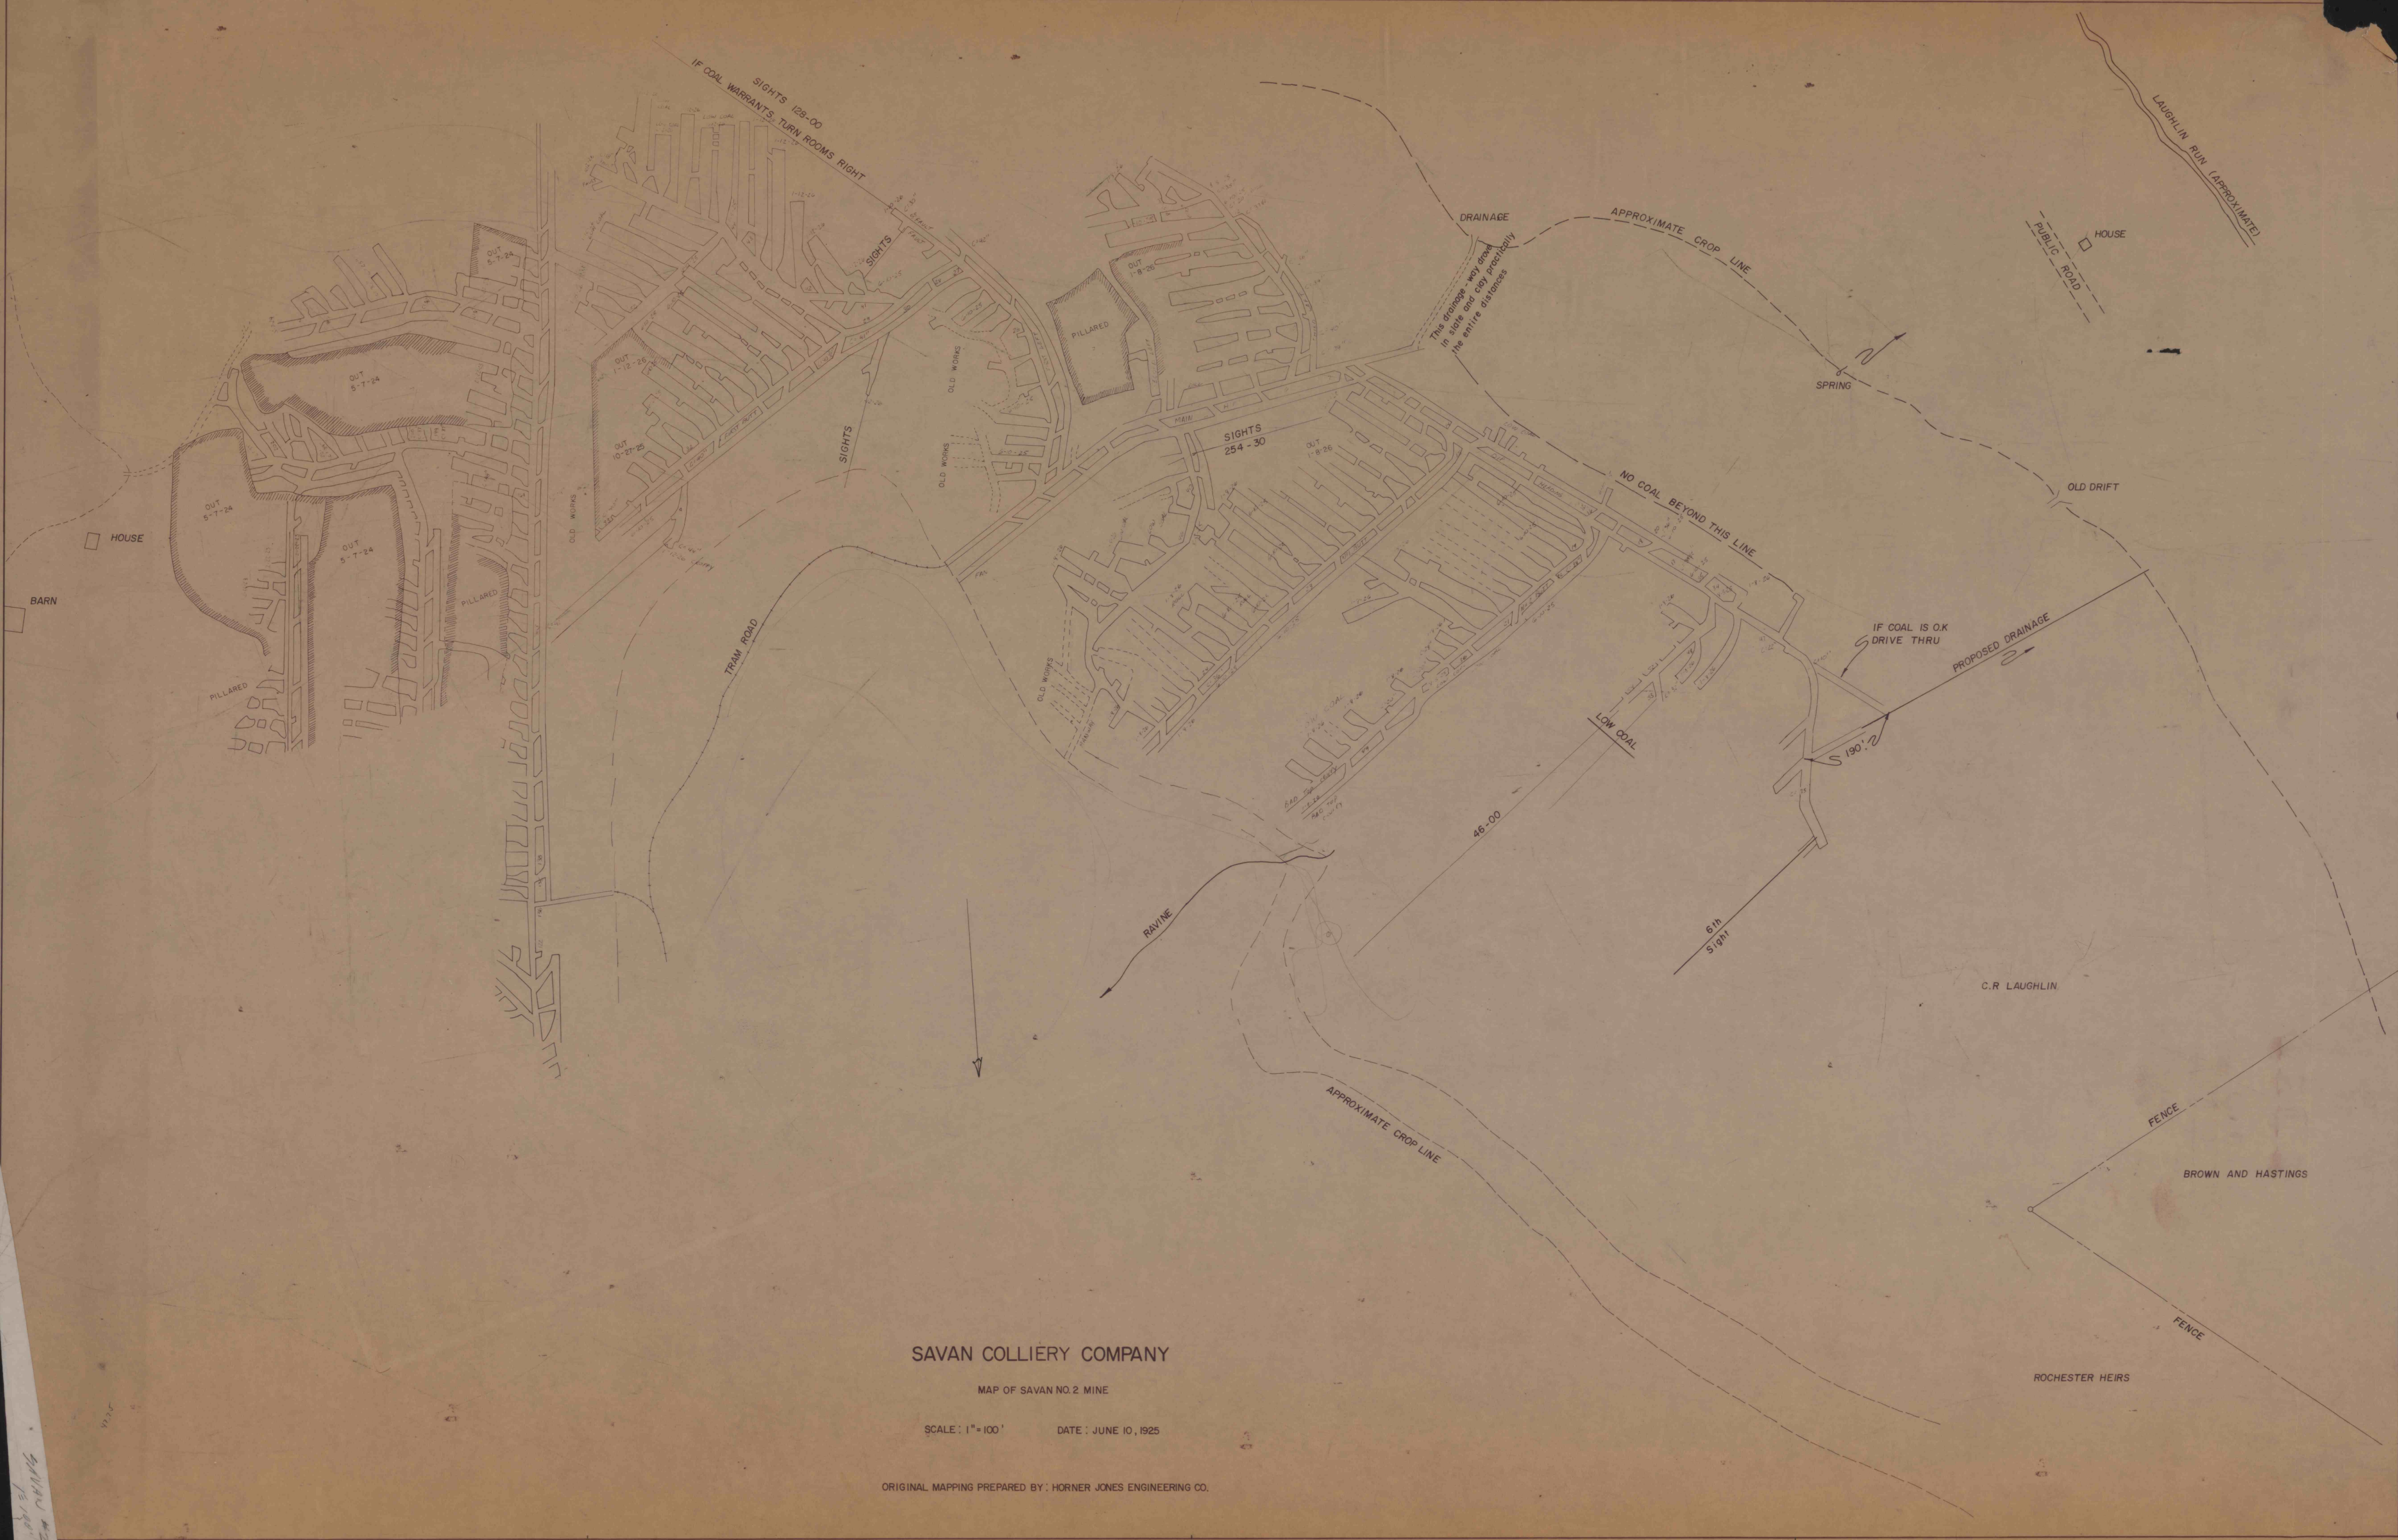

SAVAN COLLIERY COMPANY

MAP OF SAVAN NO. 2 MINE

SCALE: 1" = 100'

DATE: JUNE 10, 1925

ORIGINAL MAPPING PREPARED BY: HORNER JONES ENGINEERING CO.

SAVAN NO. 2
JUN 10 1925