


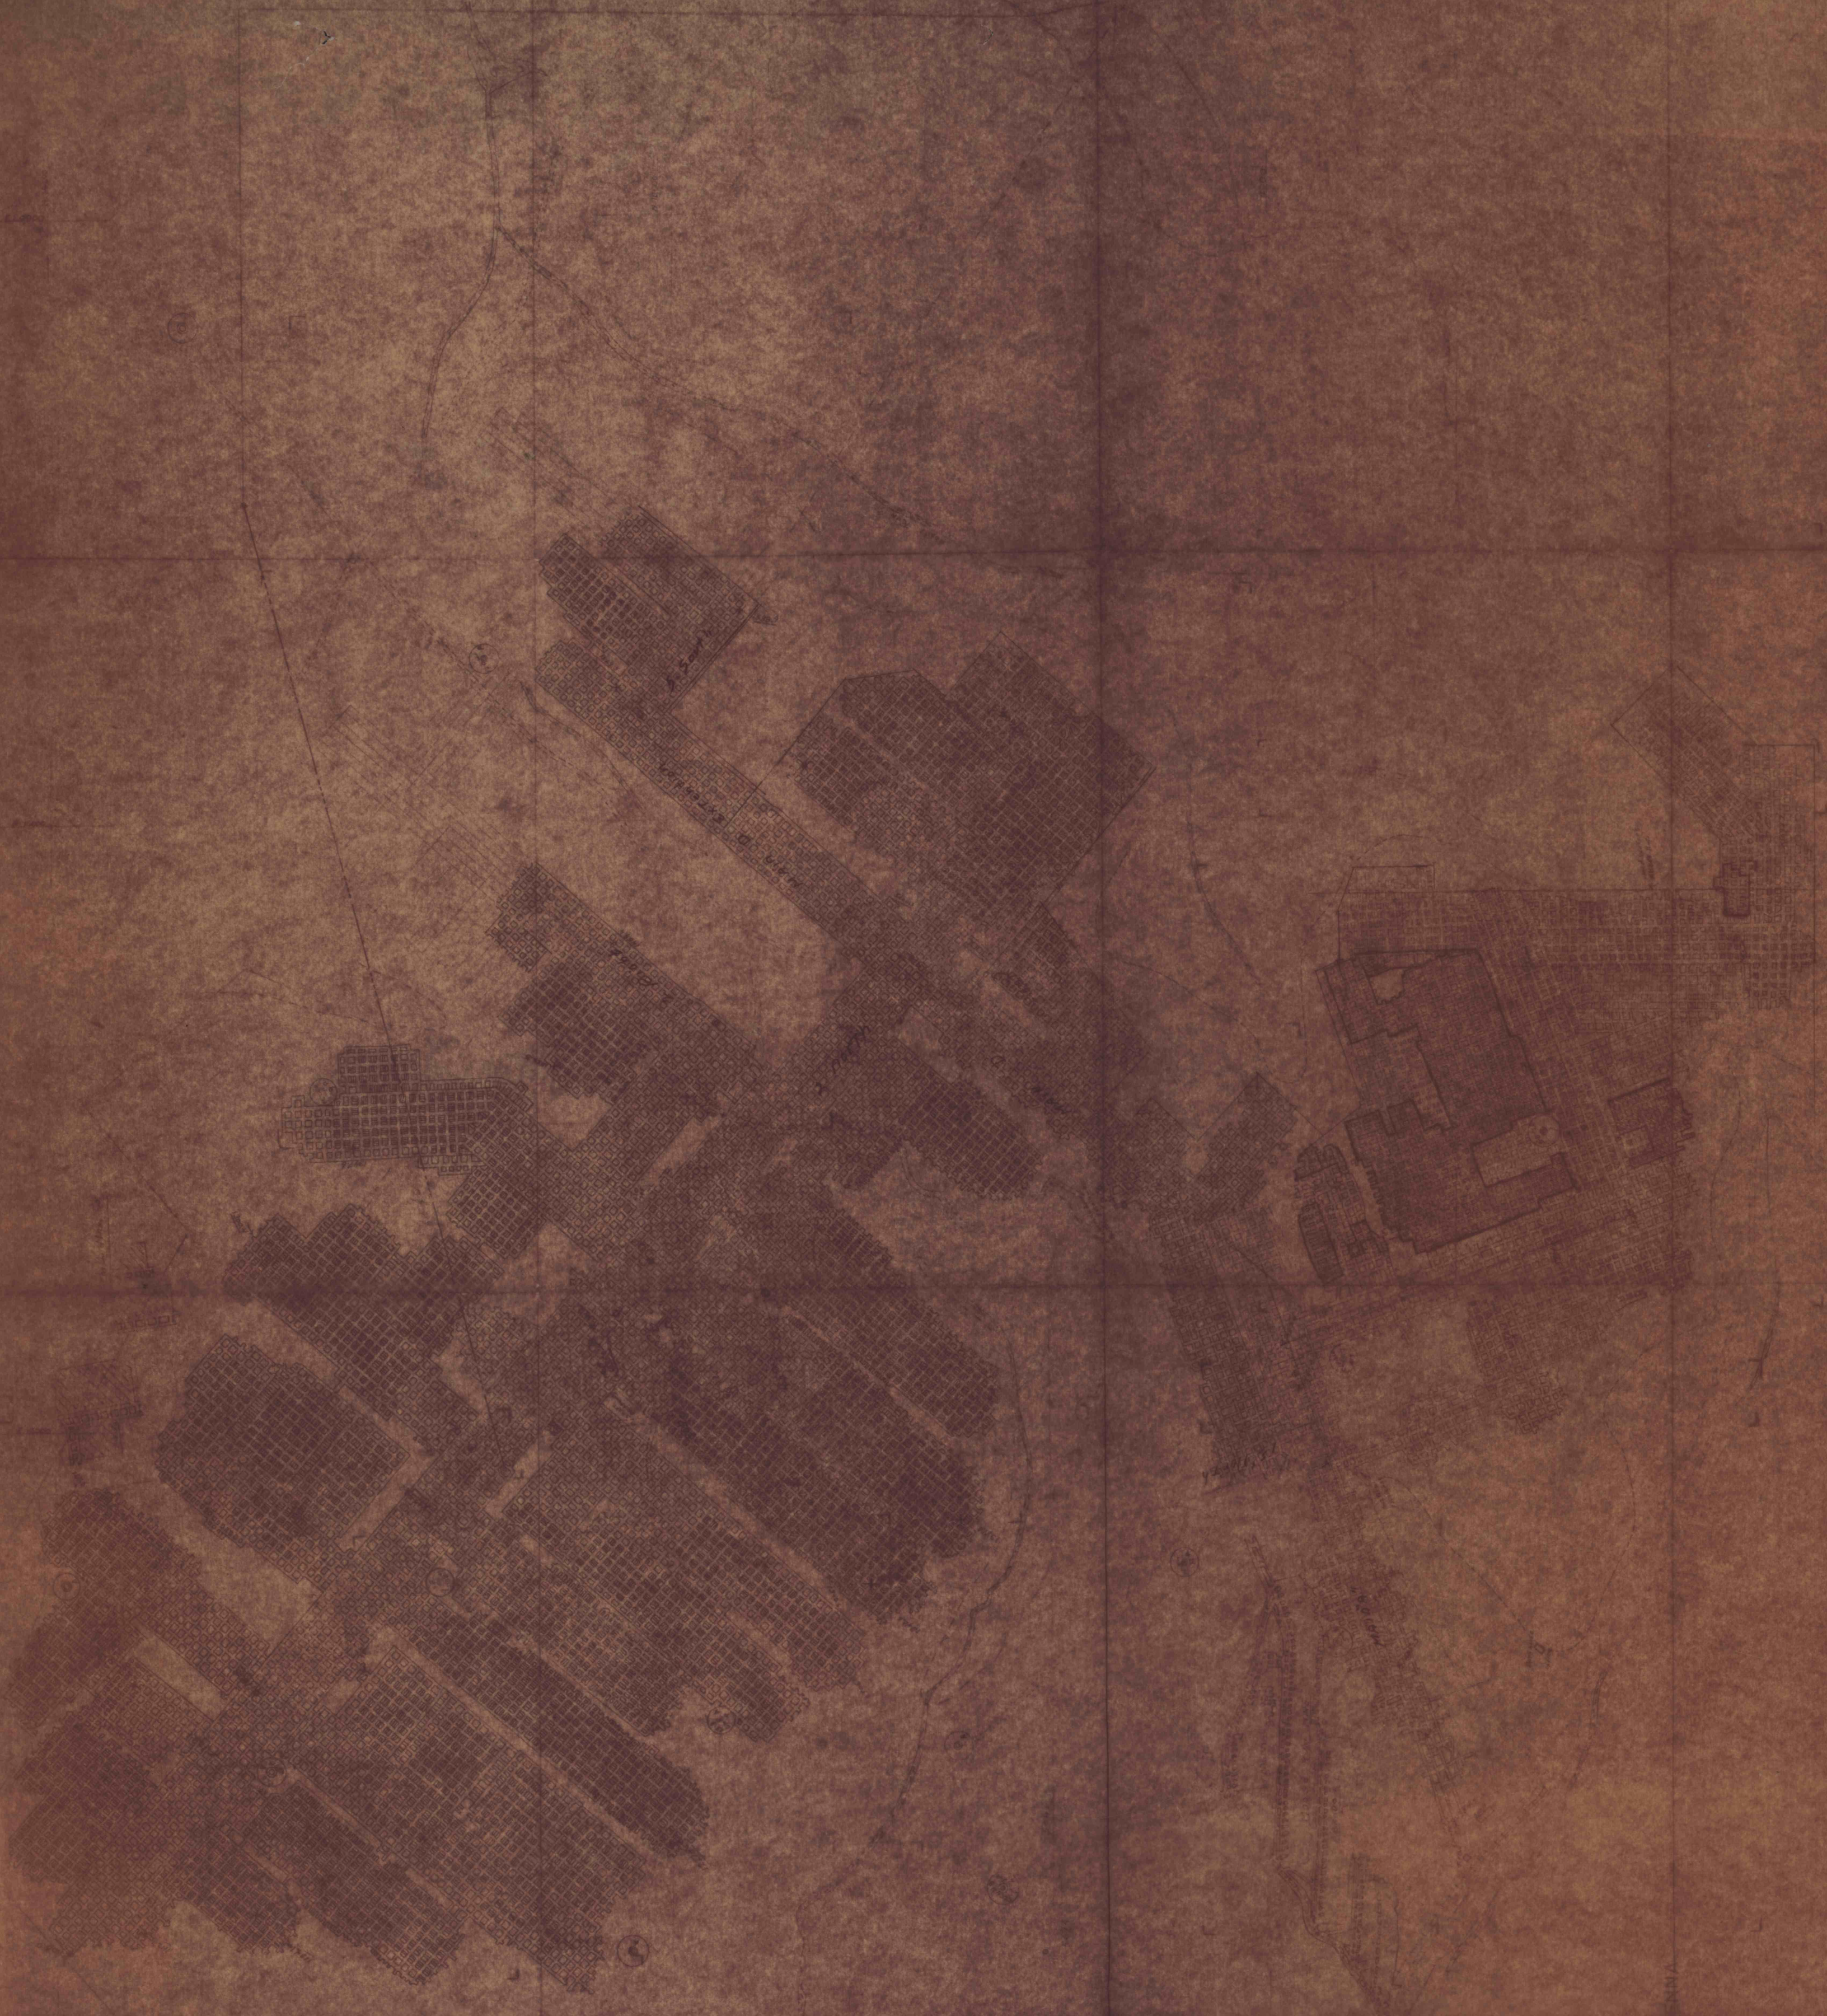

LAY JANE COLLIERIES, INC.
SLOTT AND LINE P. SEAM, C. L. D. CO.
SCALE 1" = 100'

