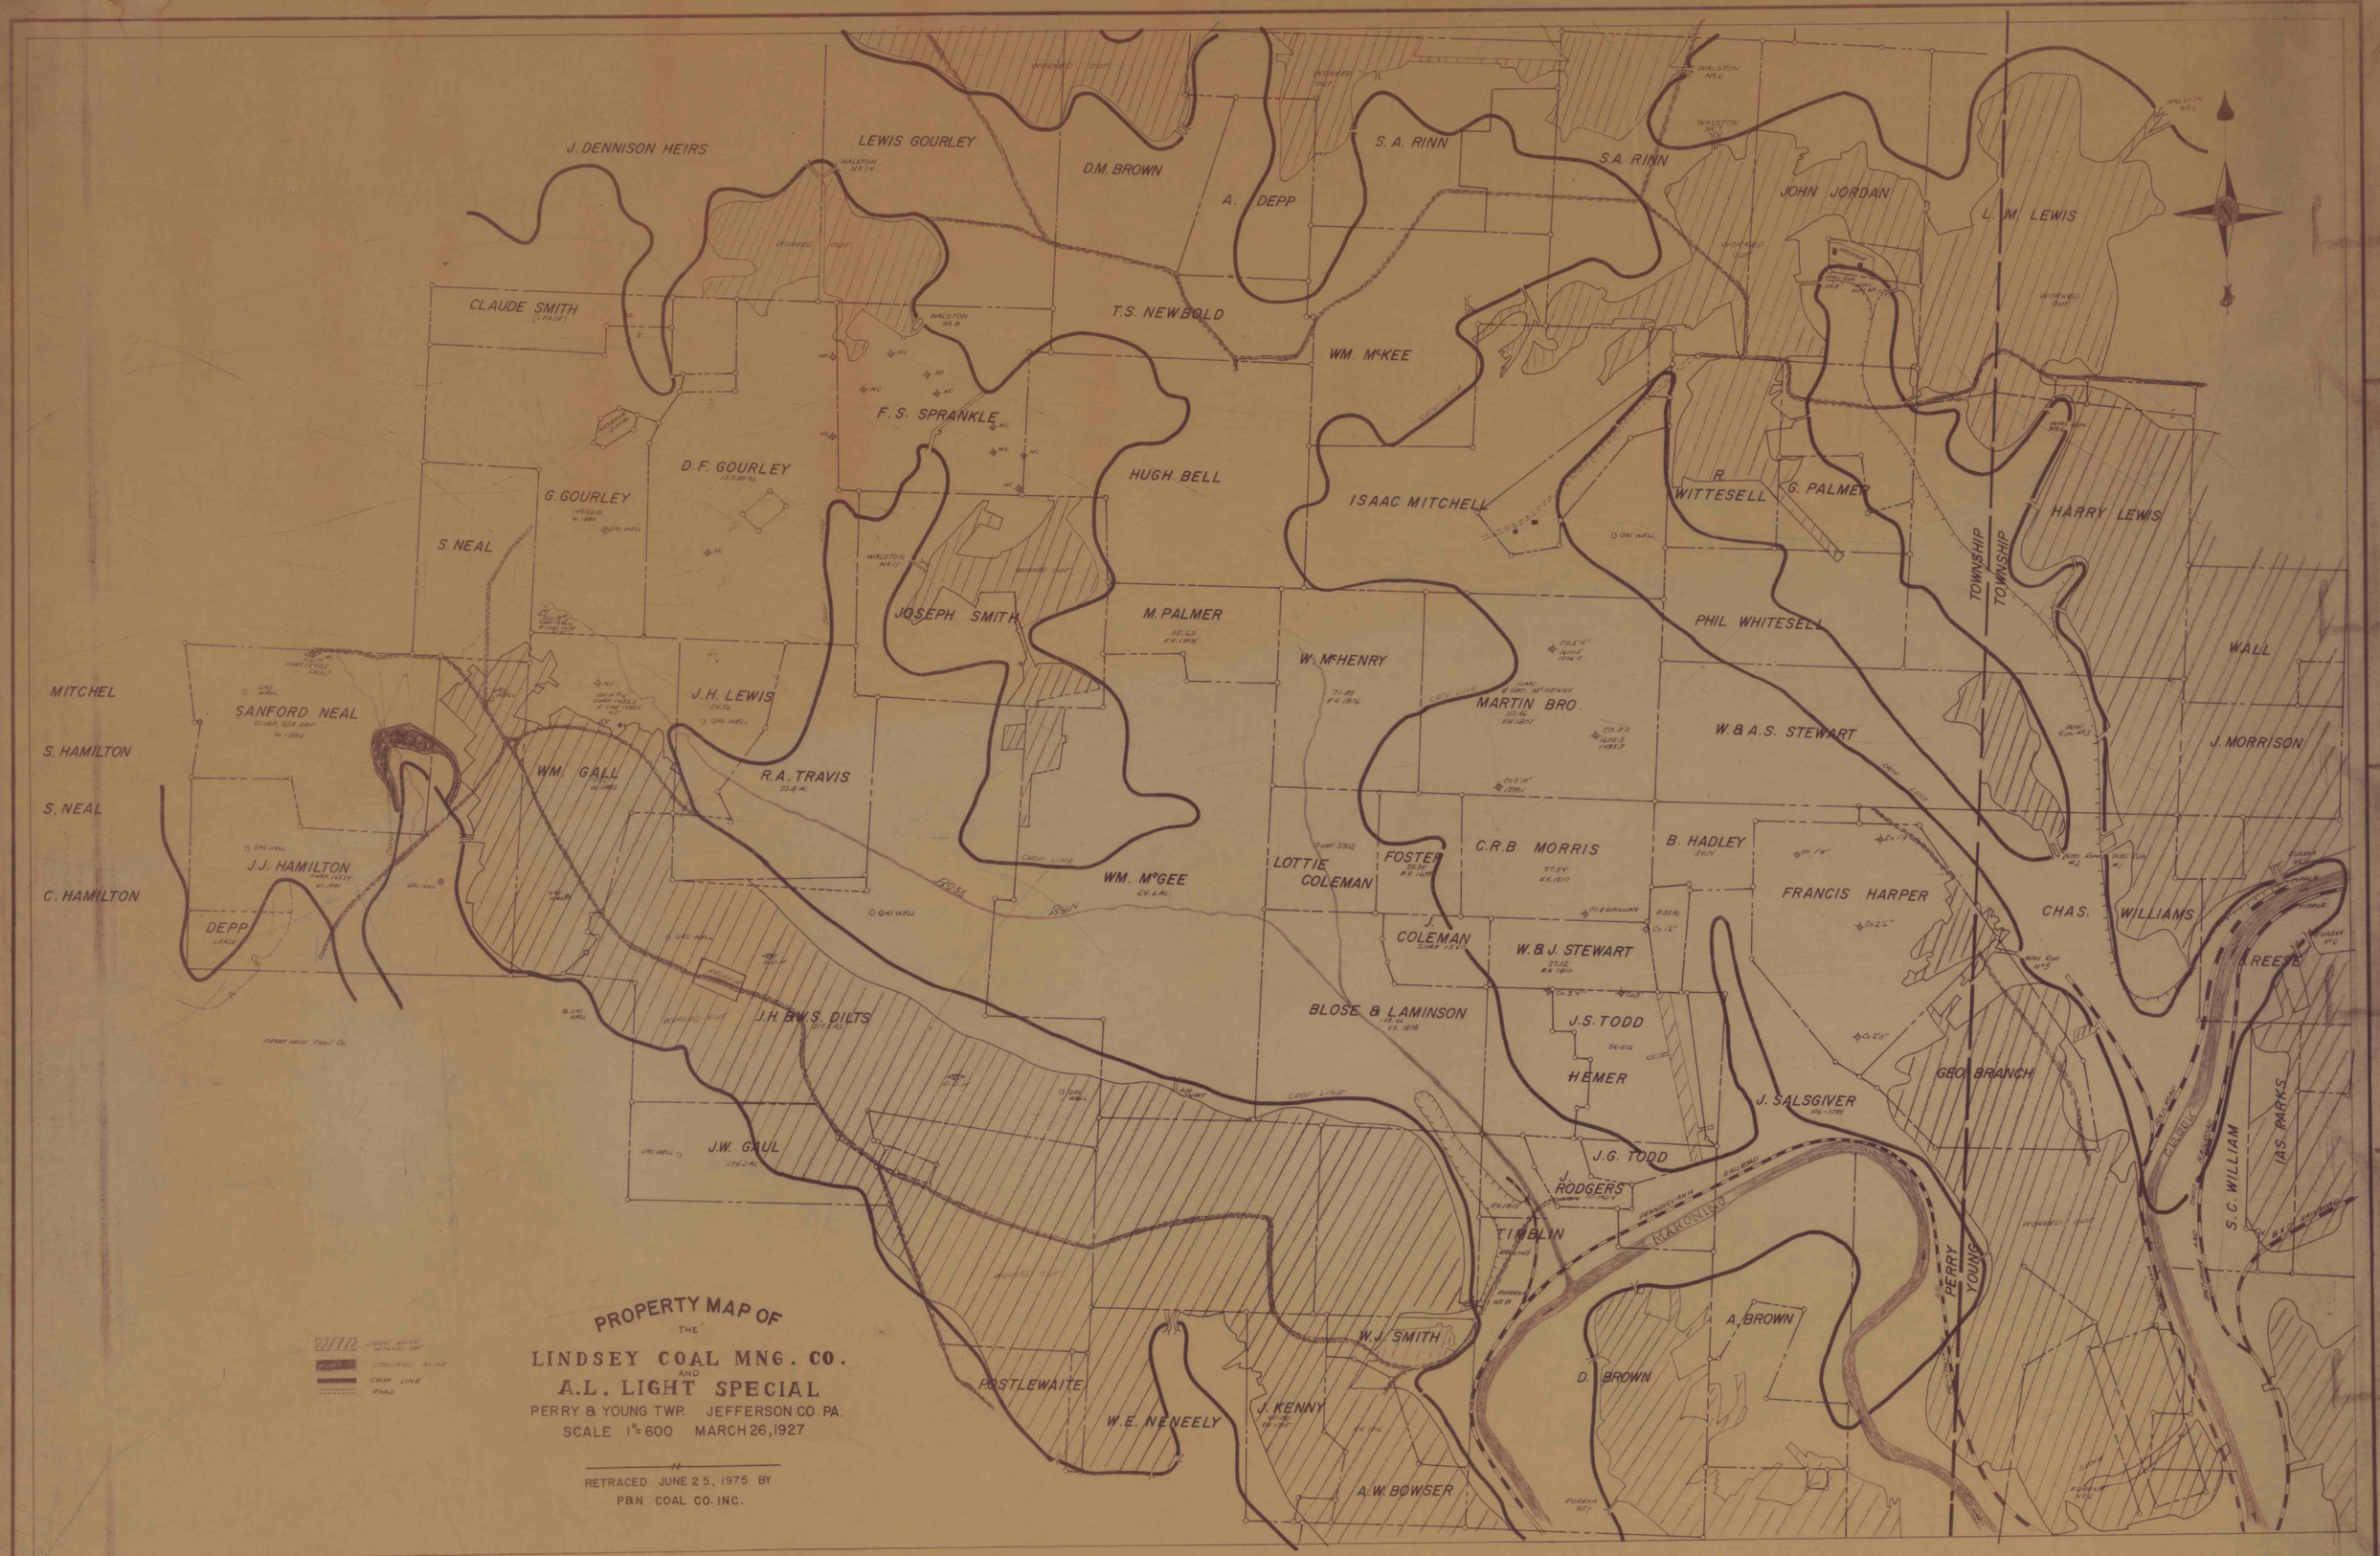

J. DENNISON HEIRS
LEWIS GOURLEY
D.M. BROWN
A. DEPP
S.A. RINN
S.A. RINN
JOHN JORDAN
L.M. LEWIS
CLAUDE SMITH (LEASE)
T.S. NEWBOLD
WM. McKEE
F.S. SPRANKLE
D.F. GOURLEY
G. GOURLEY
S. NEAL
HUGH BELL
ISAAC MITCHELL
R. WITTESELL
G. PALMER
HARRY LEWIS
TOWNSHIP
TOWNSHIP
JOSEPH SMITH
M. PALMER
PHIL WHITESELL
WALL
MITCHEL
S. HAMILTON
S. NEAL
C. HAMILTON
SANFORD NEAL
J.H. LEWIS
W. McHENRY
MARTIN BRO.
W. & A.S. STEWART
J. MORRISON
WM. GALL
R.A. TRAVIS
J.J. HAMILTON
DEPP
WM. McGEE
LOTTIE COLEMAN
FOSTER
C.R.B MORRIS
B. HADLEY
FRANCIS HARPER
CHAS. WILLIAMS
J. COLEMAN
W. & J. STEWART
REESE
BLOSE & LAMINSON
J.S. TODD
HEMER
GEO. BRANCH
J. SALSGIVER
J.H. & W.S. DILTS
J.W. GAUL
J.G. TODD
J. RODGERS
TIMBLIN
S.C. WILLIAM
JAS. PARKS
PERRY YOUNG
A. BROWN
D. BROWN
W.J. SMITH
POSTLEWAITE
W.E. NENEELY
J. KENNY
A.W. BOWSER
PERRY MILLS Coal Co.
WORKED OUT
STRIPPED MINE
CROP LINE
ROAD
PROPERTY MAP OF
THE
LINDSEY COAL MNG. CO.
AND
A.L. LIGHT SPECIAL
PERRY & YOUNG TWP. JEFFERSON CO. PA.
SCALE 1" = 600 MARCH 26, 1927
RETRACED JUNE 25, 1975 BY
P&N COAL CO. INC.