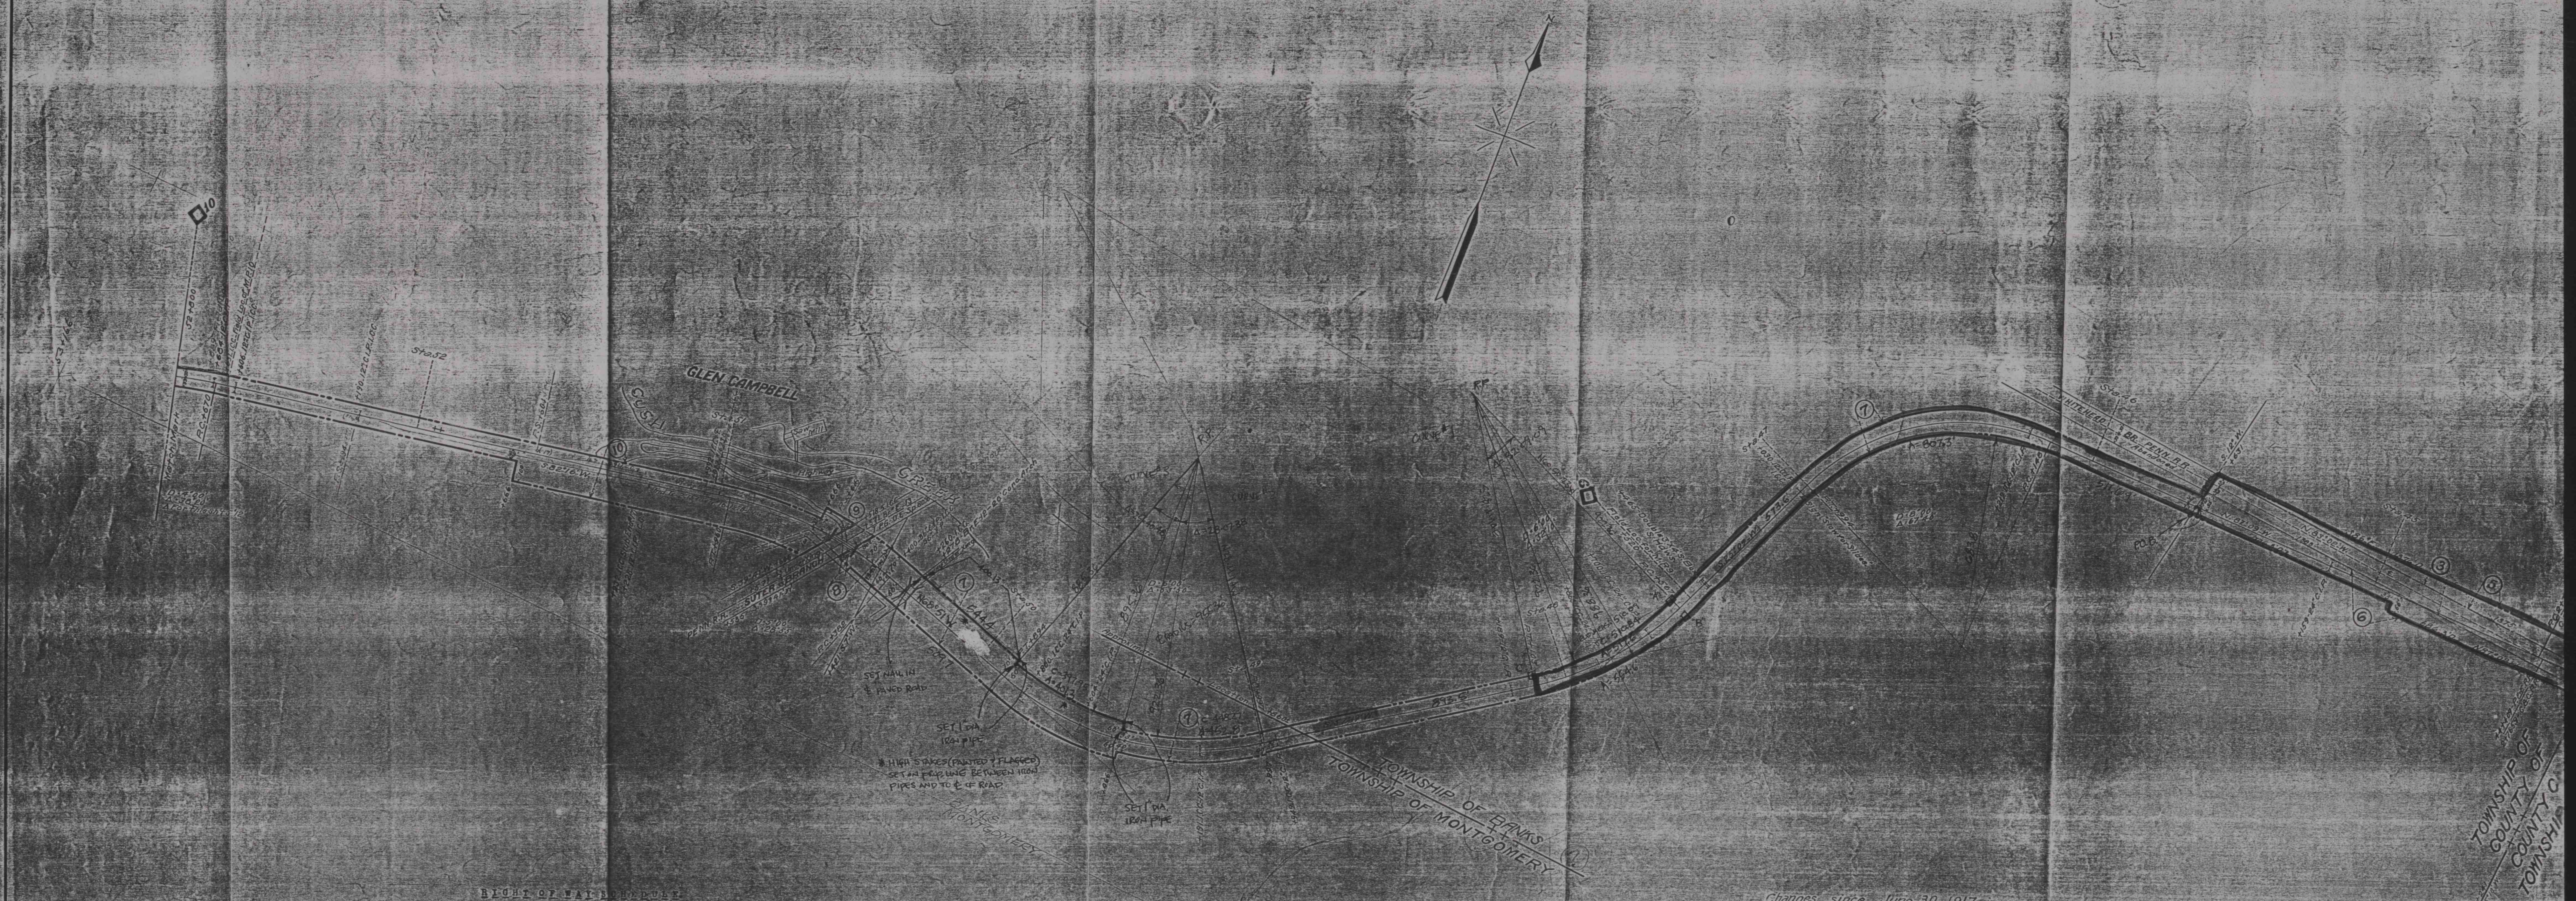

## RIGHT OF WAY SCHEDULE.

COUNTY OF CLEARFIELD
COUNTY OF INDIANA

TOWNSHIP OF BURNSIDE
TOWNSHIP OF BANKS
TOWNSHIP OF MONTGOMERY

STATE OF PENNSYLVANIA

| Number Serial | Number Custodian | Grantor | Grantee | Date | Conveyance | Record | Covenants & Remarks | Areas Acres | Areas Sq. Ft. |
|---|---|---|---|---|---|---|---|---|---|
| 1 | 32 | James Passmore & W. | P. & E. R. R. Co. | 12-14-1900 | War. Deed | 113-367 | | | 33,132 |
| 2 | 33 | Mary Gardner, et al. | P. & E. R. R. Co. | 11-13-1895 | War. Deed | 92-235 | | 2.61 | |
| 3 | | Cambria & Clearfield R.R.Co. | P. & E. R. R. Co. | 8--1-1898 | Agreement | [illegible] | Agreement to convey lands. | 3.05 | |
| 4 | 33½ | Mary Gardner, et al. | P. & E. R. R. Co. | 11-13-1895 | War. Deed | [illegible] | | | 13,910 |
| 5 | 1 | John W. Clark & W. | P. & E. R. R. Co. | 3--3-1896 | War. Deed | [illegible] | | 1.02 | |
| 6 | 1 | John W. Clark & W. | P. & E. R. R. Co. | 3--3-1896 | War. Deed | 187 | | 1.70 | |
| 7 | 2 | Otis W. White, et al. | P. & E. R. R. Co. | 9--1-1902 | War. Deed | 24 | | 8.63 | |
| 8 | | No paper title found | | | | | *See Note. Has title to this parcel by adverse possession. | | 14,300 |
| 9 | | Cambria & Clearfield R.R.Co. | P. & E. R. R. Co. | 3-27-1895 | Agree[illegible] | | Right to cross above grade of the Suter Branch. Penn.R.R. King's office file #3042. | | |
| 10 | | No paper title found. | | | | | See Note. Has title to this parcel by adverse possession. | 4.94 | |

* Note:
Occupied with owner's consent, carrier having filed bond to cover cost of property pending final agreement as to price.

V140
5

R. of W. Indicated

R. of W. Map & Schedule checked
Improvements checked
Correct B.W. [illegible] -21

VS 1400 LC 2360 MP 8.0-10.0

Changes since June 30, 1917 in
RIGHT OF WAY SCHEDULE

COUNTY OF INDIANA
TOWNSHIP OF BANKS BOROUGH OF GLEN CAMPBELL
STATE OF PENNSYLVANIA

| A.F.E. | BV | Numbers Serial | Numbers Custodian | Grantor | Grantee | Date | Conveyance | Record | Covenants & Remarks | | Areas Acres | Areas Sq. Ft. |
|---|---|---|---|---|---|---|---|---|---|---|---|---|
| 62571 | E43-525 | 8 | 3 | Richard W. Watson & Wife | Beech Creek Ext. R. R. Co. | 2-3-1942 | Warranty Deed | 318-554 | One-half interest-parcels 8 & 10 and parcel 1 on map #6 | | 0.319 | |
| do | do | 10 | 3 | do | do | do | do | do | do | do | 5.249 | |
| do | do | 1 (Sh. #6) | 3 | do | do | do | do | do | do | do | | |
| do | do | 8 | 3½ | Martha S. Wilmoth et al. heirs of John W. Clark | do | 2-25-1942 | do | 318-330 | do | do | 0.319 | |
| do | do | 10 | 3½ | do | do | do | do | do | do | do | 5.249 | |
| do | do | 1 (Sh. #6) | 3½ | do | do | do | do | do | do | do | | |