


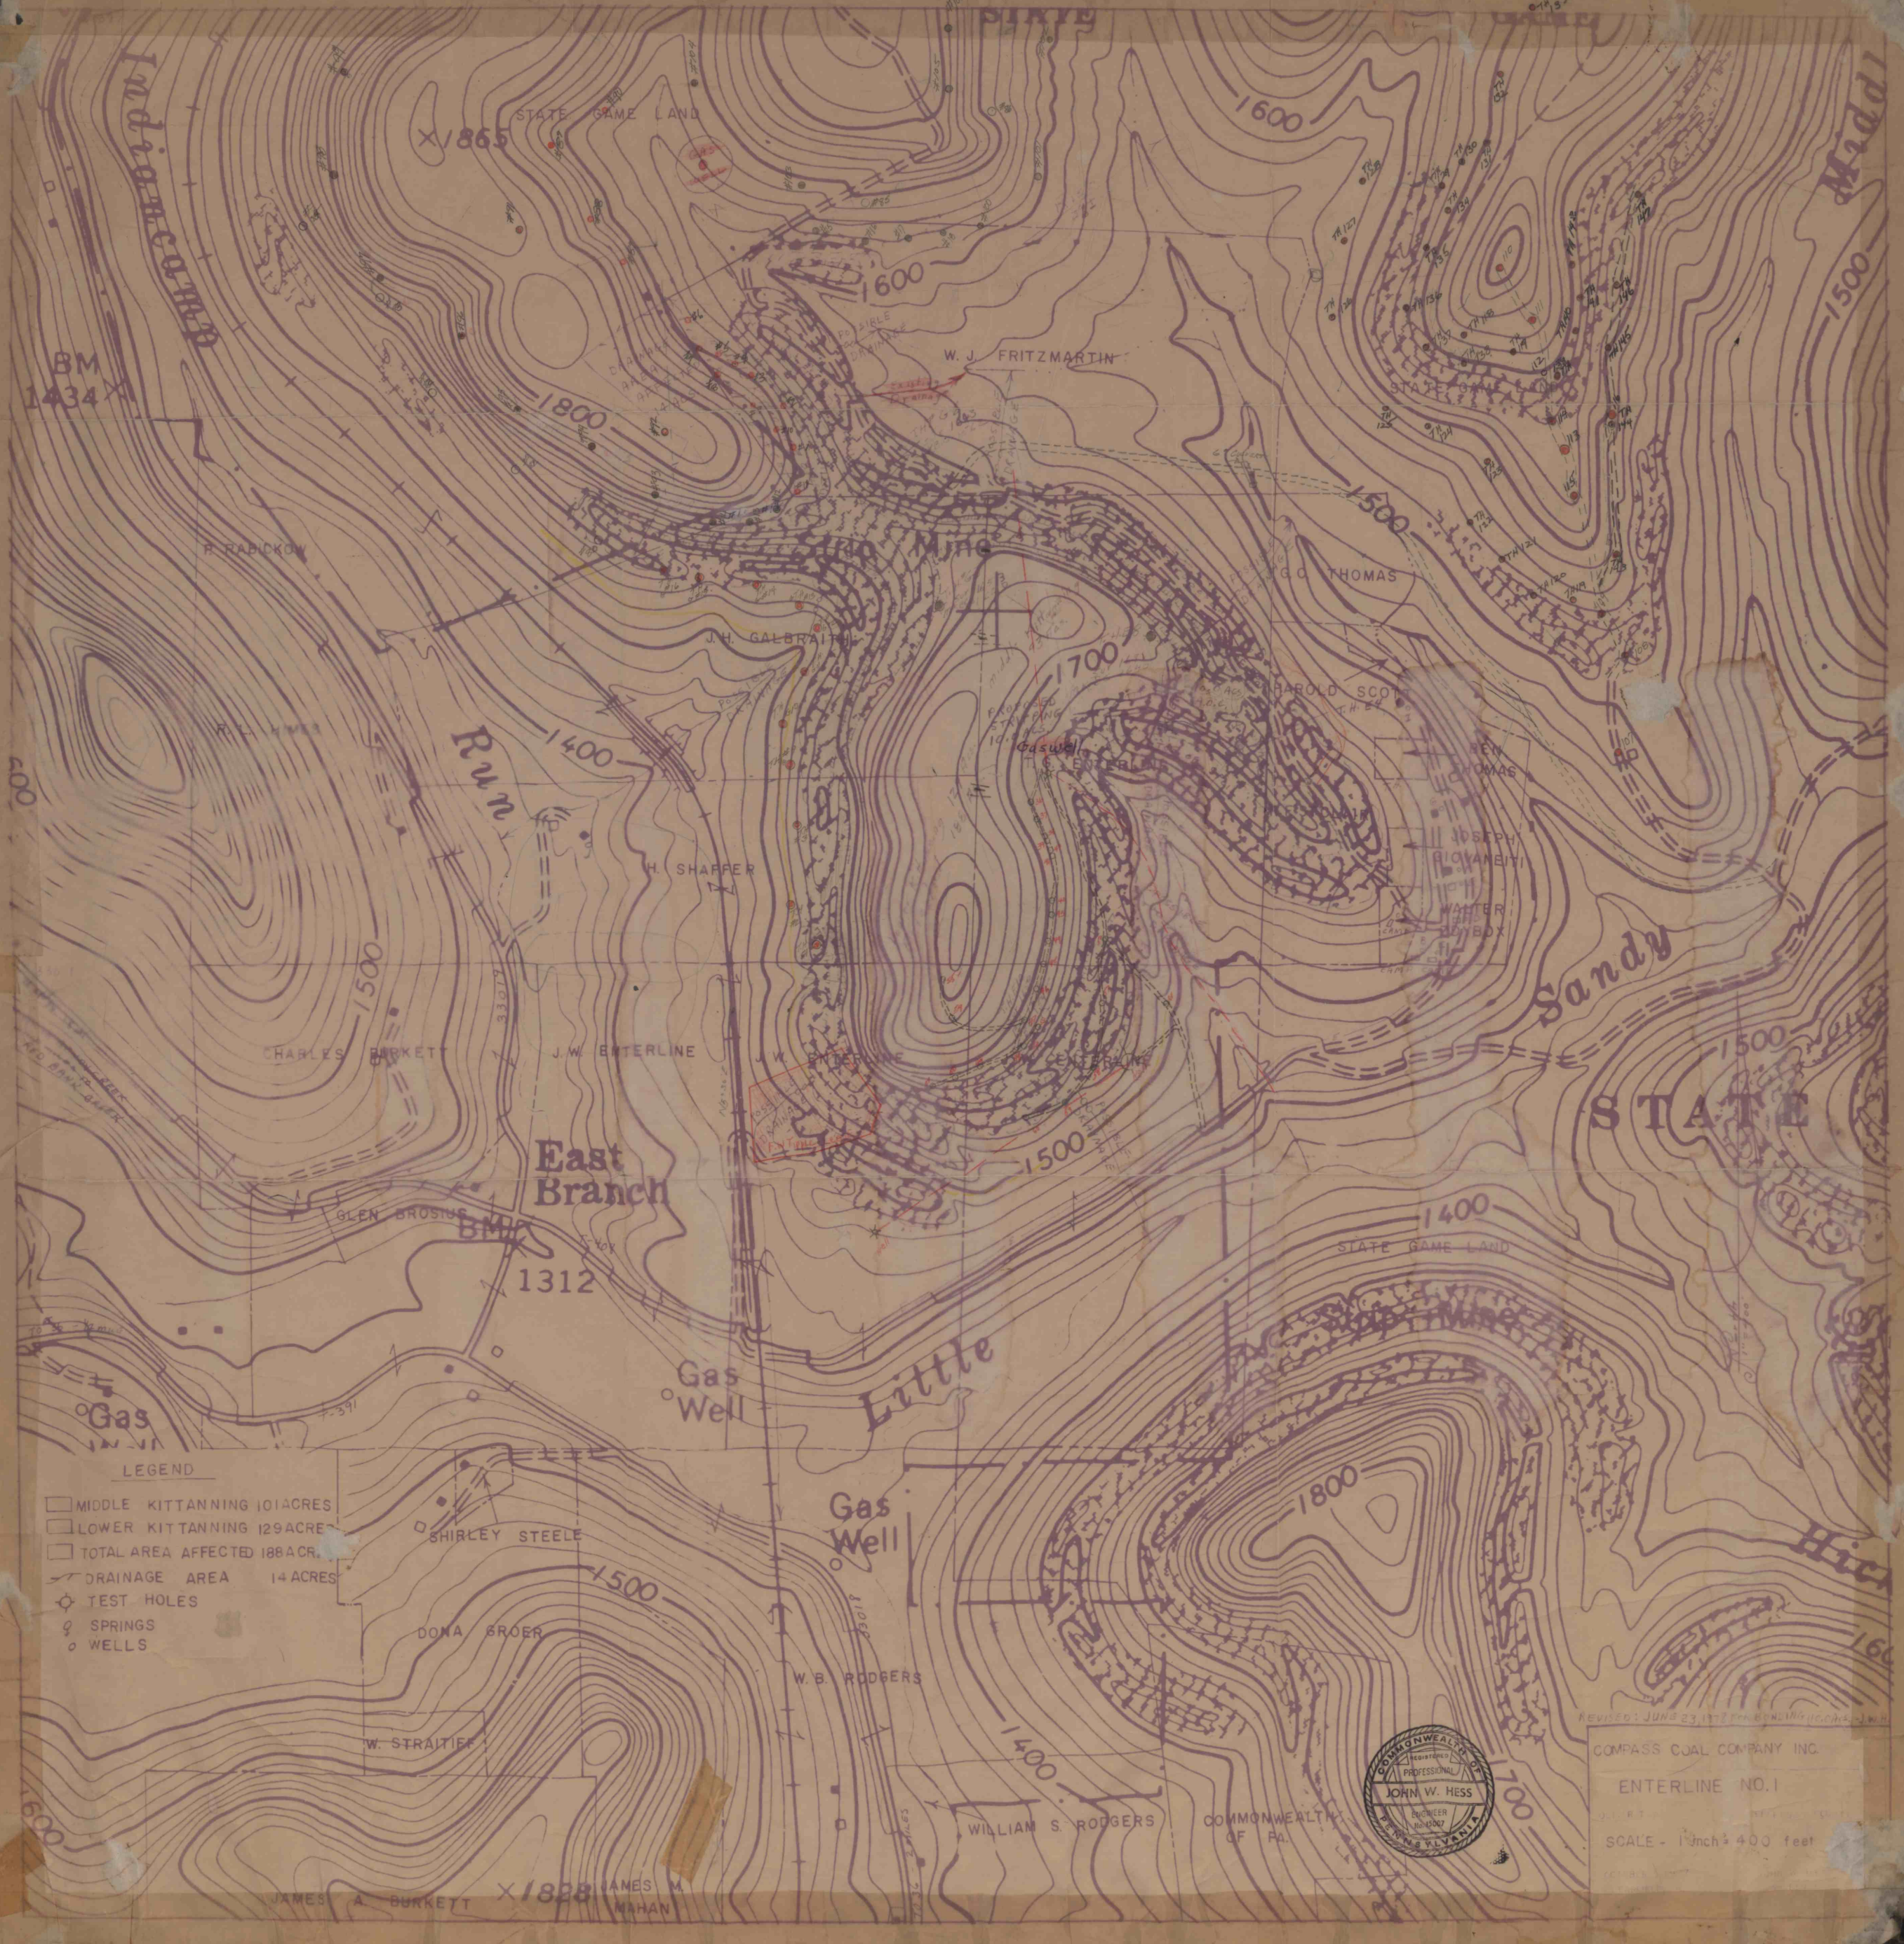

LEGEND

- MIDDLE KITTANNING 101 ACRES
- LOWER KITTANNING 129 ACRES
- TOTAL AREA AFFECTED 188 ACRES
- DRAINAGE AREA 14 ACRES
- TEST HOLES
- SPRINGS
- WELLS



COMPASS COAL COMPANY INC.

ENTERLINE NO. 1

SCALE - 1 inch = 400 feet