


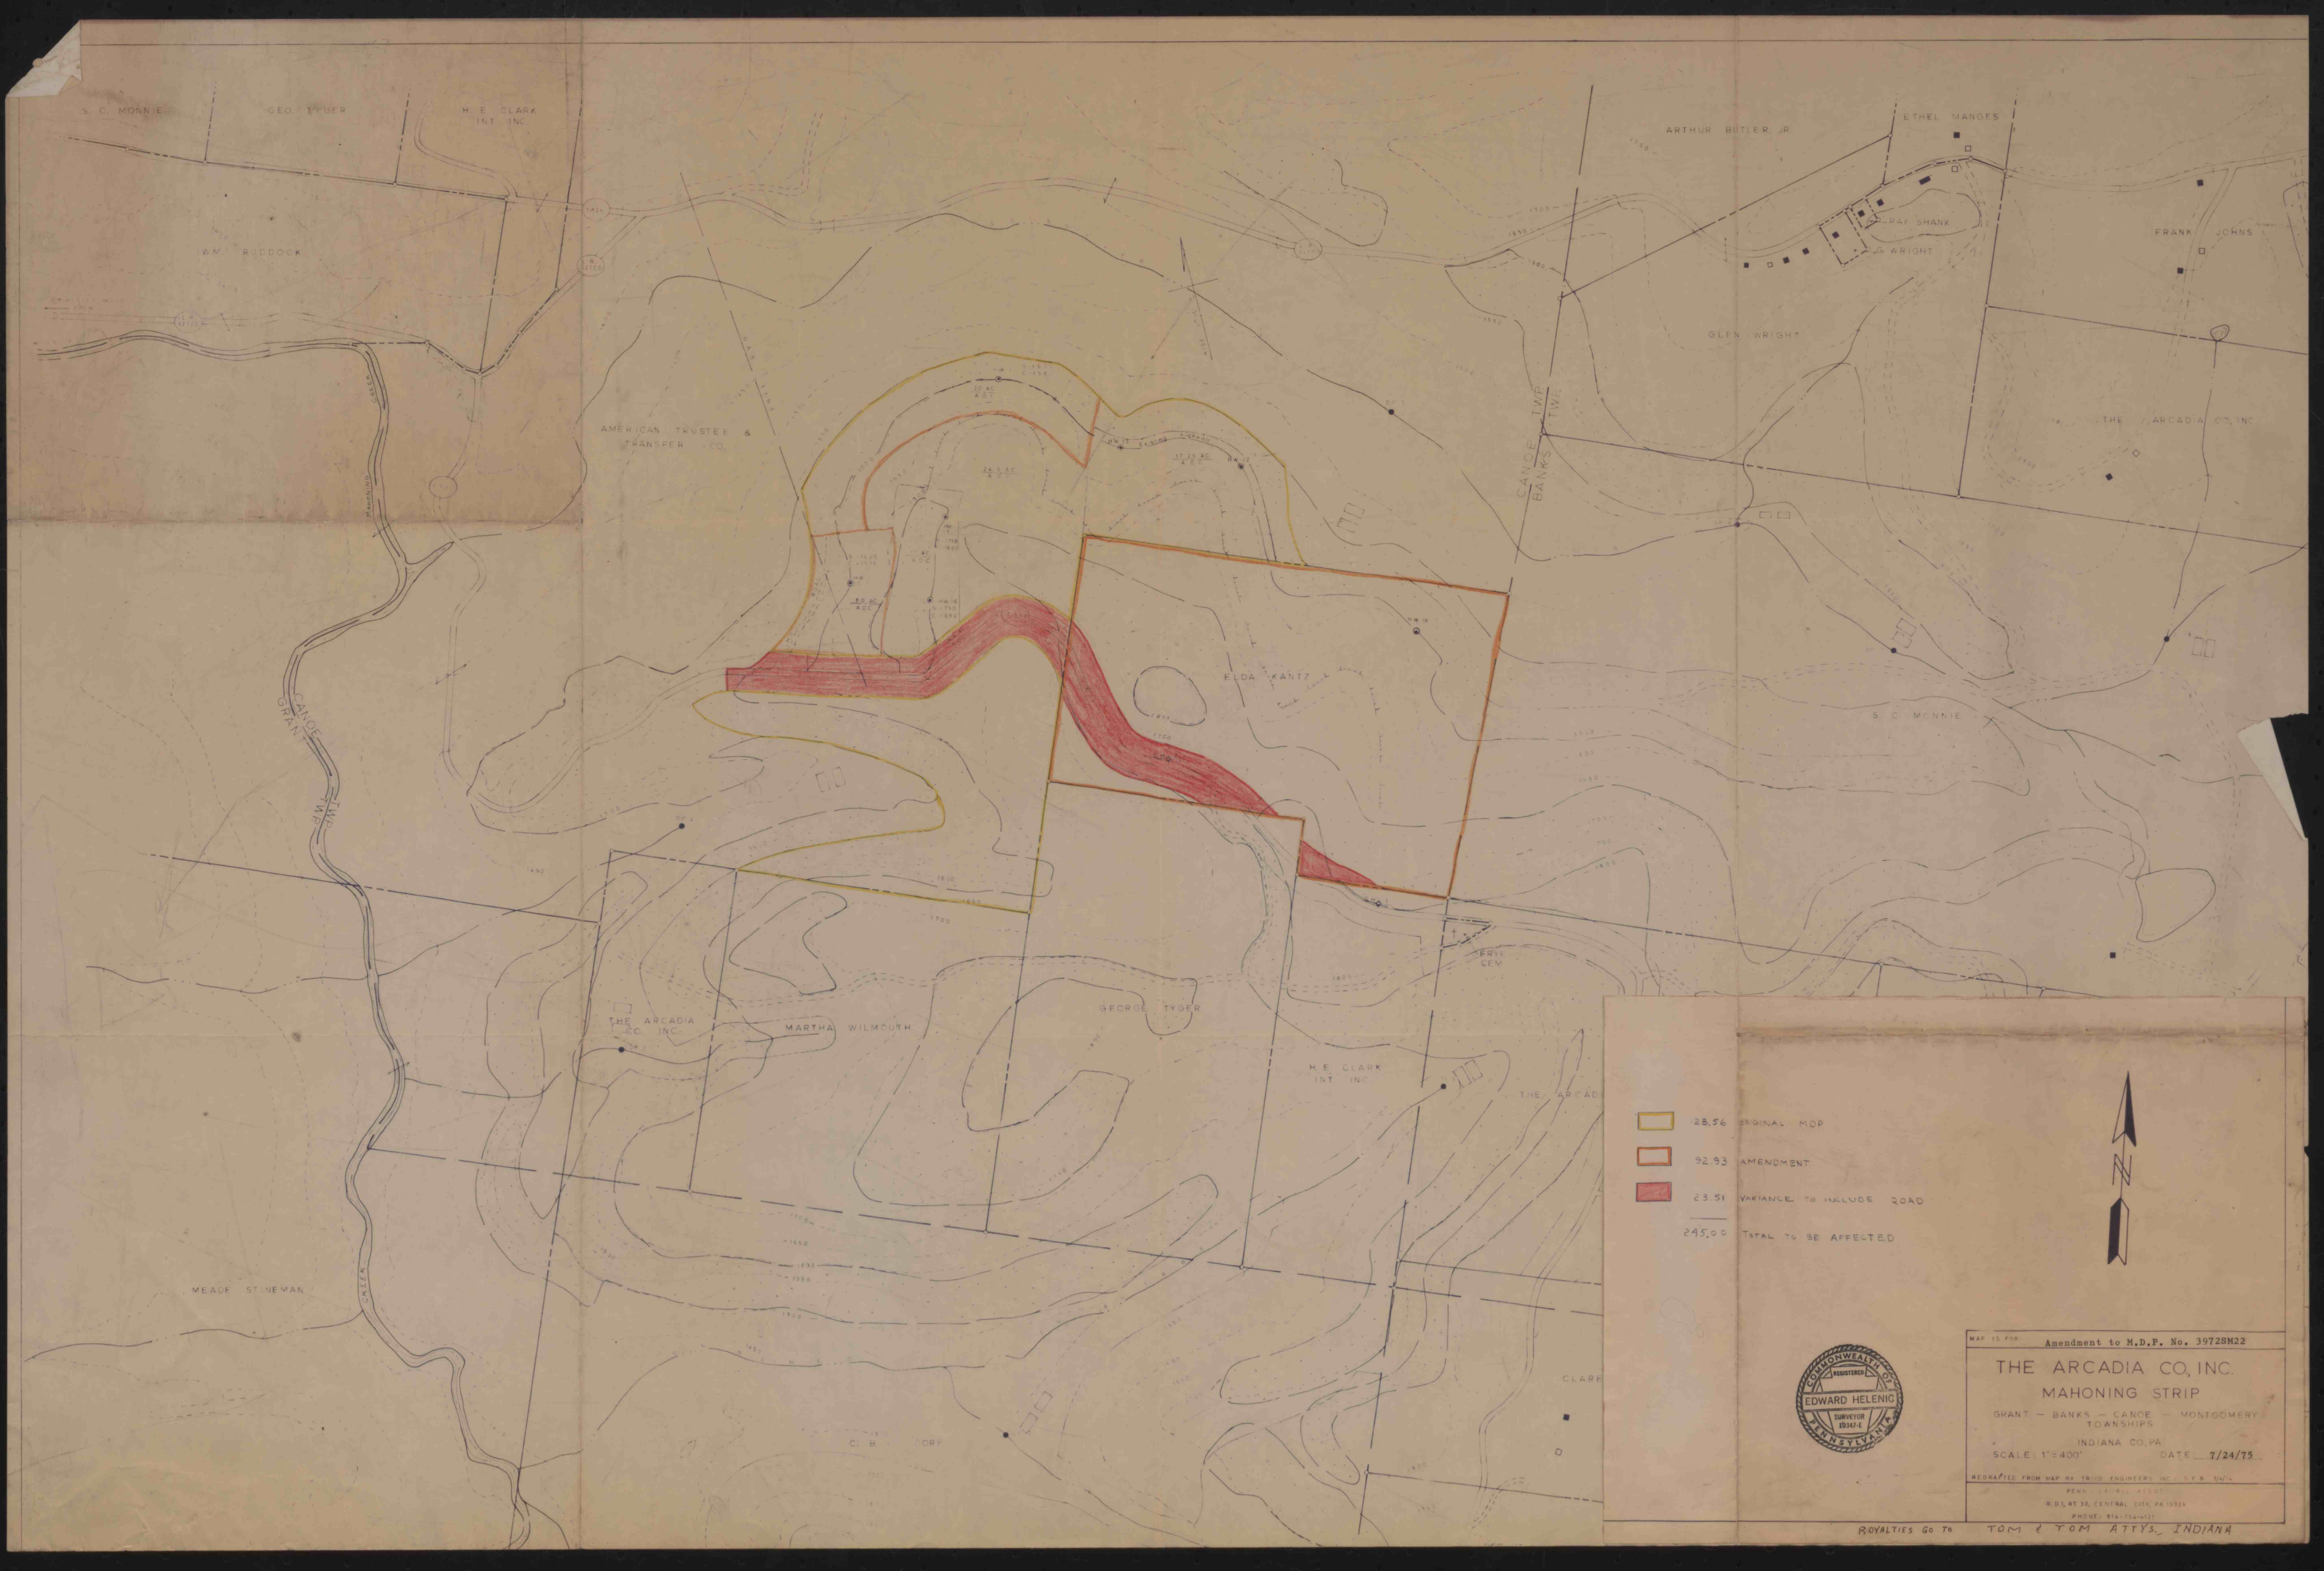

- 28.56 ORIGINAL MDP
- 92.93 AMENDMENT
- 23.51 VARIANCE TO INCLUDE ROAD
- 245.00 TOTAL TO BE AFFECTED



MAP IS FOR: Amendment to M.D.P. No. 3972SM22

THE ARCADIA CO, INC.
MAHONING STRIP

GRANT — BANKS — CANOE — MONTGOMERY
TOWNSHIPS

INDIANA CO, PA
SCALE: 1" = 400' DATE: 7/24/75

REDRAFTED FROM MAP BY TRICO ENGINEERS INC. S.F.B. 10/4/74
PENN. LAND CO. 15502
R.D. 1, RT. 30, CENTRAL CITY, PA 15924
PHONE: 814-754-4121

ROYALTIES GO TO TOM & TOM ATTYS. INDIANA