


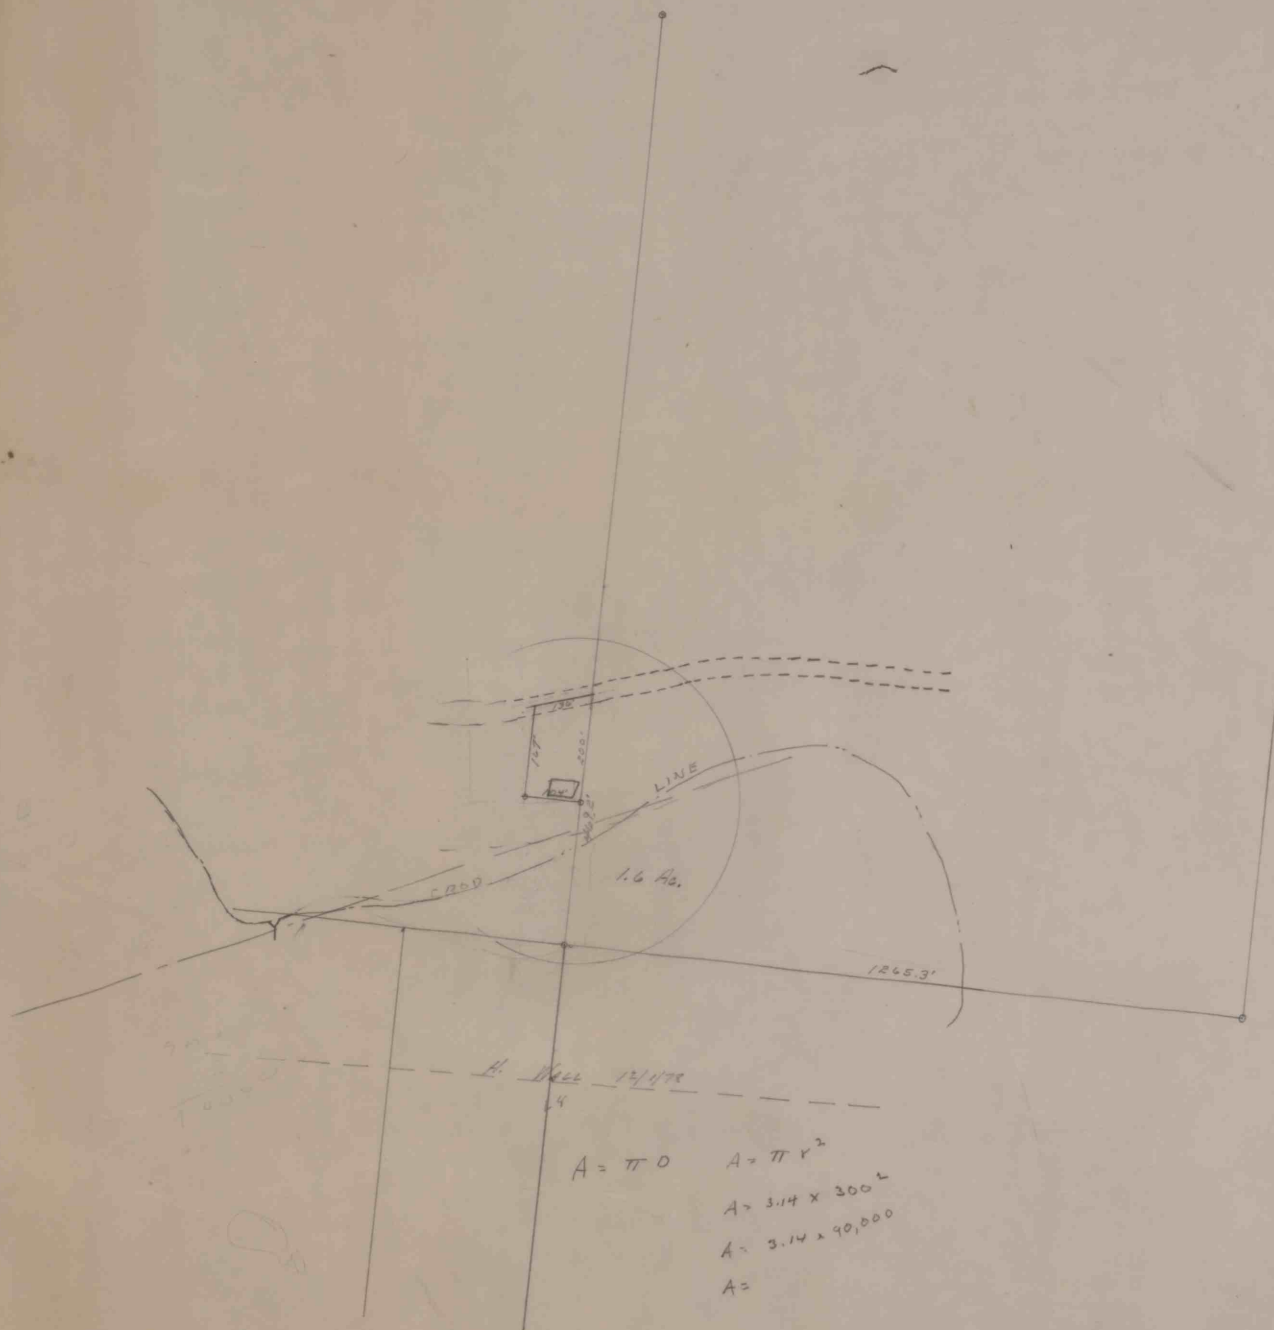

$$\begin{aligned}
 A &= \pi r^2 \\
 A &= 3.14 \times 300^2 \\
 A &= 3.14 \times 90,000 \\
 A &=
 \end{aligned}$$

