

BOROUGH OF PUNXSUTAWNEY


STATE GAME LANDS No. 105

STATE
GAME
LANDS
No. 105

C. H. BOWERS

ROCHESTER
AND
PITTSBURGH
COAL CO.

G. F. KELLER

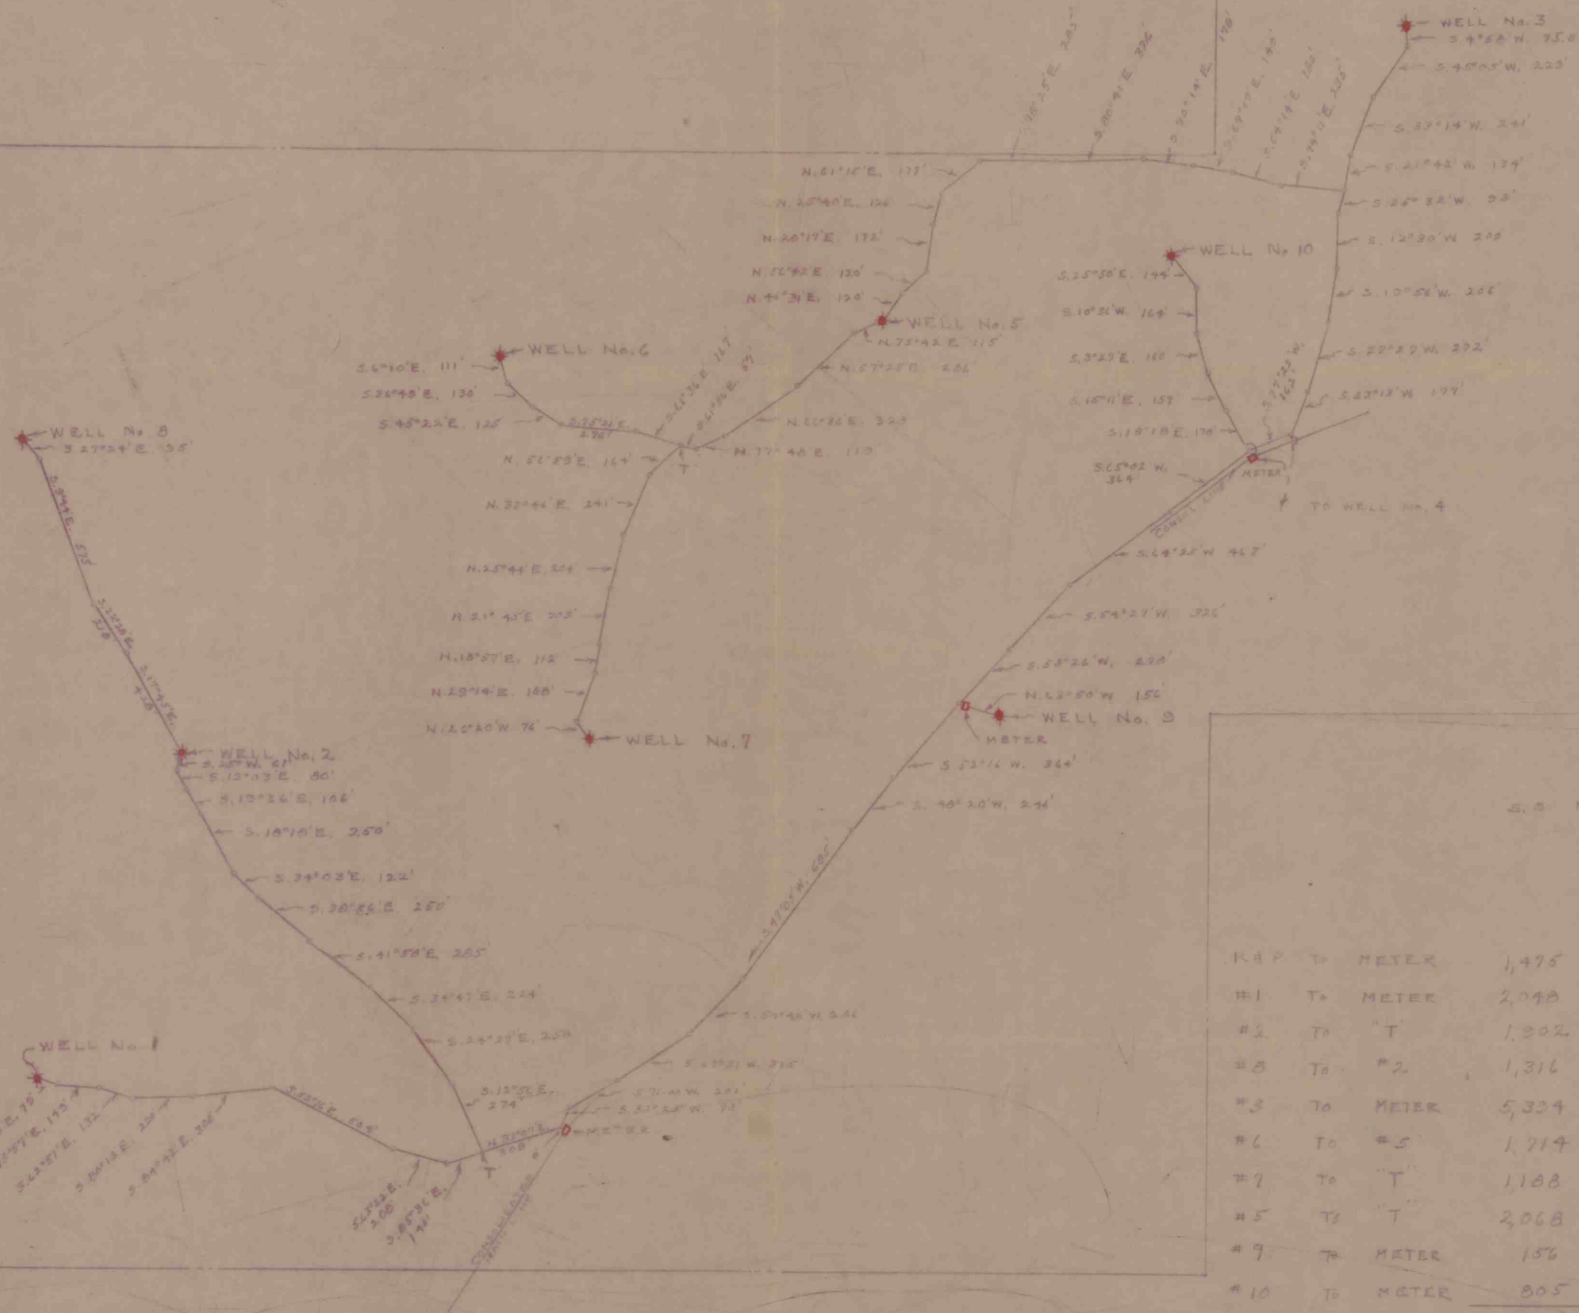

#10	TO METER	805	

TOTAL PIPELINE LENGTH 18,066 FT.

MID EAST OIL CO.
PIPELINE PLAN
GASKILL TWP. JEFFERSON CO.
R. B. SHANNON & ASSOCIATES, INDIANA, PA.
DRAWN BY: H.P. DATE: APRIL 1961
SCALE: 1"=400' DRAWING NO. 7057-F