


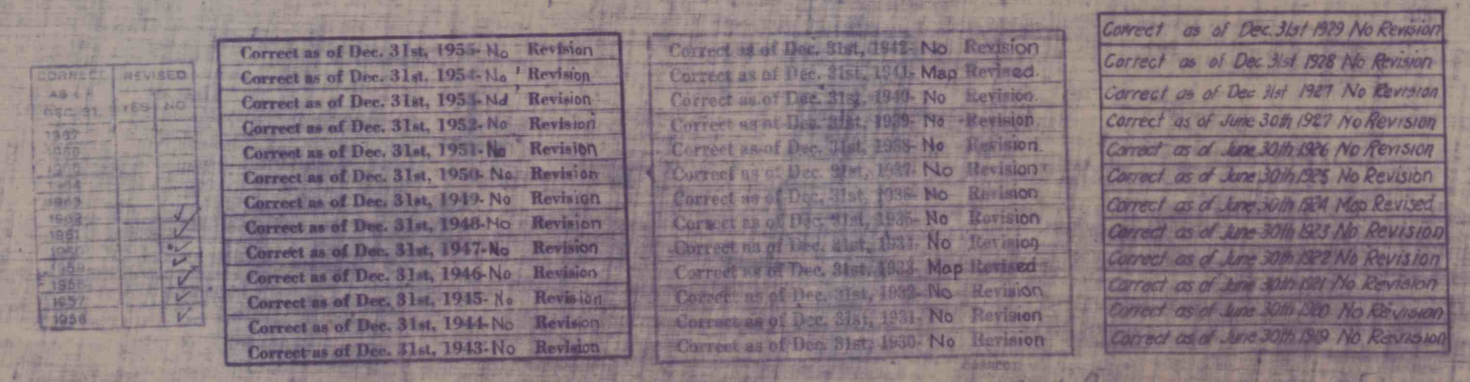

GASKILL TWP, JEFFERSON CO, PA