


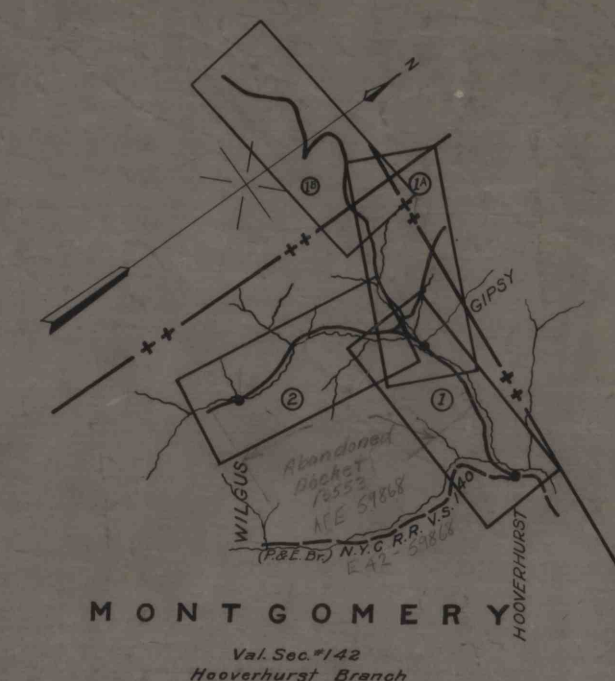

KEY LOCATION MAP
VALUATION SECTION 142
SCALE 1" = 5 MILES

LEGEND
 B. & O. R. R. Co.
 P. & N. W. R. R. Co.
 P. & E. R. R. Co.
 N. Y. C. & H. R. R. Co.
 P. & E. R. R. Co.
 H. & S. W. R. R. Co.

RAILROAD OPERATION DISCONTINUED MAY 21, 1942
 Sta. 7+500 to End of Line
 ICC Docket No. 15853 Dated Mar 21, 1942
 Property retired on AFE 59863 E-42-25
 60353
 Land Transferred to Acct. 705 do E-42 24

Note:
 Unless otherwise scheduled, all highways were in existence at the time of the construction of the railroad and the right to cross the same, as well as easements and other rights by virtue of the General Railroad Law of the State of Pennsylvania, dated Feb. 19, 1849.
 A minimum required width of 10 ft. is indicated at crossings, where the underlying fee is not held by the carrier.

Note:
 Non-carrier lands were shown as designated or agreed to by the Bureau of Valuation, Land Division. The division line between non-carrier and adjoining carrier land is indicated by a heavy, broken line, thus

RIGHT OF WAY SCHEDULE

COUNTY OF INDIANA			TOWNSHIP OF MONTGOMERY			STATE OF PENNSYLVANIA		
Number	Order	Grantor	Grantee	Date	Conveyance	Record	Comments & Remarks	Area
1	101	N.L. Hoover & W.	H. & S. W. R. R. Co.	7-29-1902	Var. Deed	"B"-81-417	Reserving mineral rights. The carrier has title to this parcel by adverse possession.	1.64
1A		3d paper title found						7.04
2	111	N.L. Hoover & W.	H. & S. W. R. R. Co.	7-29-1902	Var. Deed	"B"-81-417	Reserving mineral rights.	6,930
3	112	N.L. Hoover & W.	H. & S. W. R. R. Co.	7-29-1902	Var. Deed	"B"-81-417	Reserving mineral rights.	2,450
4	106	N.L. Hoover & W.	H. & S. W. R. R. Co.	7-29-1902	Var. Deed	"B"-81-417	Reserving mineral rights.	2.13
5	107	N.L. Hoover & W.	H. & S. W. R. R. Co.	7-29-1902	Var. Deed	"B"-81-417	Reserving mineral rights.	1.89
6	102	N.L. Hoover & W.	H. & S. W. R. R. Co.	7-29-1902	Var. Deed	"B"-81-417	Reserving mineral rights.	1.96
7	110	N.L. Hoover & W.	H. & S. W. R. R. Co.	7-29-1902	Var. Deed	"B"-81-417	Reserving mineral rights.	1.80
8	108	N.L. Hoover & W.	H. & S. W. R. R. Co.	7-29-1902	Var. Deed	"B"-81-417	Reserving mineral rights.	1.77
9	113	Joseph H. Smith & W.	H. & S. W. R. R. Co.	2-1-1904	Var. Deed	"B"-82-388	Reserving mineral rights. Grantee to build one and maintain two crossings.	3.44

**RIGHT OF WAY AND TRACK MAP
BEECH CREEK EXTENSION RAILROAD**

Operated by
THE NEW YORK CENTRAL RAILROAD COMPANY
 as Lessee
HOOVERHURST BRANCH - PENNSYLVANIA DIVISION
 HOOVERHURST & GIPSY
 From Sta. 00+000 to Sta. 10+580
 1 in=200 ft. June 30th 1917
 Office of Valuation Engineer
 Grand Central Terminal New York N. Y.
 Revised to 12-31-55
 Portion Retired in Year 1942

V142
1

V142
1