


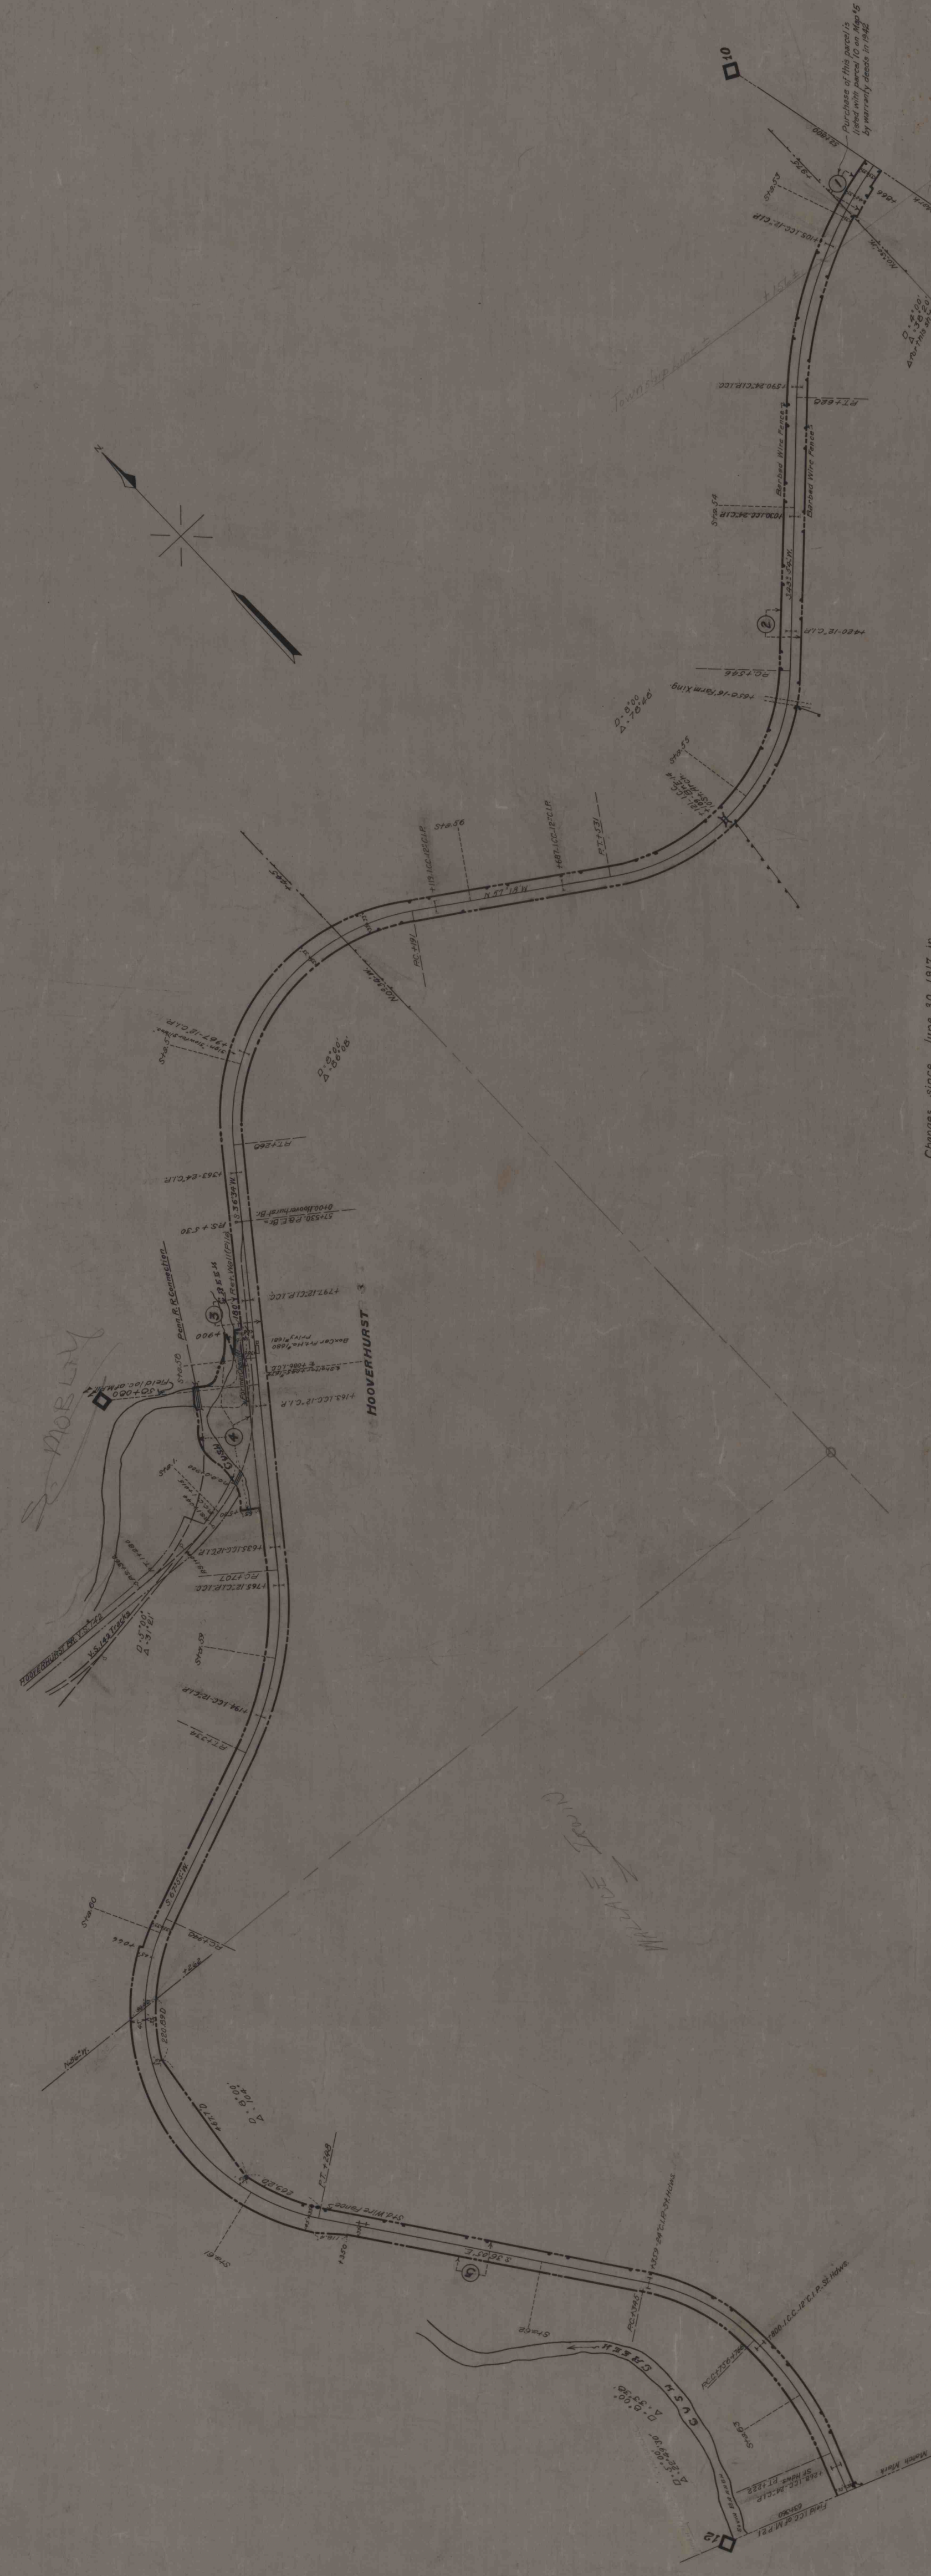

RIGHT OF WAY AND TRACK MAP
BEECH CREEK EXTENSION RAILROAD
Operated by
THE NEW YORK CENTRAL RAILROAD COMPANY
as Lessee
PITTSBURGH & EASTERN BRANCH - PENNSYLVANIA DIVISION
HOOVERHURST
From Sta. 52+800 to Sta. 83+360
1 in 200 ft. June 30th 1917
Official Publication Engineer
Revised 10-12-31-55

Changes since June 30, 1917 in
RIGHT OF WAY SCHEDULE

County of Indiana			State of Pennsylvania		
A.P.E.	Section	Number of Acres	Grantor	Grantee	Record
62571	E43-525	1	Richard W. Nelson & Wife	Beech Creek Ext. R.R. Co.	318-554
do	do	1	Martha S. Wilmoth and heirs of John W. Clark	do	2-25-1942
do	do	1	do	do	do

Covenants & Remarks:
{ One-half interest in parcel "1" and "2" in on Map "5"
{ Area included in area listed for parcel "5" on Map "5"
do.

RIGHT OF WAY SCHEDULE
TOWNSHIP OF MONTGOMERY

Number of Acres	Grantor	Date	Conveyance	Record	Covenants & Remarks	Acres

*Note:
Occupied with owner's consent, carrier having filed bond to cover cost of property pending final agreement as to price.


Attest:
Engineer

VS 1400 LC 2360 MP 10.0-12.0