


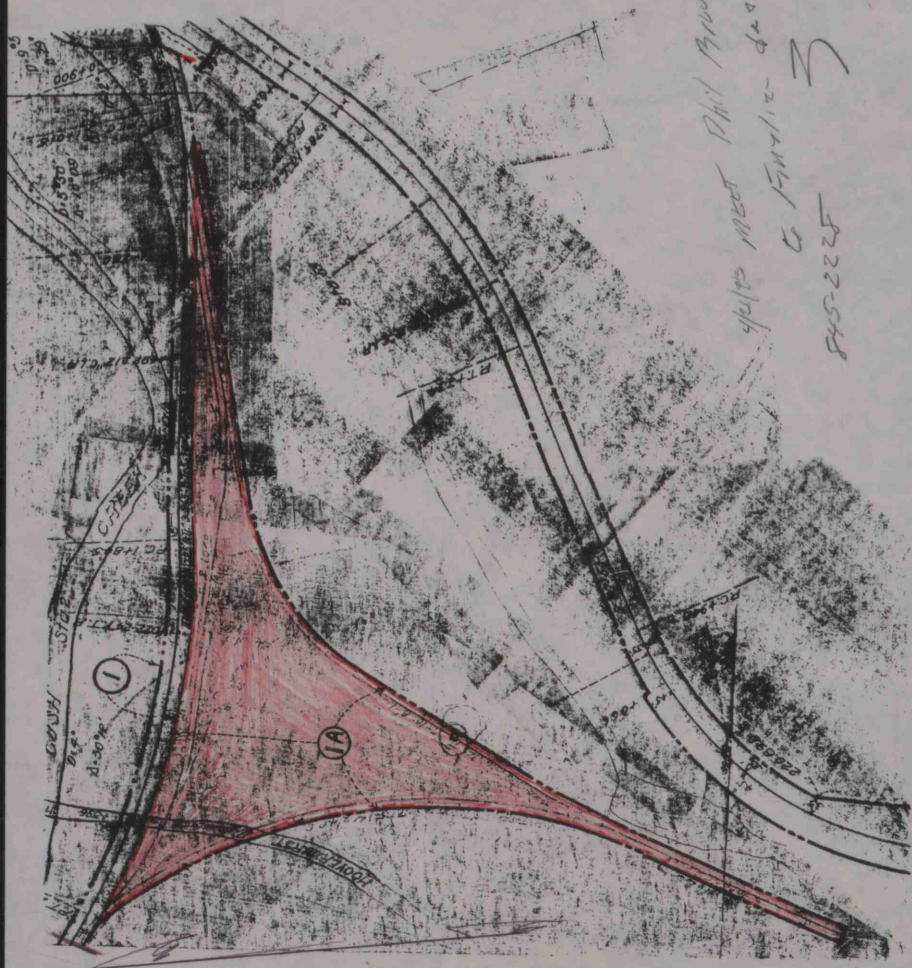

5222-SMS
to Finance dept
Phil Brown