


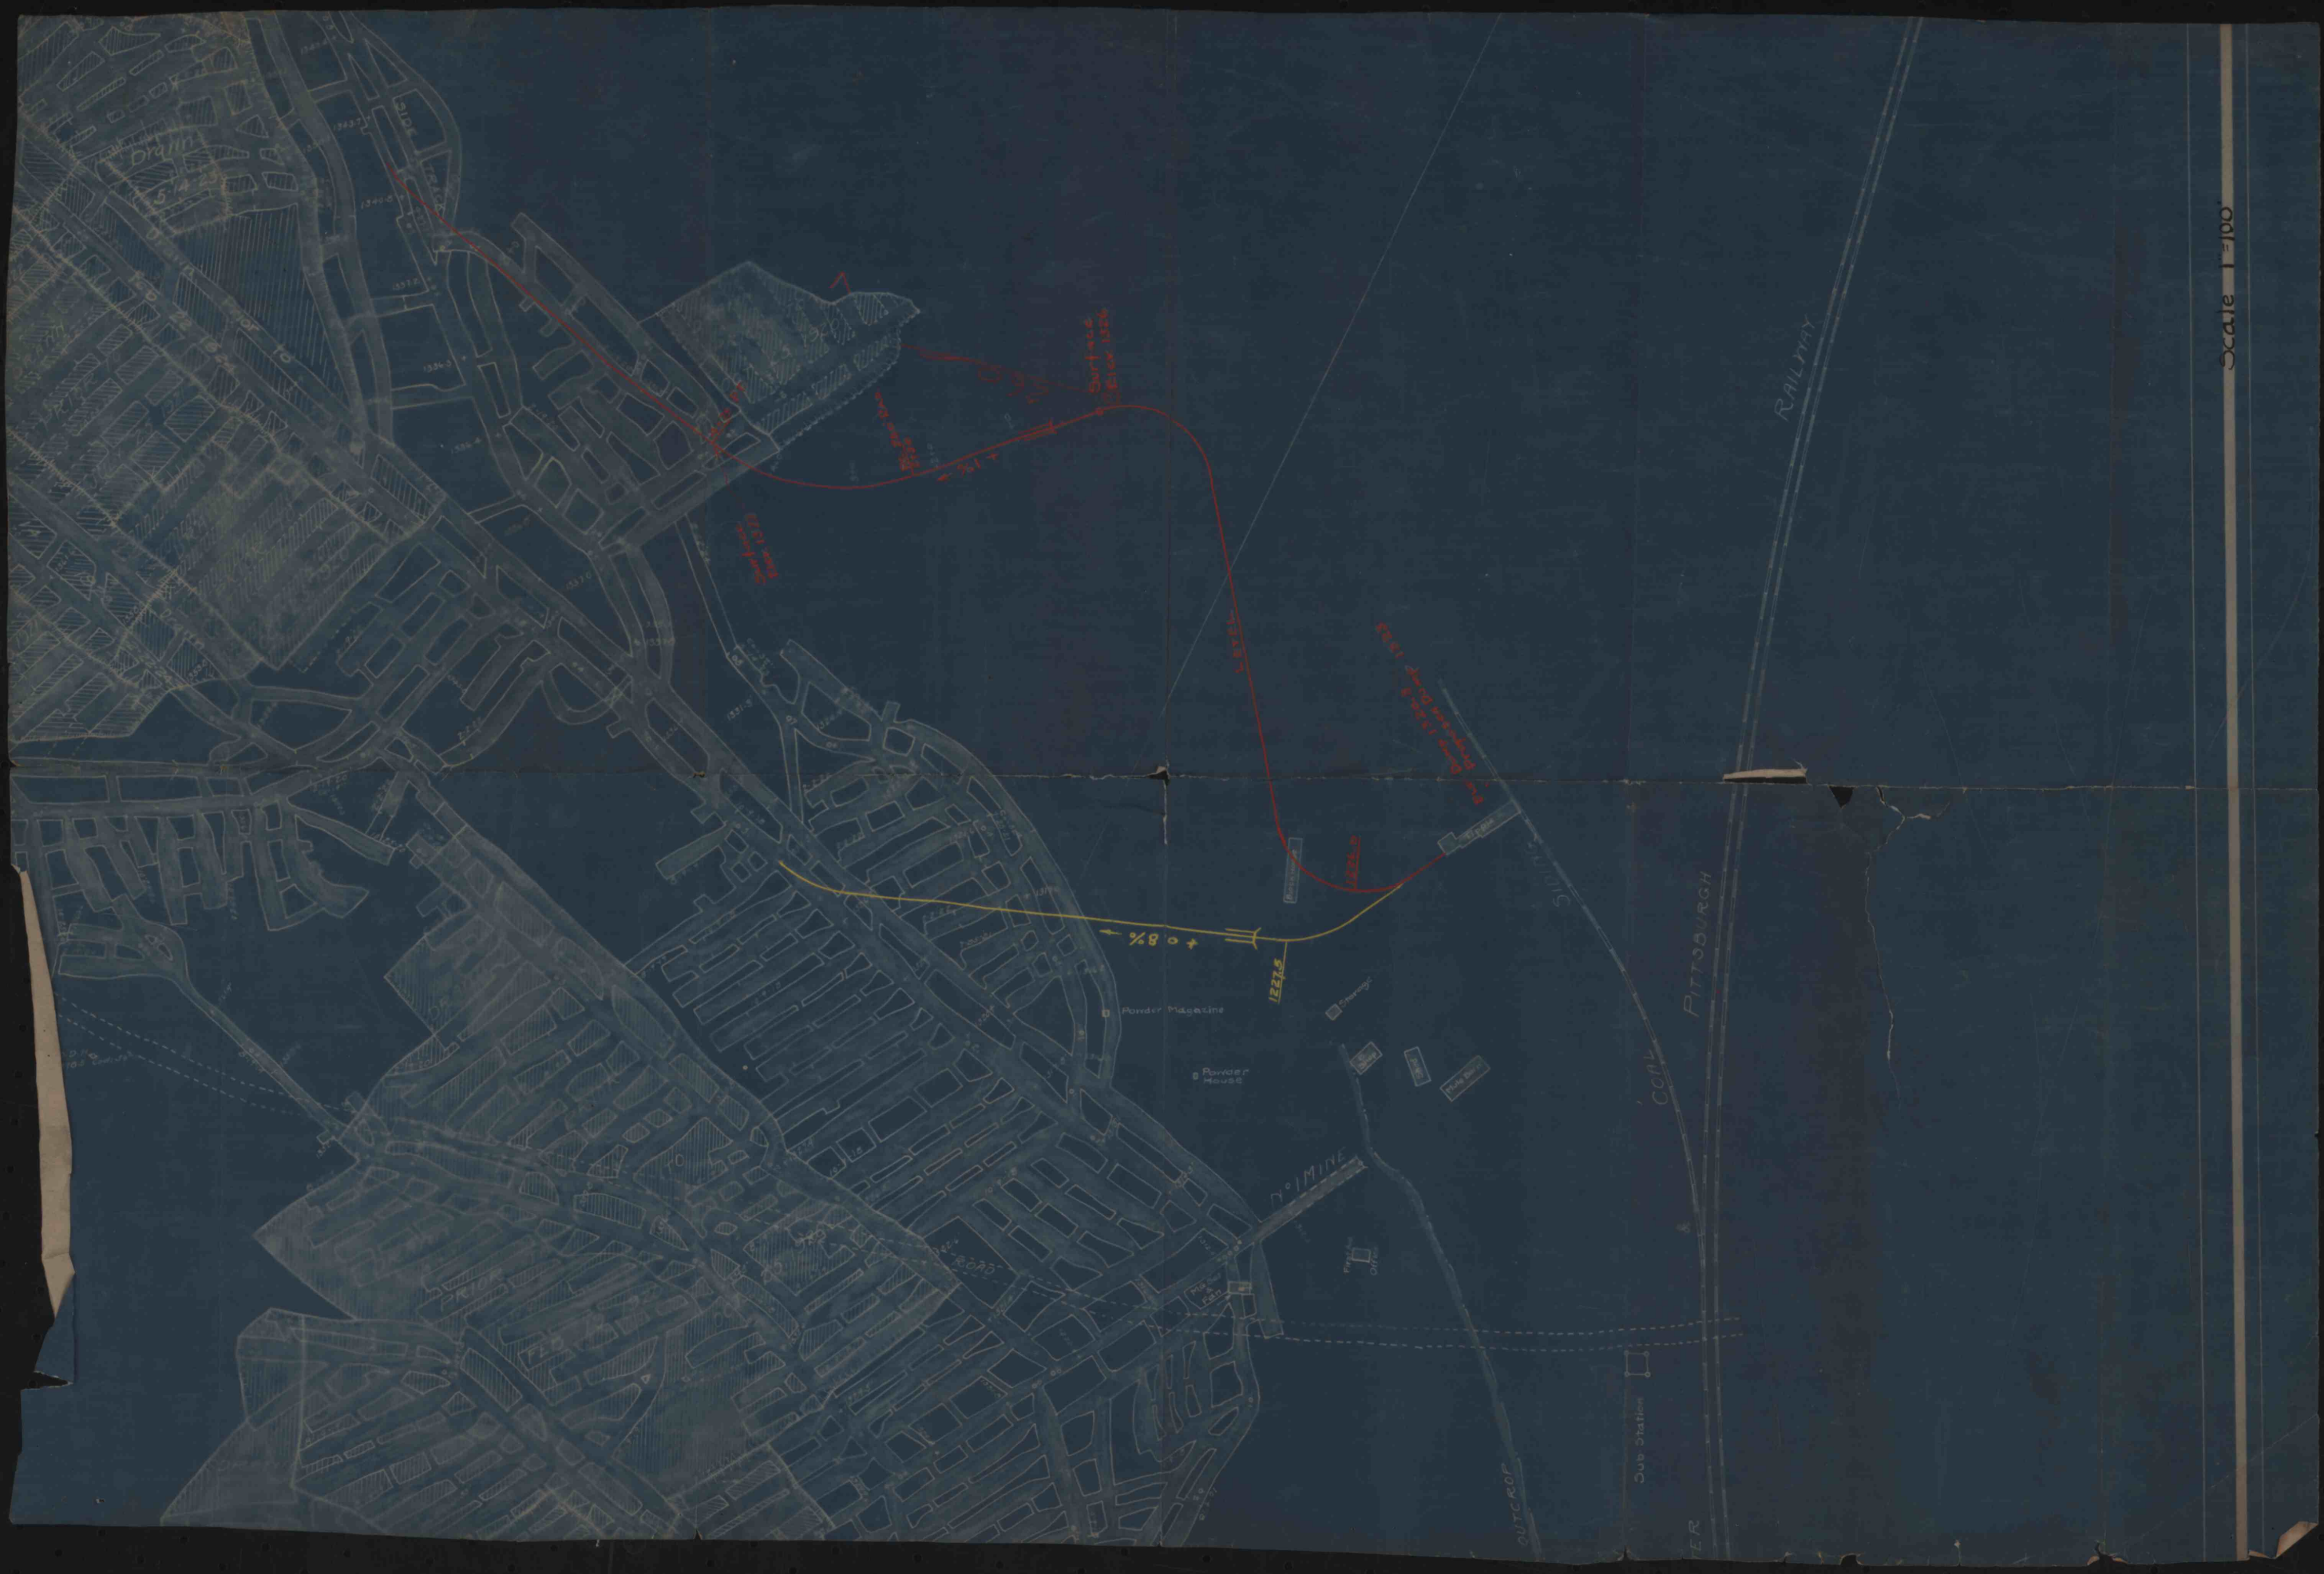

Scale 1"=100'