
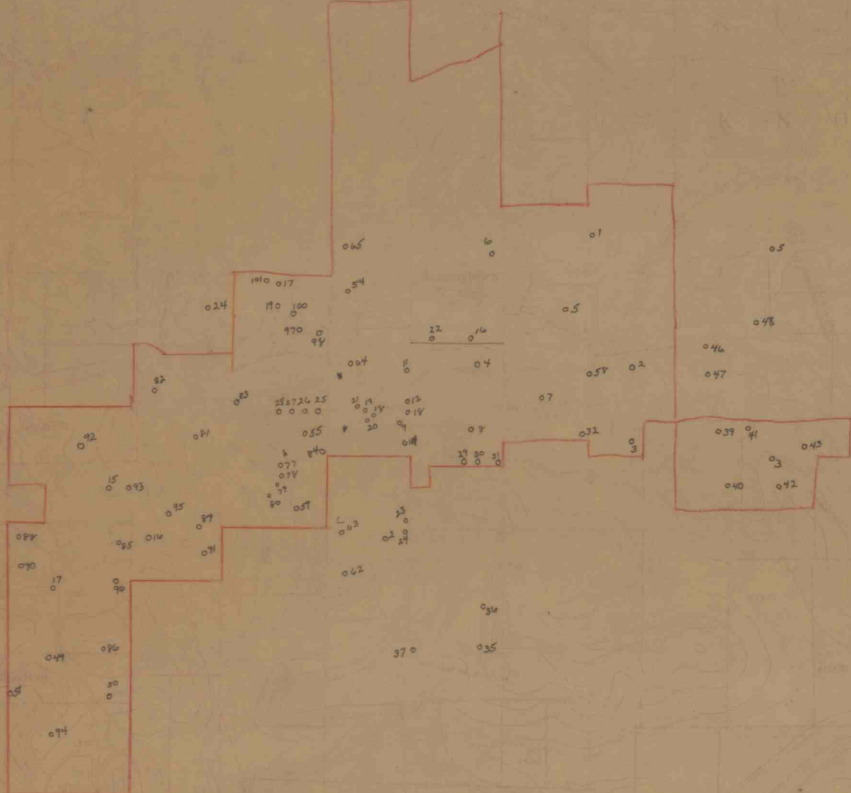


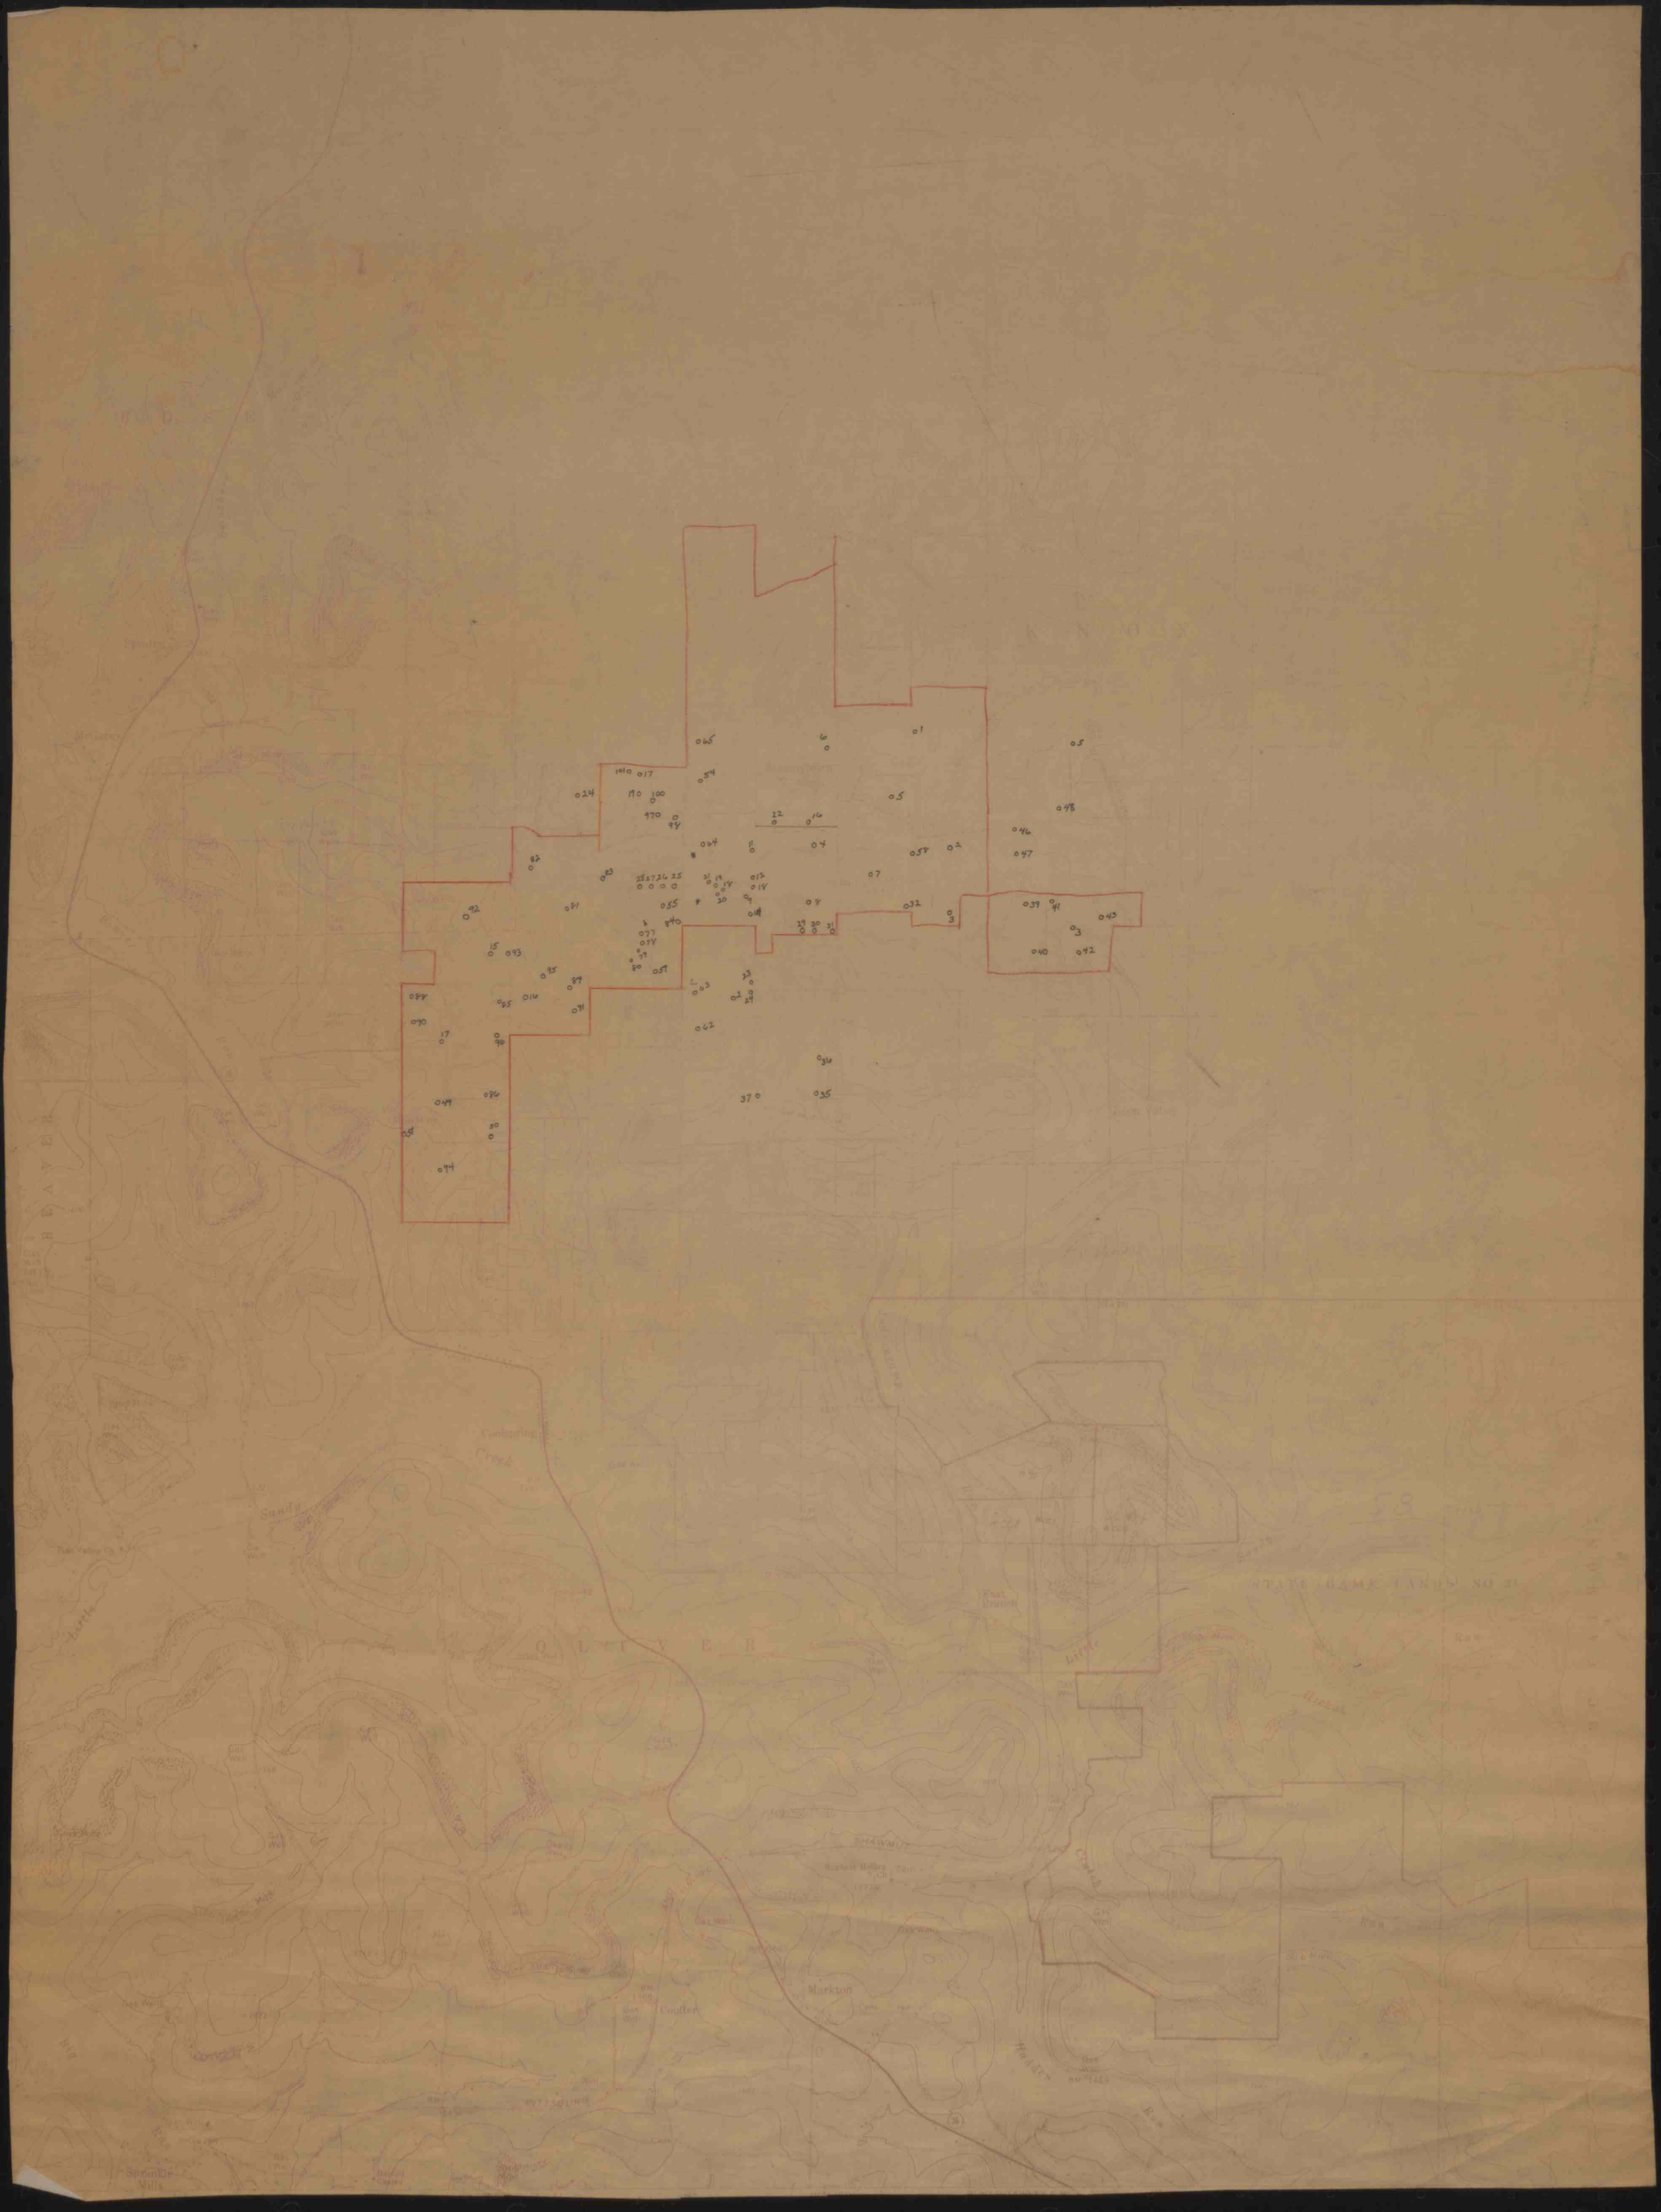

STATE GAME LAND NO. 31

58