
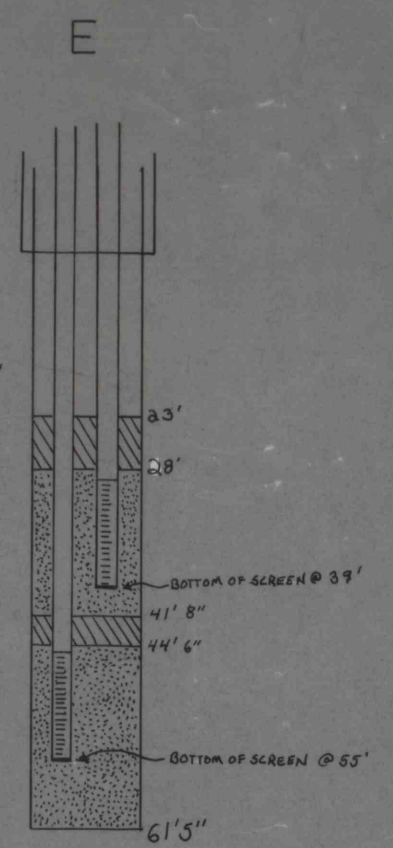
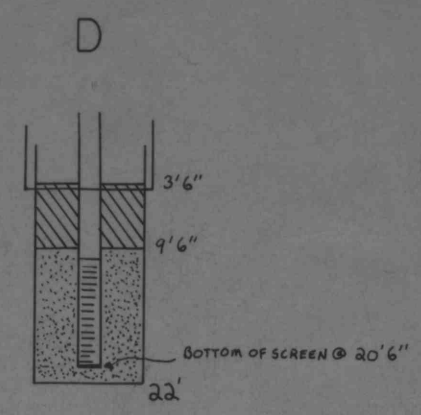
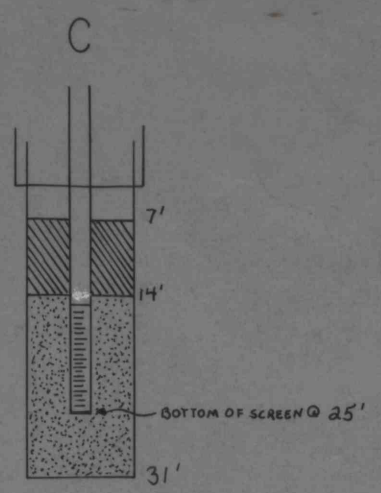
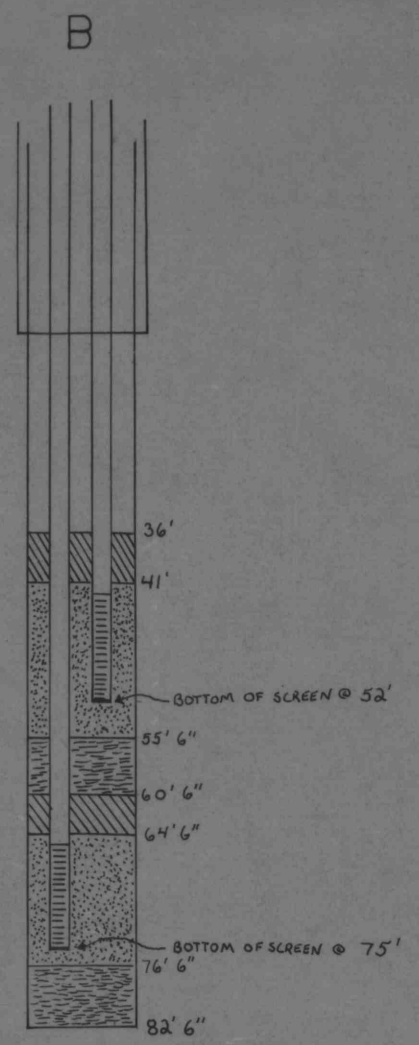


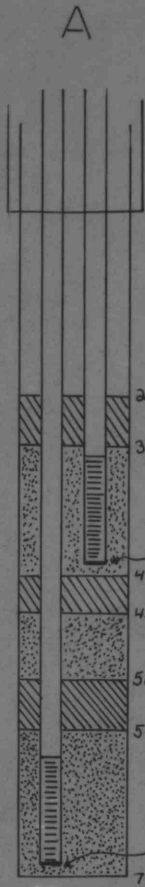

15-1