



	AREAS				
	DISTURBED AREA	AFFECTED AREA	TOTAL PRODUCTION AREA	TOTAL REGRADED AREA	TOTAL RECLAIMED AREA
⑦ ANTHONY VALOTTA - SURE CONSOL COAL CO. - COAL	1.64	1.29	0.27	1.64	0.00
⑧ CONSOL. COAL CO. COAL + SURFACE	2.05	1.52	0.34	2.05	0.00
TOTALS	3.69 Ac.	2.81 Ac.	0.61 Ac.	3.69 Ac.	0.00 Ac.

LOCATION OF
SURFACE MINE

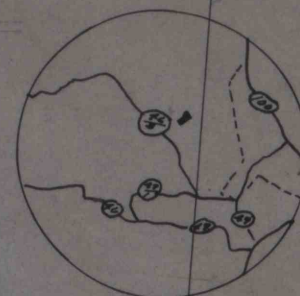

LINEAL FEET OF STRIP
SEAM OF COAL

610 L.F.
SEWICKLEY

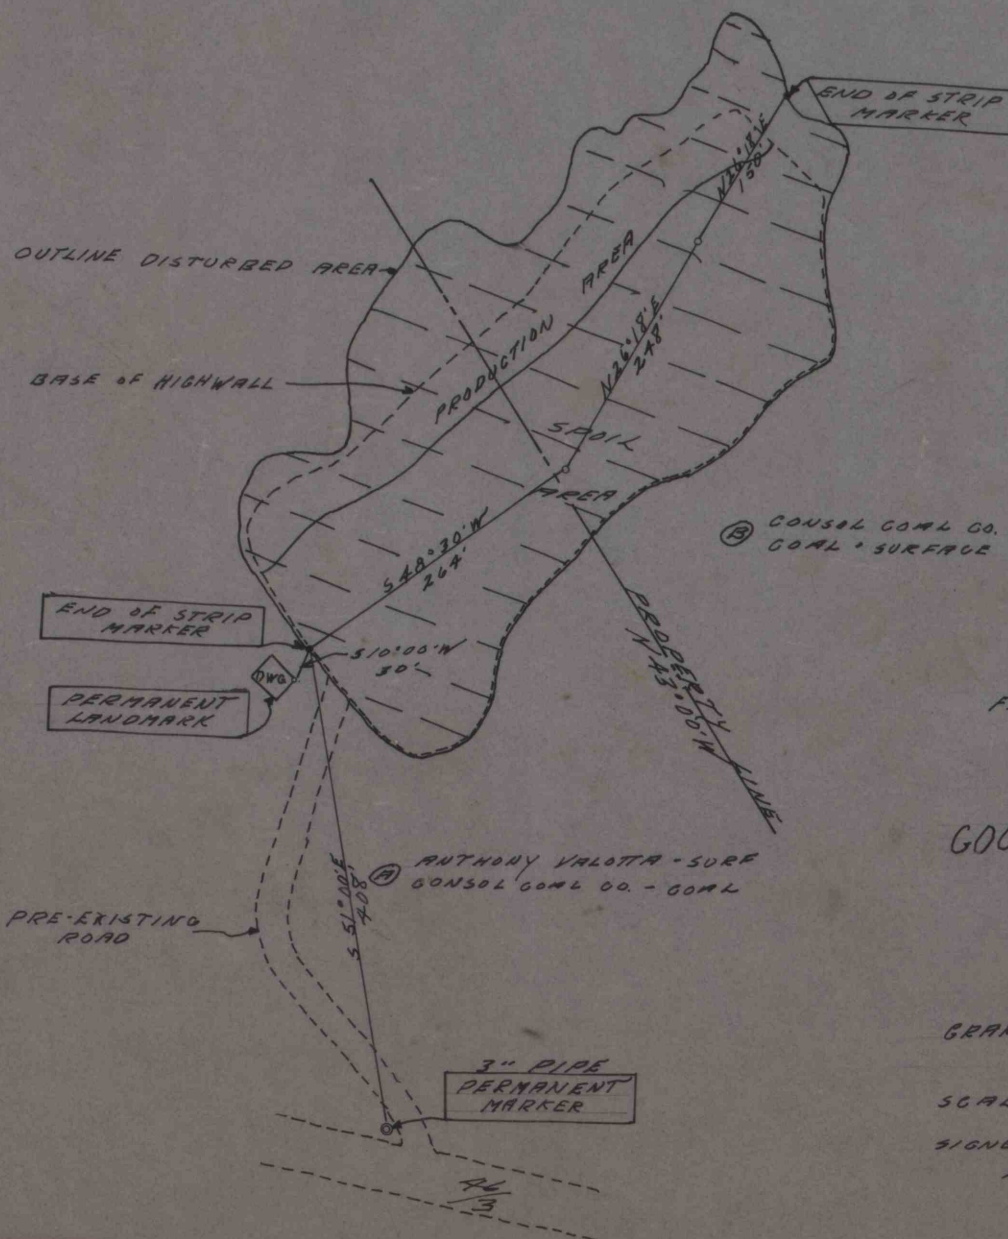

FINAL MAP FOR SURFACE MINING
PERMIT NO. S-5879

BY

GOOD EARTH MINING CO. INC.

R.F.D. NO. 1
BRUCETON HILLS, W.VA.



IN

GRANT DISTRICT MONONGALIA COUNTY
WEST VIRGINIA

SCALE: 1" = 100' 21 JUNE, 1967

SIGNED *John P. [Signature]*
LAND SURVEYOR

LEGEND

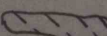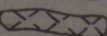DISTURBED AREA 
 AFFECTED AREA 
 REGRADED AREA 
 RECLAIMED AREA 

PRE-EXISTING
ROAD

3" PIPE
PERMANENT
MARKER