



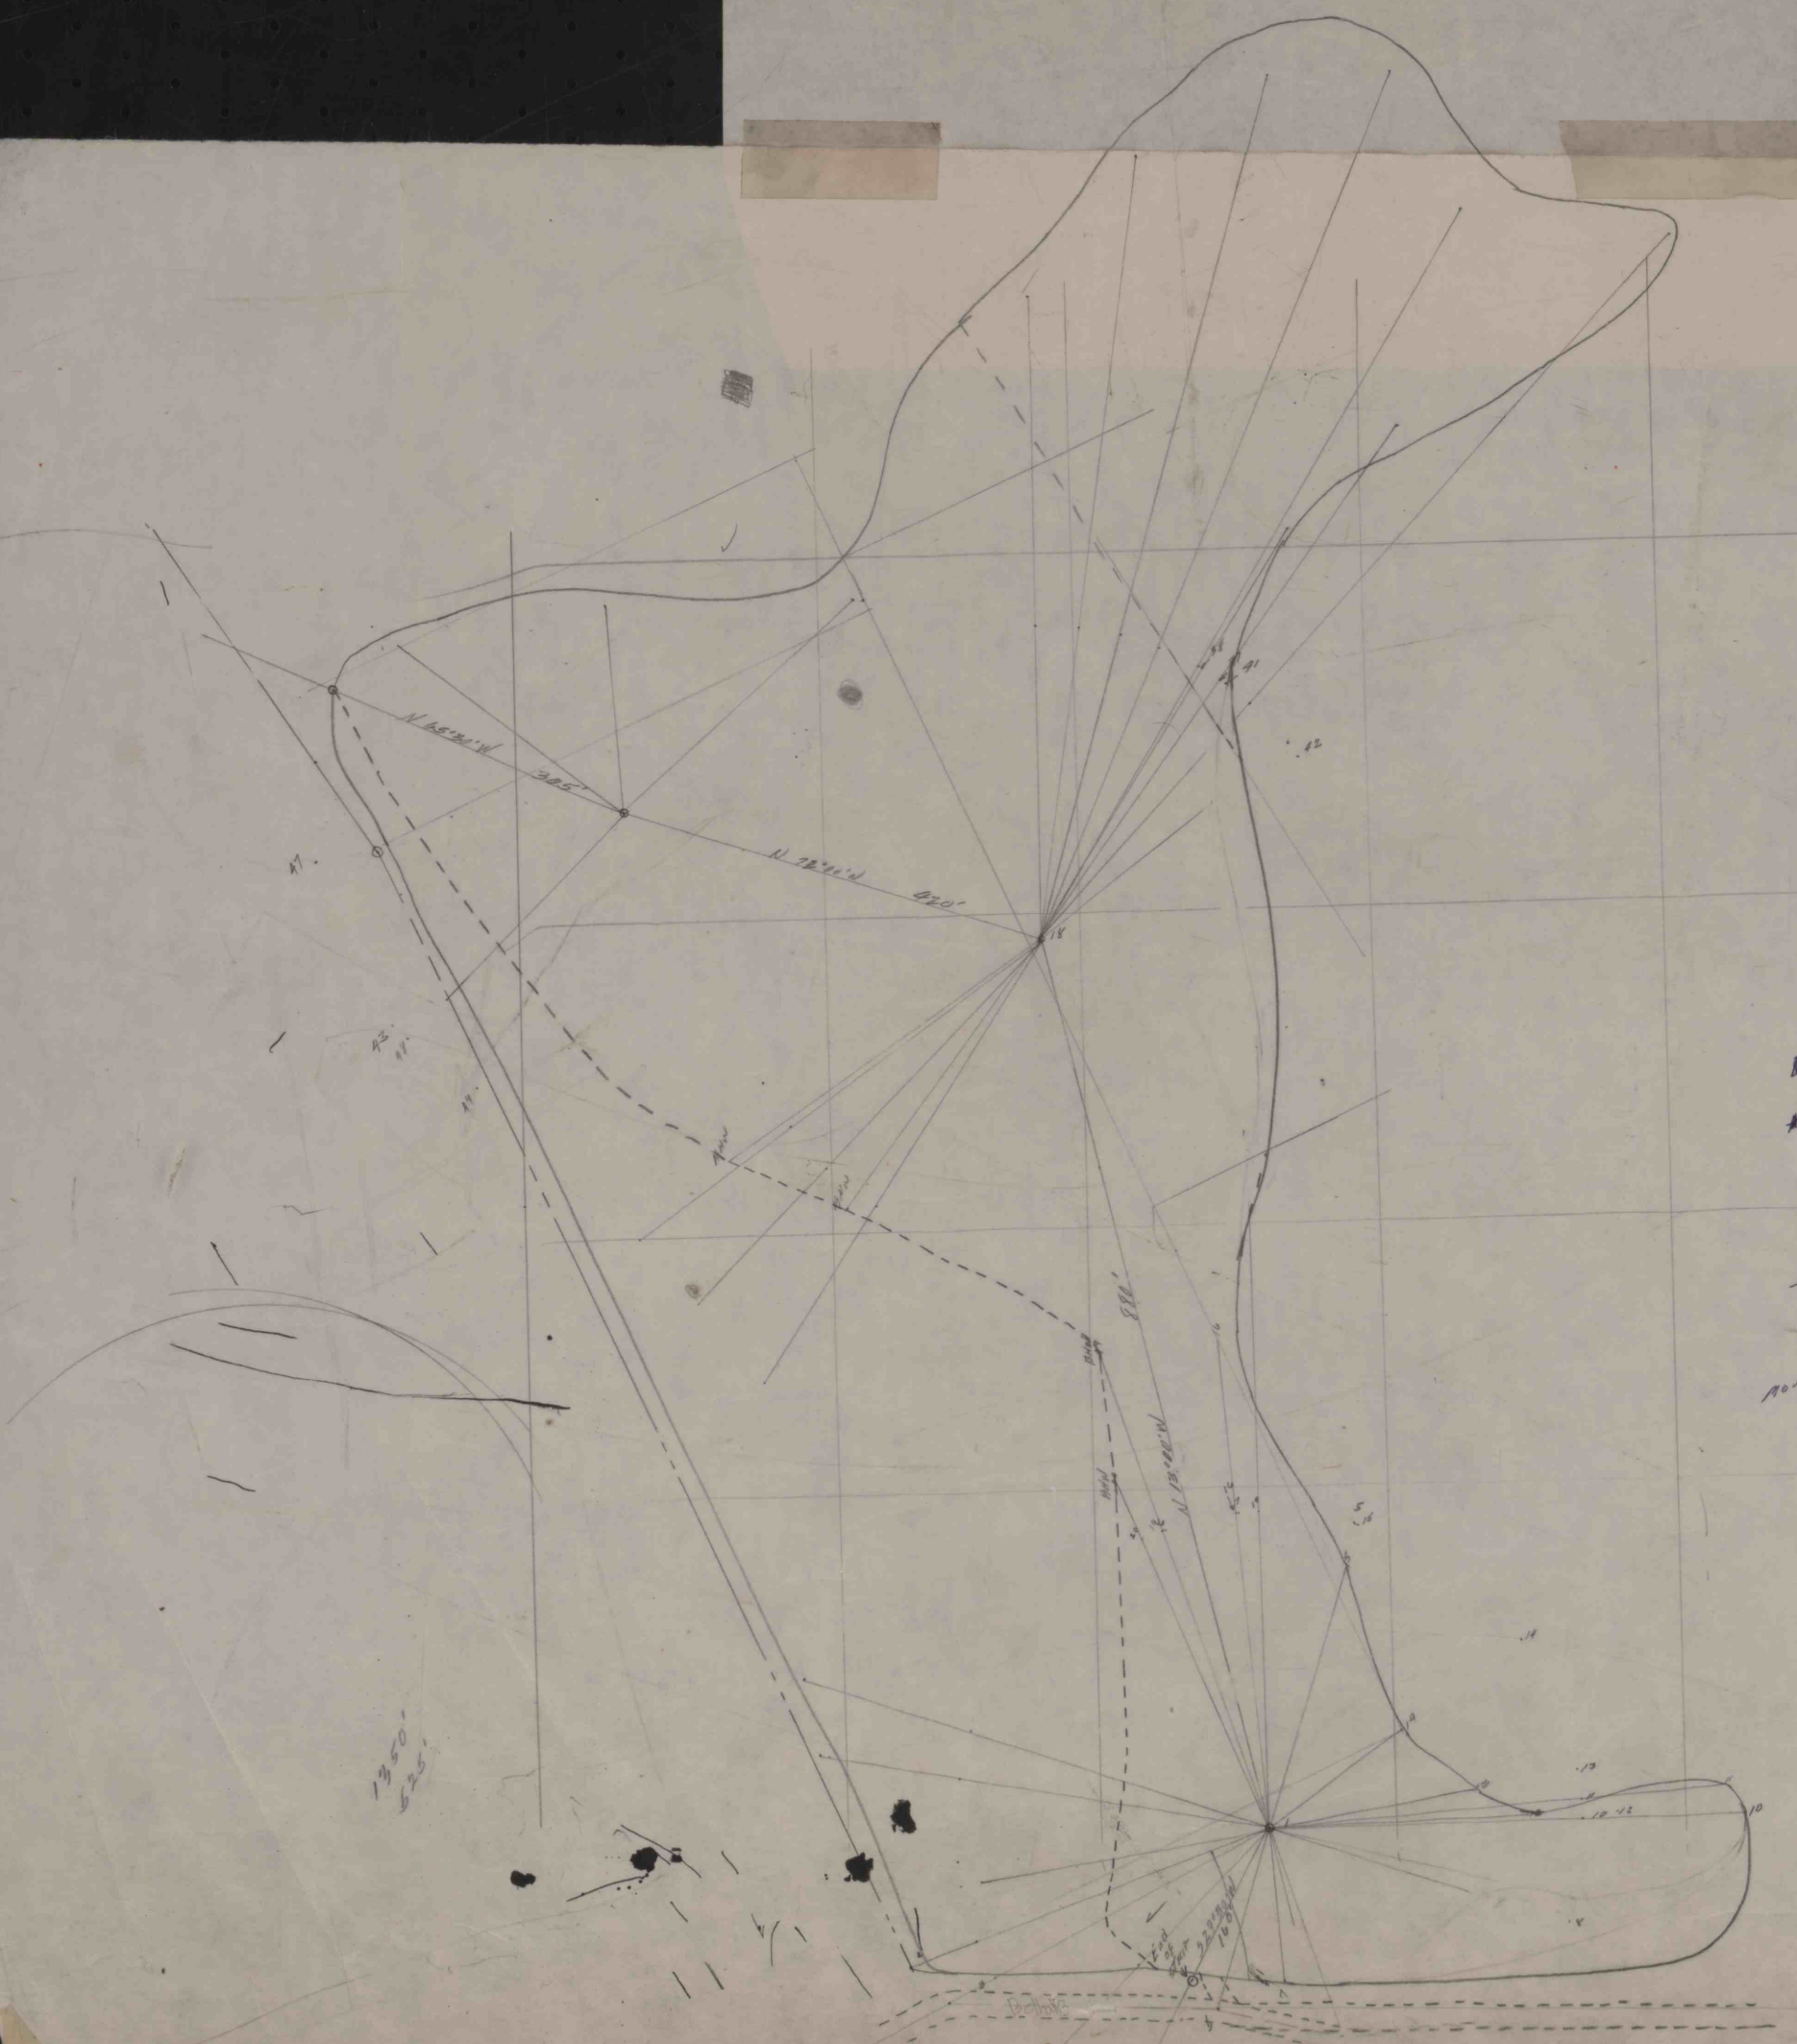

11/25/1907
556.07 lev. 7
20 AU.
Point 29.70
7 AU.

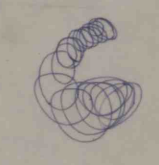

500 AU. Run

