



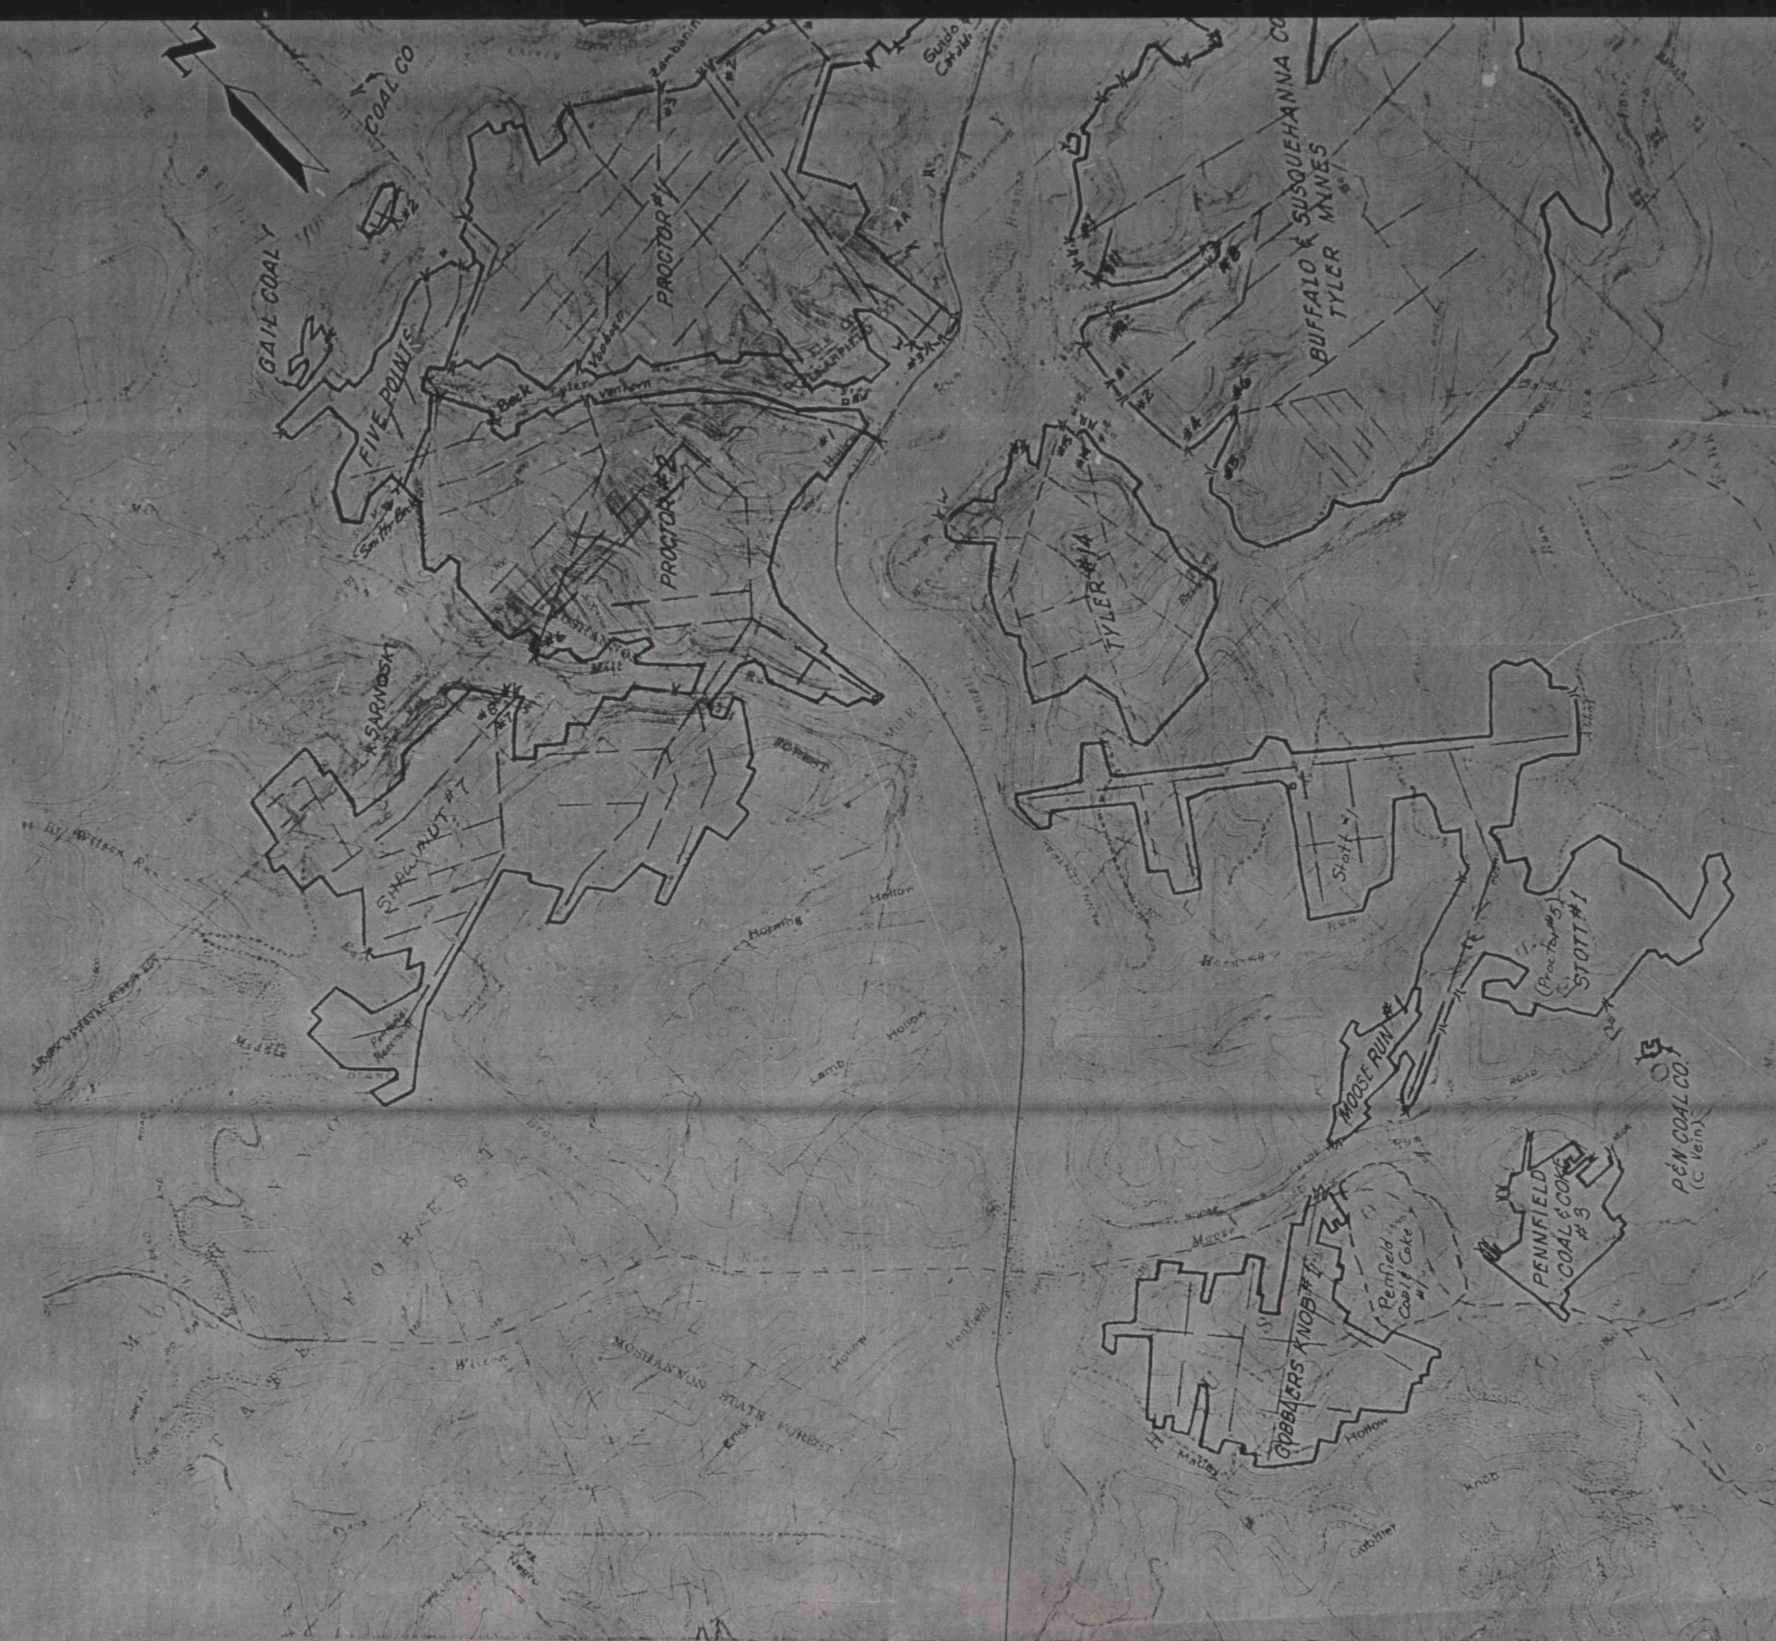

11-2000

4

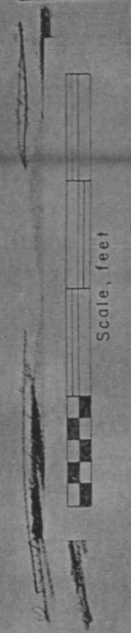

267 AC

PGS

03071

445

14.5X

325495