
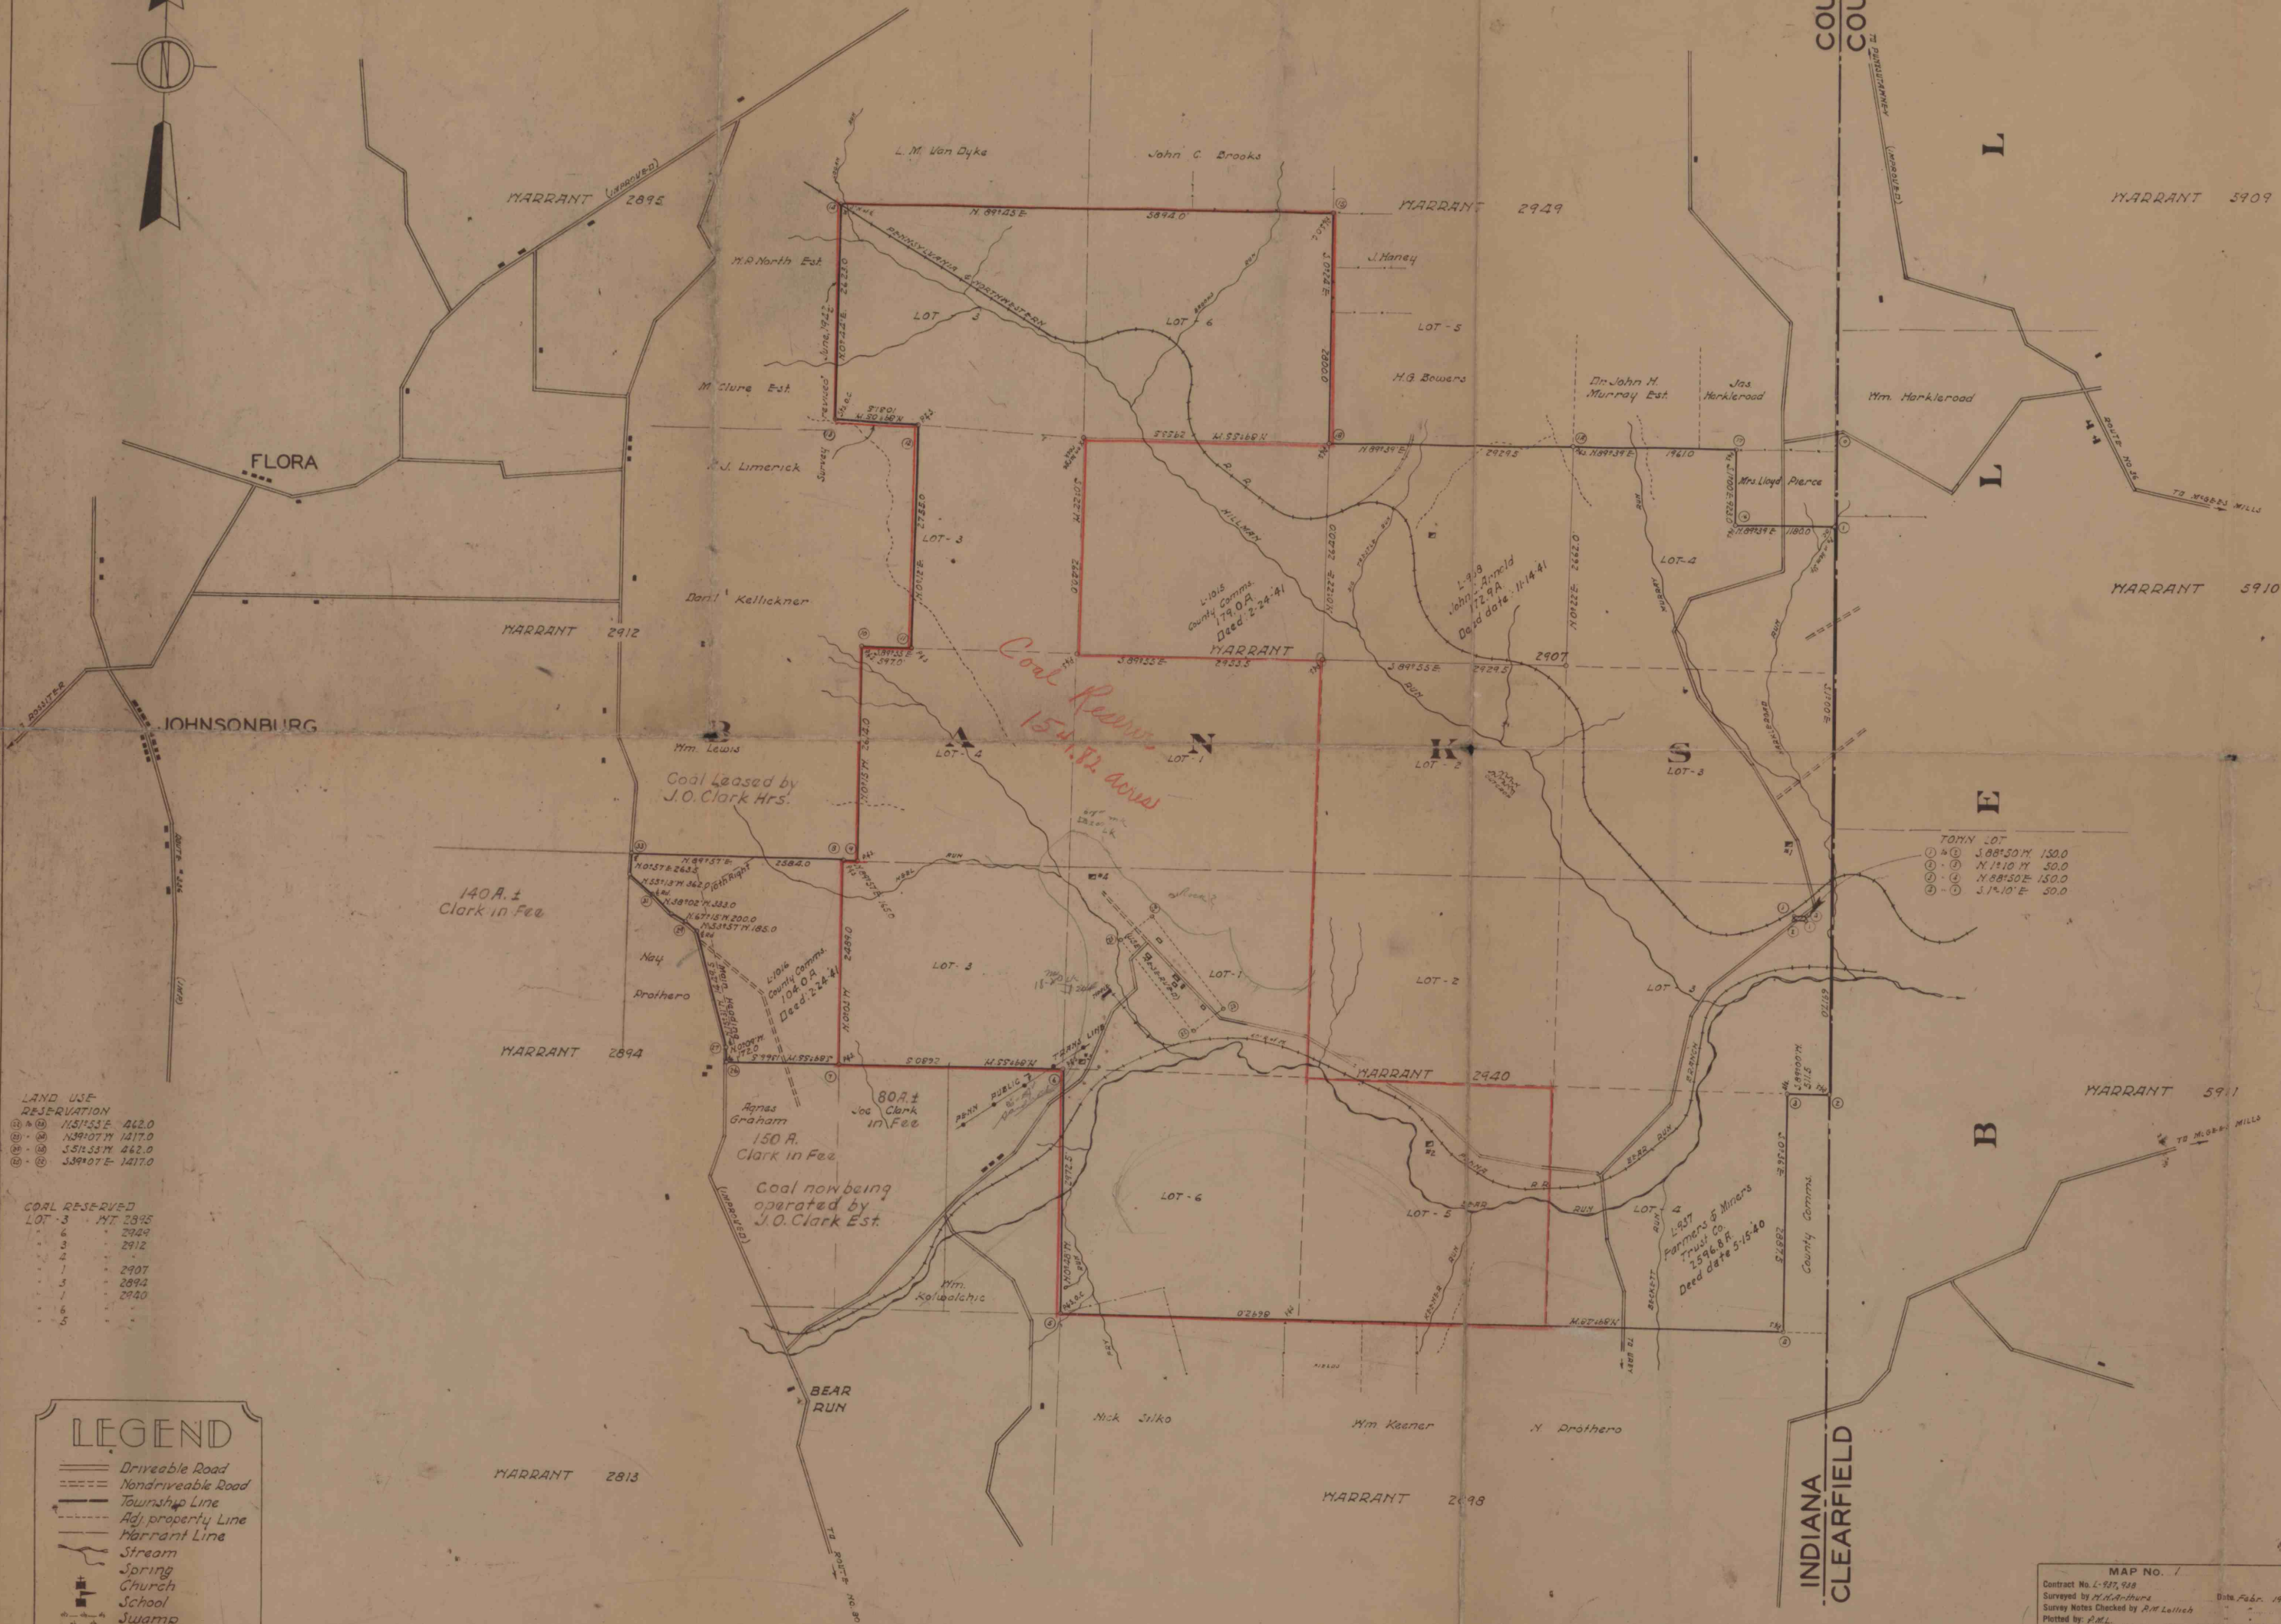


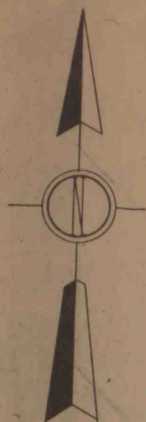

LAND USE RESERVATION

①	①	N 51° 53' E	462.0
②	②	N 39° 07' W	1417.0
③	③	S 51° 53' W	462.0
④	④	S 39° 07' E	1417.0

COAL RESERVED

LOT 3	MT 2895
6	2940
3	2912
1	2907
3	2894
1	2940
6	
5	

LEGEND

- Driveable Road
- Non-driveable Road
- Township Line
- Adj. property Line
- Warrant Line
- Stream
- Spring
- Church
- School
- Swamp

TOHN LOT

④	④	S 1° 10' E	50.0

MAP NO. 1

Plotted by H. M. L.	
Traced by -	
Tracing Checked by J. C.	
Revised by -	
Revised by -	

PENNSYLVANIA GAME COMMISSION

STATE GAME LANDS

NO. 174.

INDIANA COUNTY

