



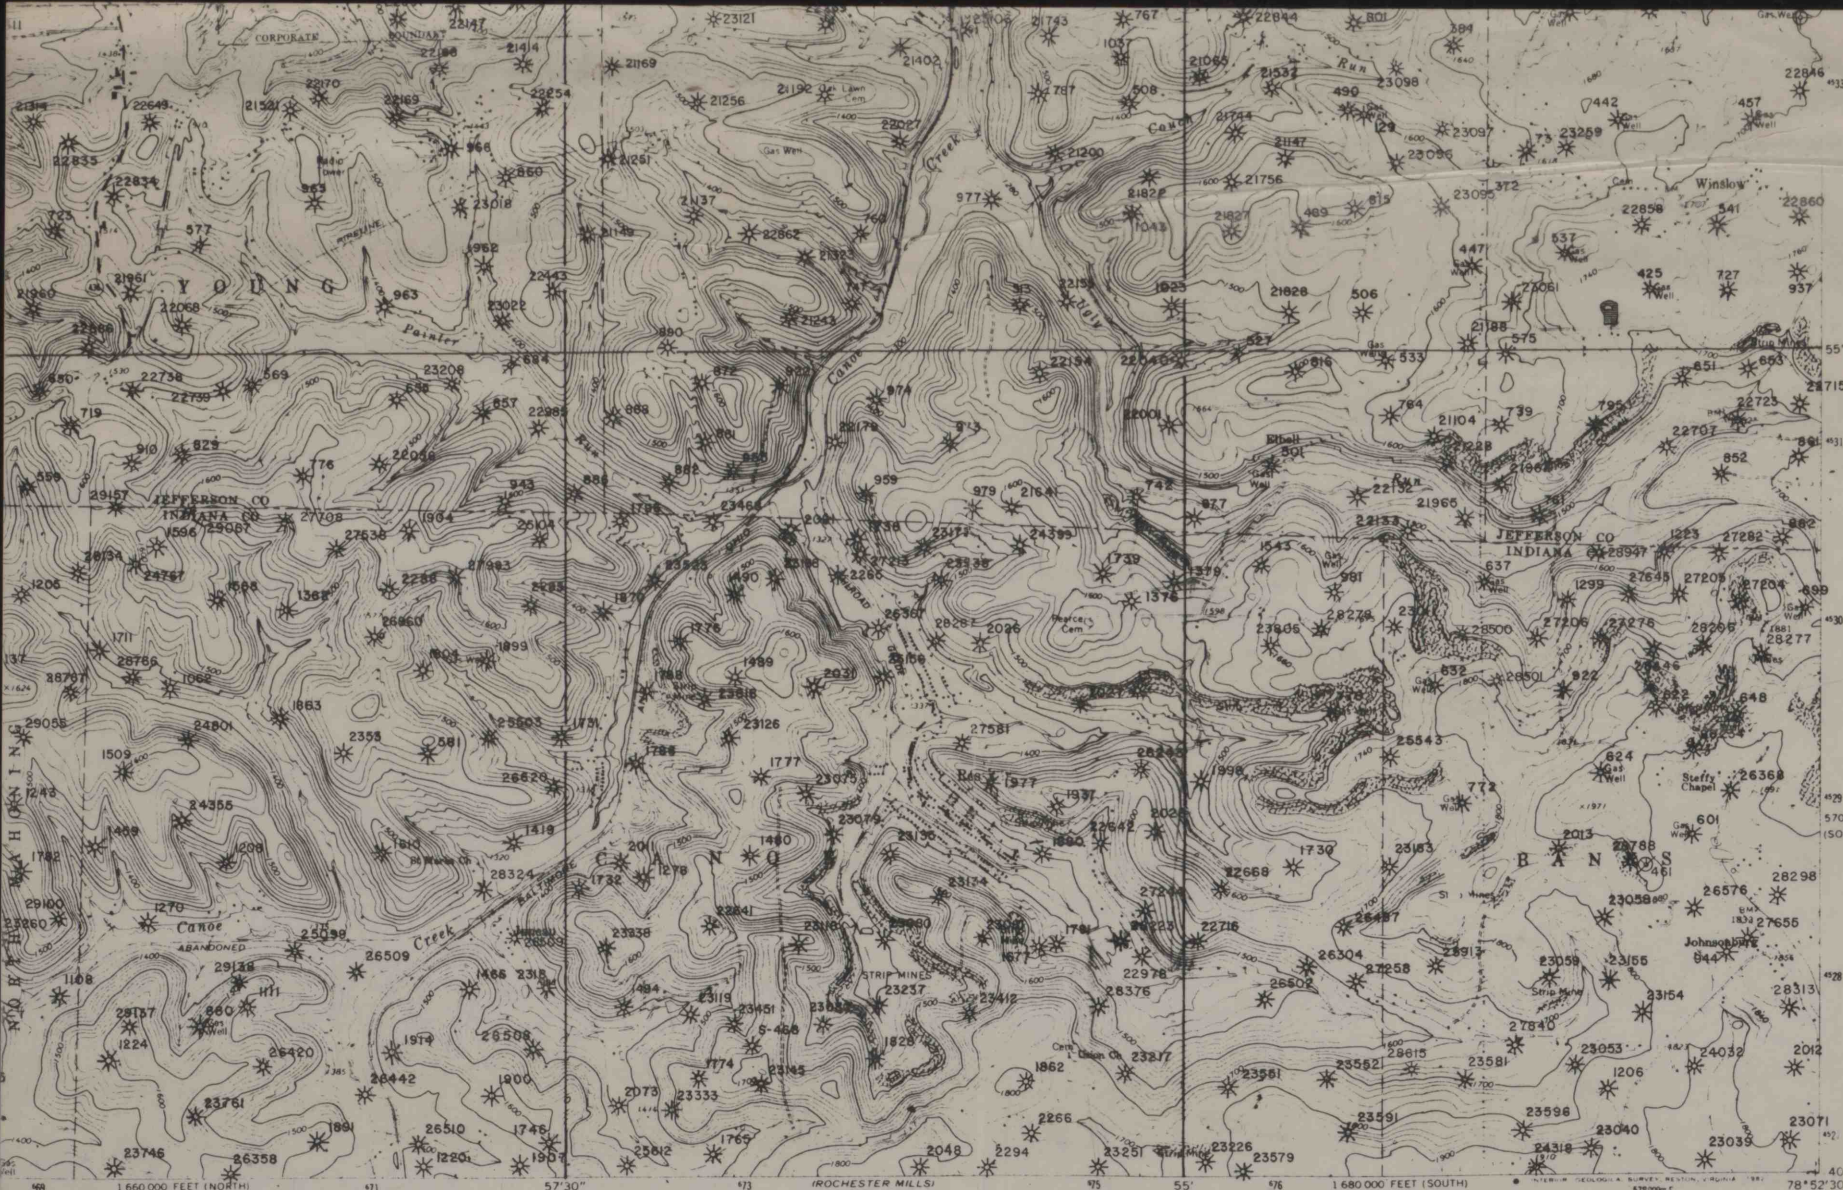

edited, and published by the Geological Survey  
USGS and NOS/NOAA

by photogrammetric methods from aerial  
photos taken 1967. Field checked 1968  
projection. 10,000-foot grid ticks based on  
Universal Transverse Mercator grid ticks.  
shown in blue. 1927 North American Datum  
in the predicted North American Datum 1983  
projection lines 4 meters south and  
west as shown by dashed corner ticks  
lashed lines indicate selected fence and field  
e generally visible on aerial photographs.  
ation is unchecked

UTM GRID and 1981 MAGNETIC NORTH  
DECLINATION AT CENTER OF SHEET  
**PA OIL & GAS Division Posting**  
**POSTED DATE 4/10/87**  
*All wells.*

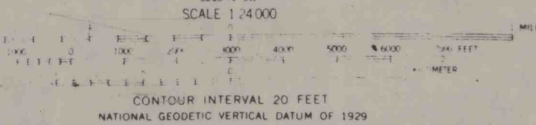

THIS MAP COMPLIES WITH NATIONAL MAP ACCURACY STANDARDS  
FOR SALE BY U. S. GEOLOGICAL SURVEY, RESTON, VIRGINIA 22092  
A FOLDER DESCRIBING TOPOGRAPHIC MAPS AND SYMBOLS IS AVAILABLE ON REQUEST

**ROAD CLASSIFICATION**  
Primary highway, all weather hard surface  
Secondary highway, all weather hard surface  
Light-duty road, all weather, improved surface  
Unimproved road, fair or dry weather  
U S Route State Route  
**PUNXSUTAWNEY, PA.**  
N40525—W7852 5/7 5  
1968  
**PHOTOREVISED 1981**  
DMA 5265 IV NW SERIES V81  
Revisions shown in purple compiled in cooperation with  
Commonwealth of Pennsylvania agencies from aerial  
photographs taken 1977 and other sources. This  
information not field checked. Map edited 1981