


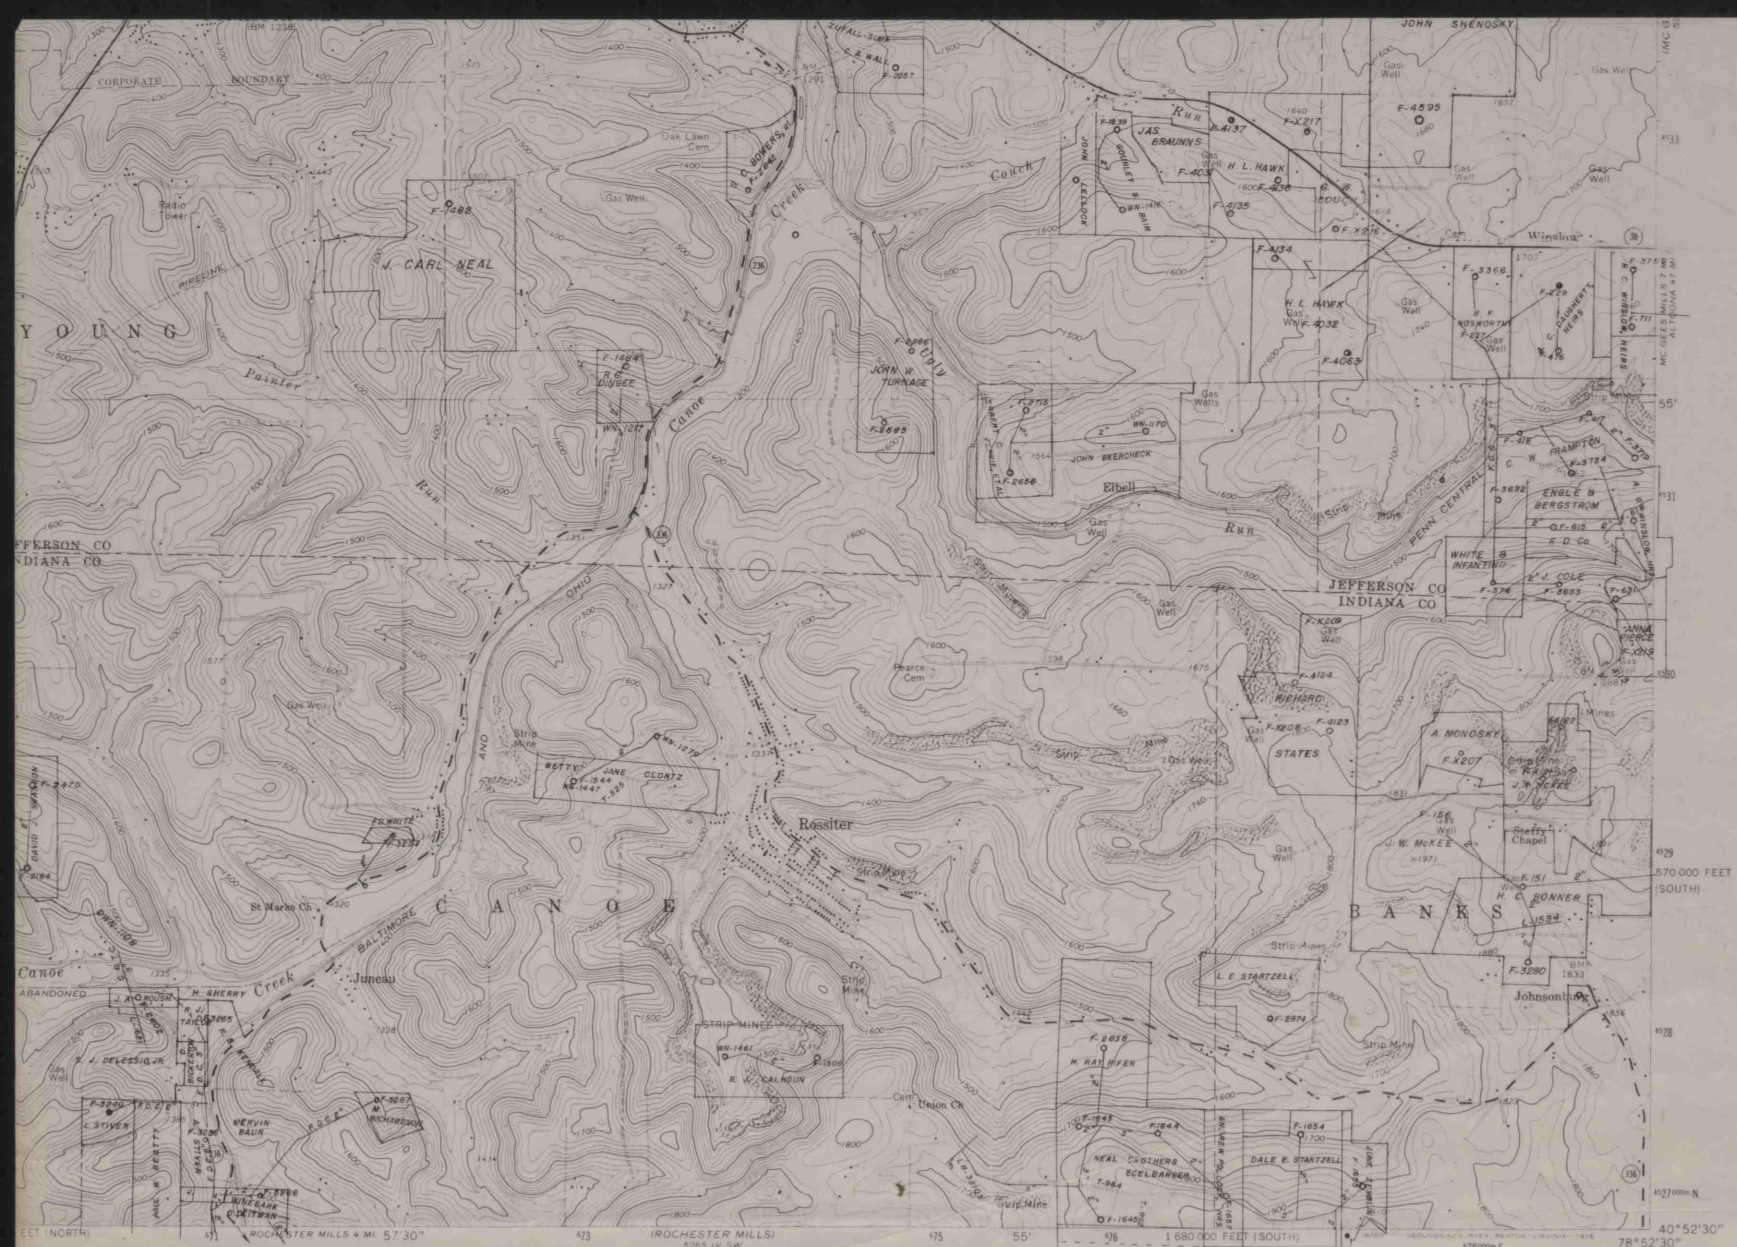

Geological Survey

From aerial photograph, 1968

Horizontal datum: National datum

Coordinate system: North

Grid ticks: zone 17

Scale: 1:24,000

Contour interval: 20 feet

National Geodetic Vertical Datum of 1929

Fairman Wells

This map complies with National Map Accuracy Standards for sale by U.S. Geological Survey, Reston, Virginia 22092. A folder describing topographic maps and symbols is available on request.

Over

ROAD CLASSIFICATION

Primary highway, all weather, hard surface	Light-duty road, all weather, improved surface
Secondary highway, all weather, hard surface	Unimproved road, fair or dry weather

U.S. Route State Route

PUNXSUTAWNEY, PA.

N4052.5--W7852.5

1968

PHOTO REVISITED 1973

AME 5064 IV NW, SERIES 1963

BROOKVILLE, PA.

D. M. L. LEY

58 South Street

Brookville, PA 15025

814-849-3040