
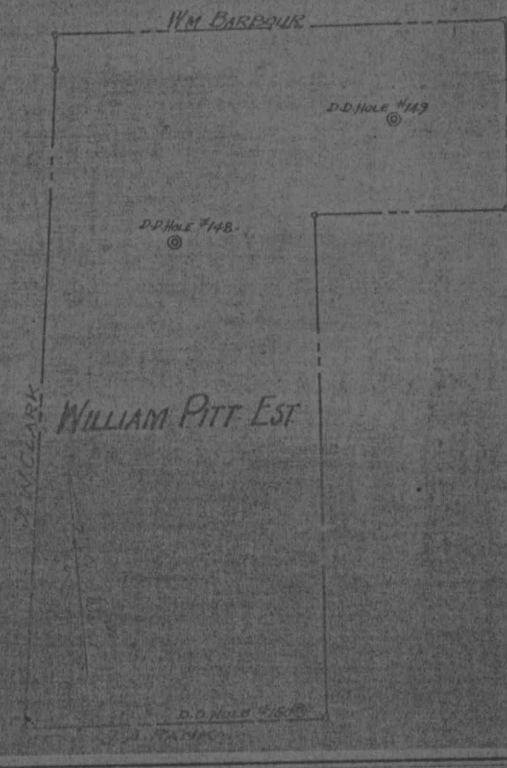
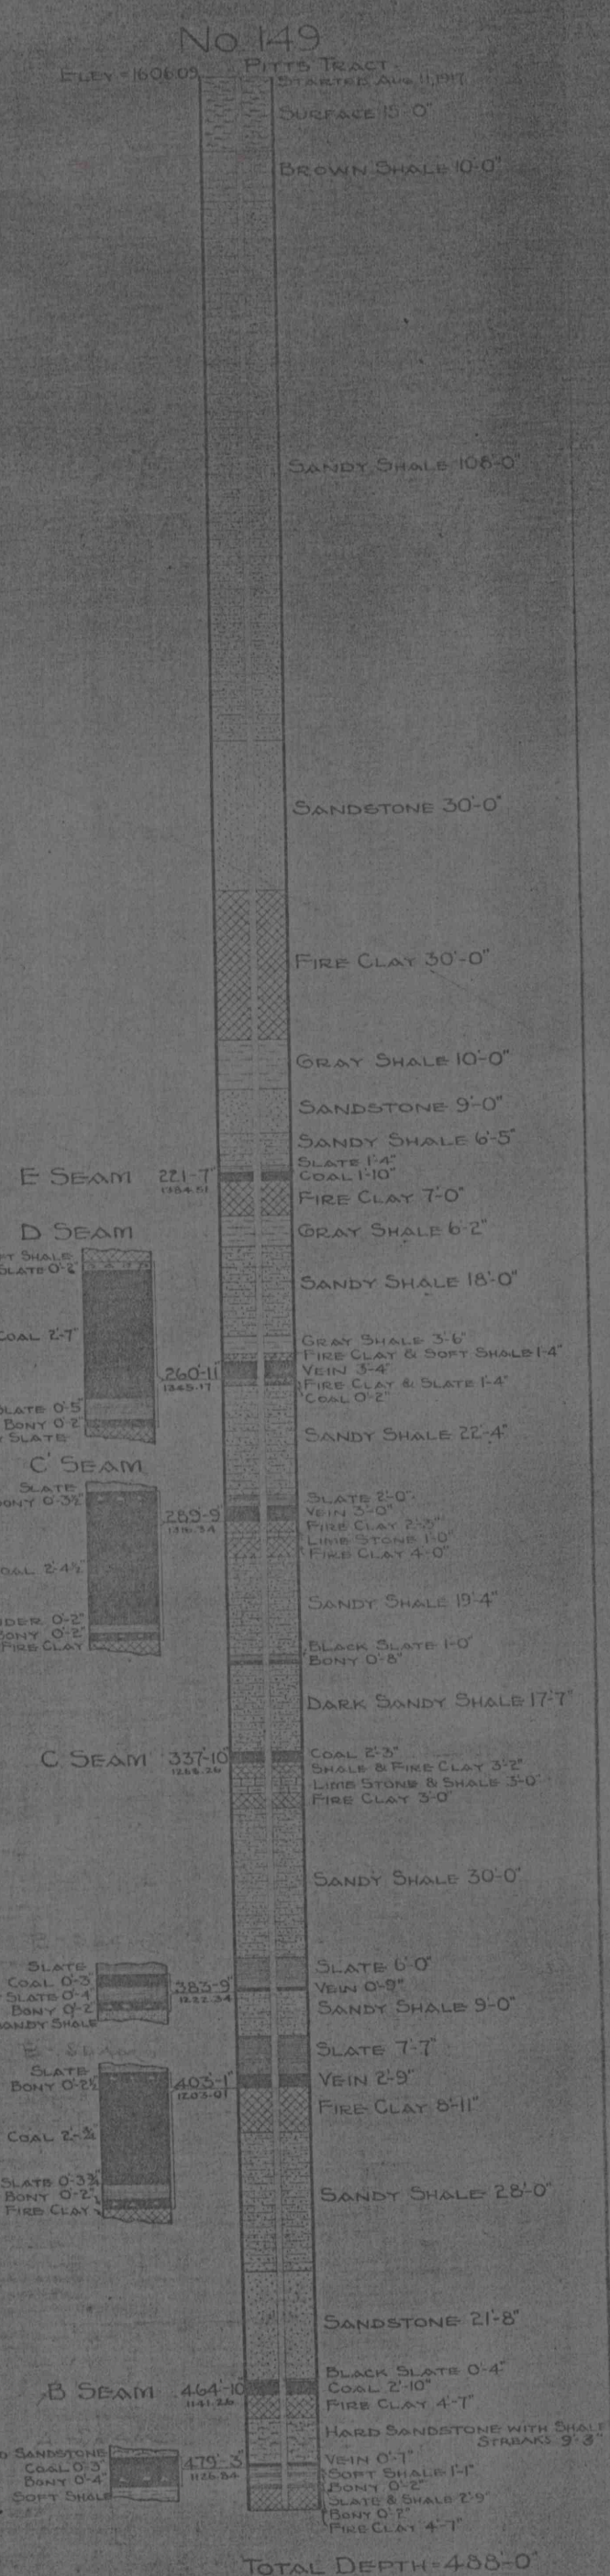


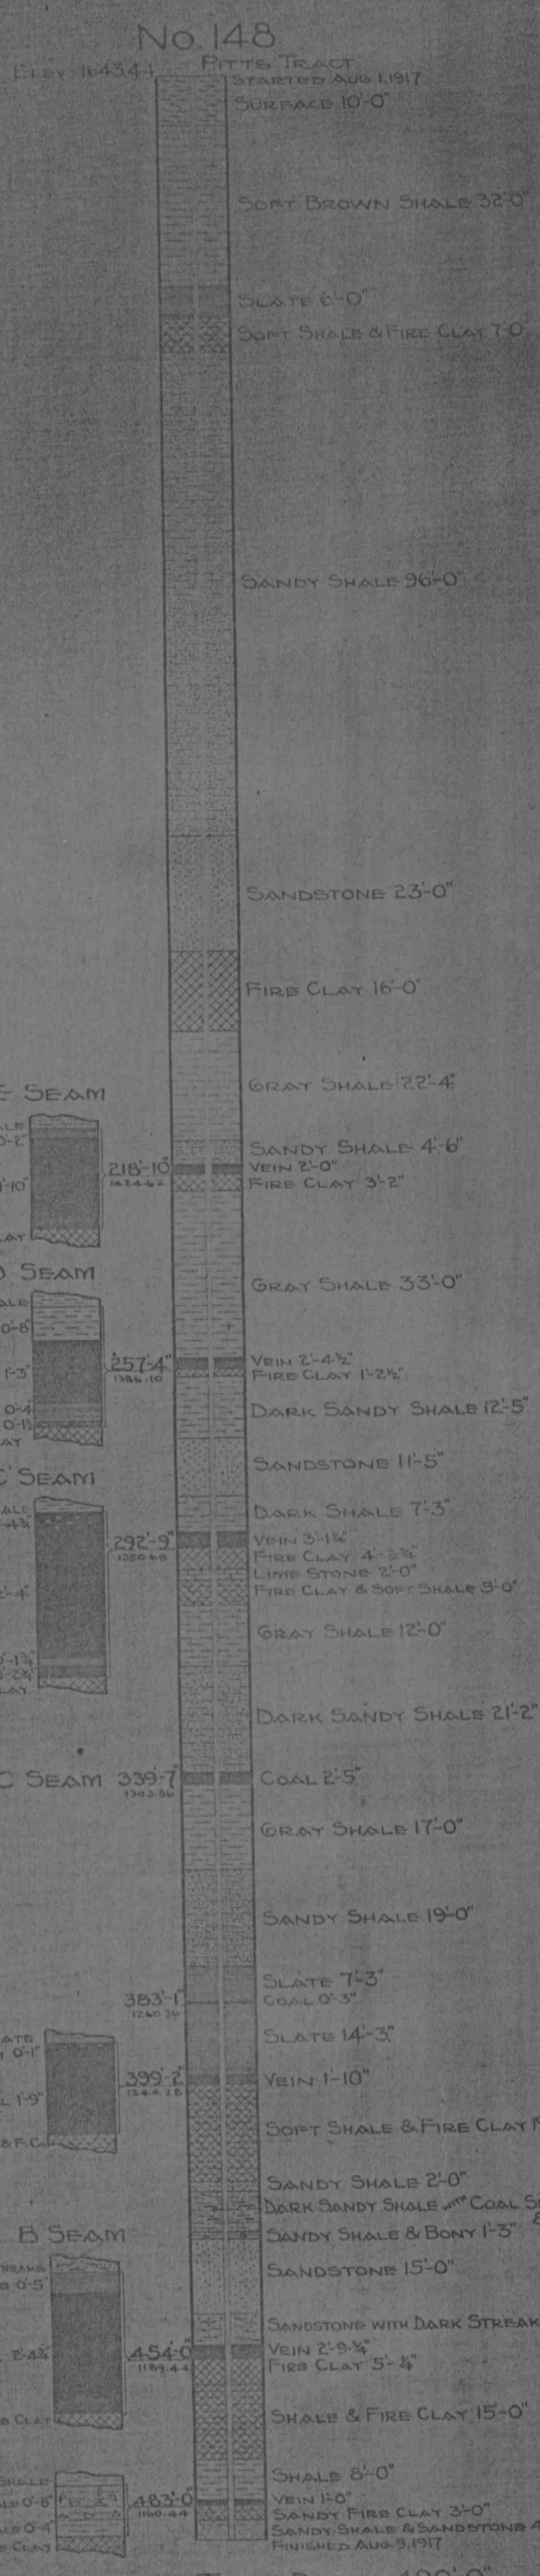

NOTE: INFORMATION SUPPLIED BY
CLEVELAND BITUMINOUS COAL CORP.

SECTION
OF
THE ARCADIA CO. INC.

EVAN JOHNSON & FOREMAN INC.