


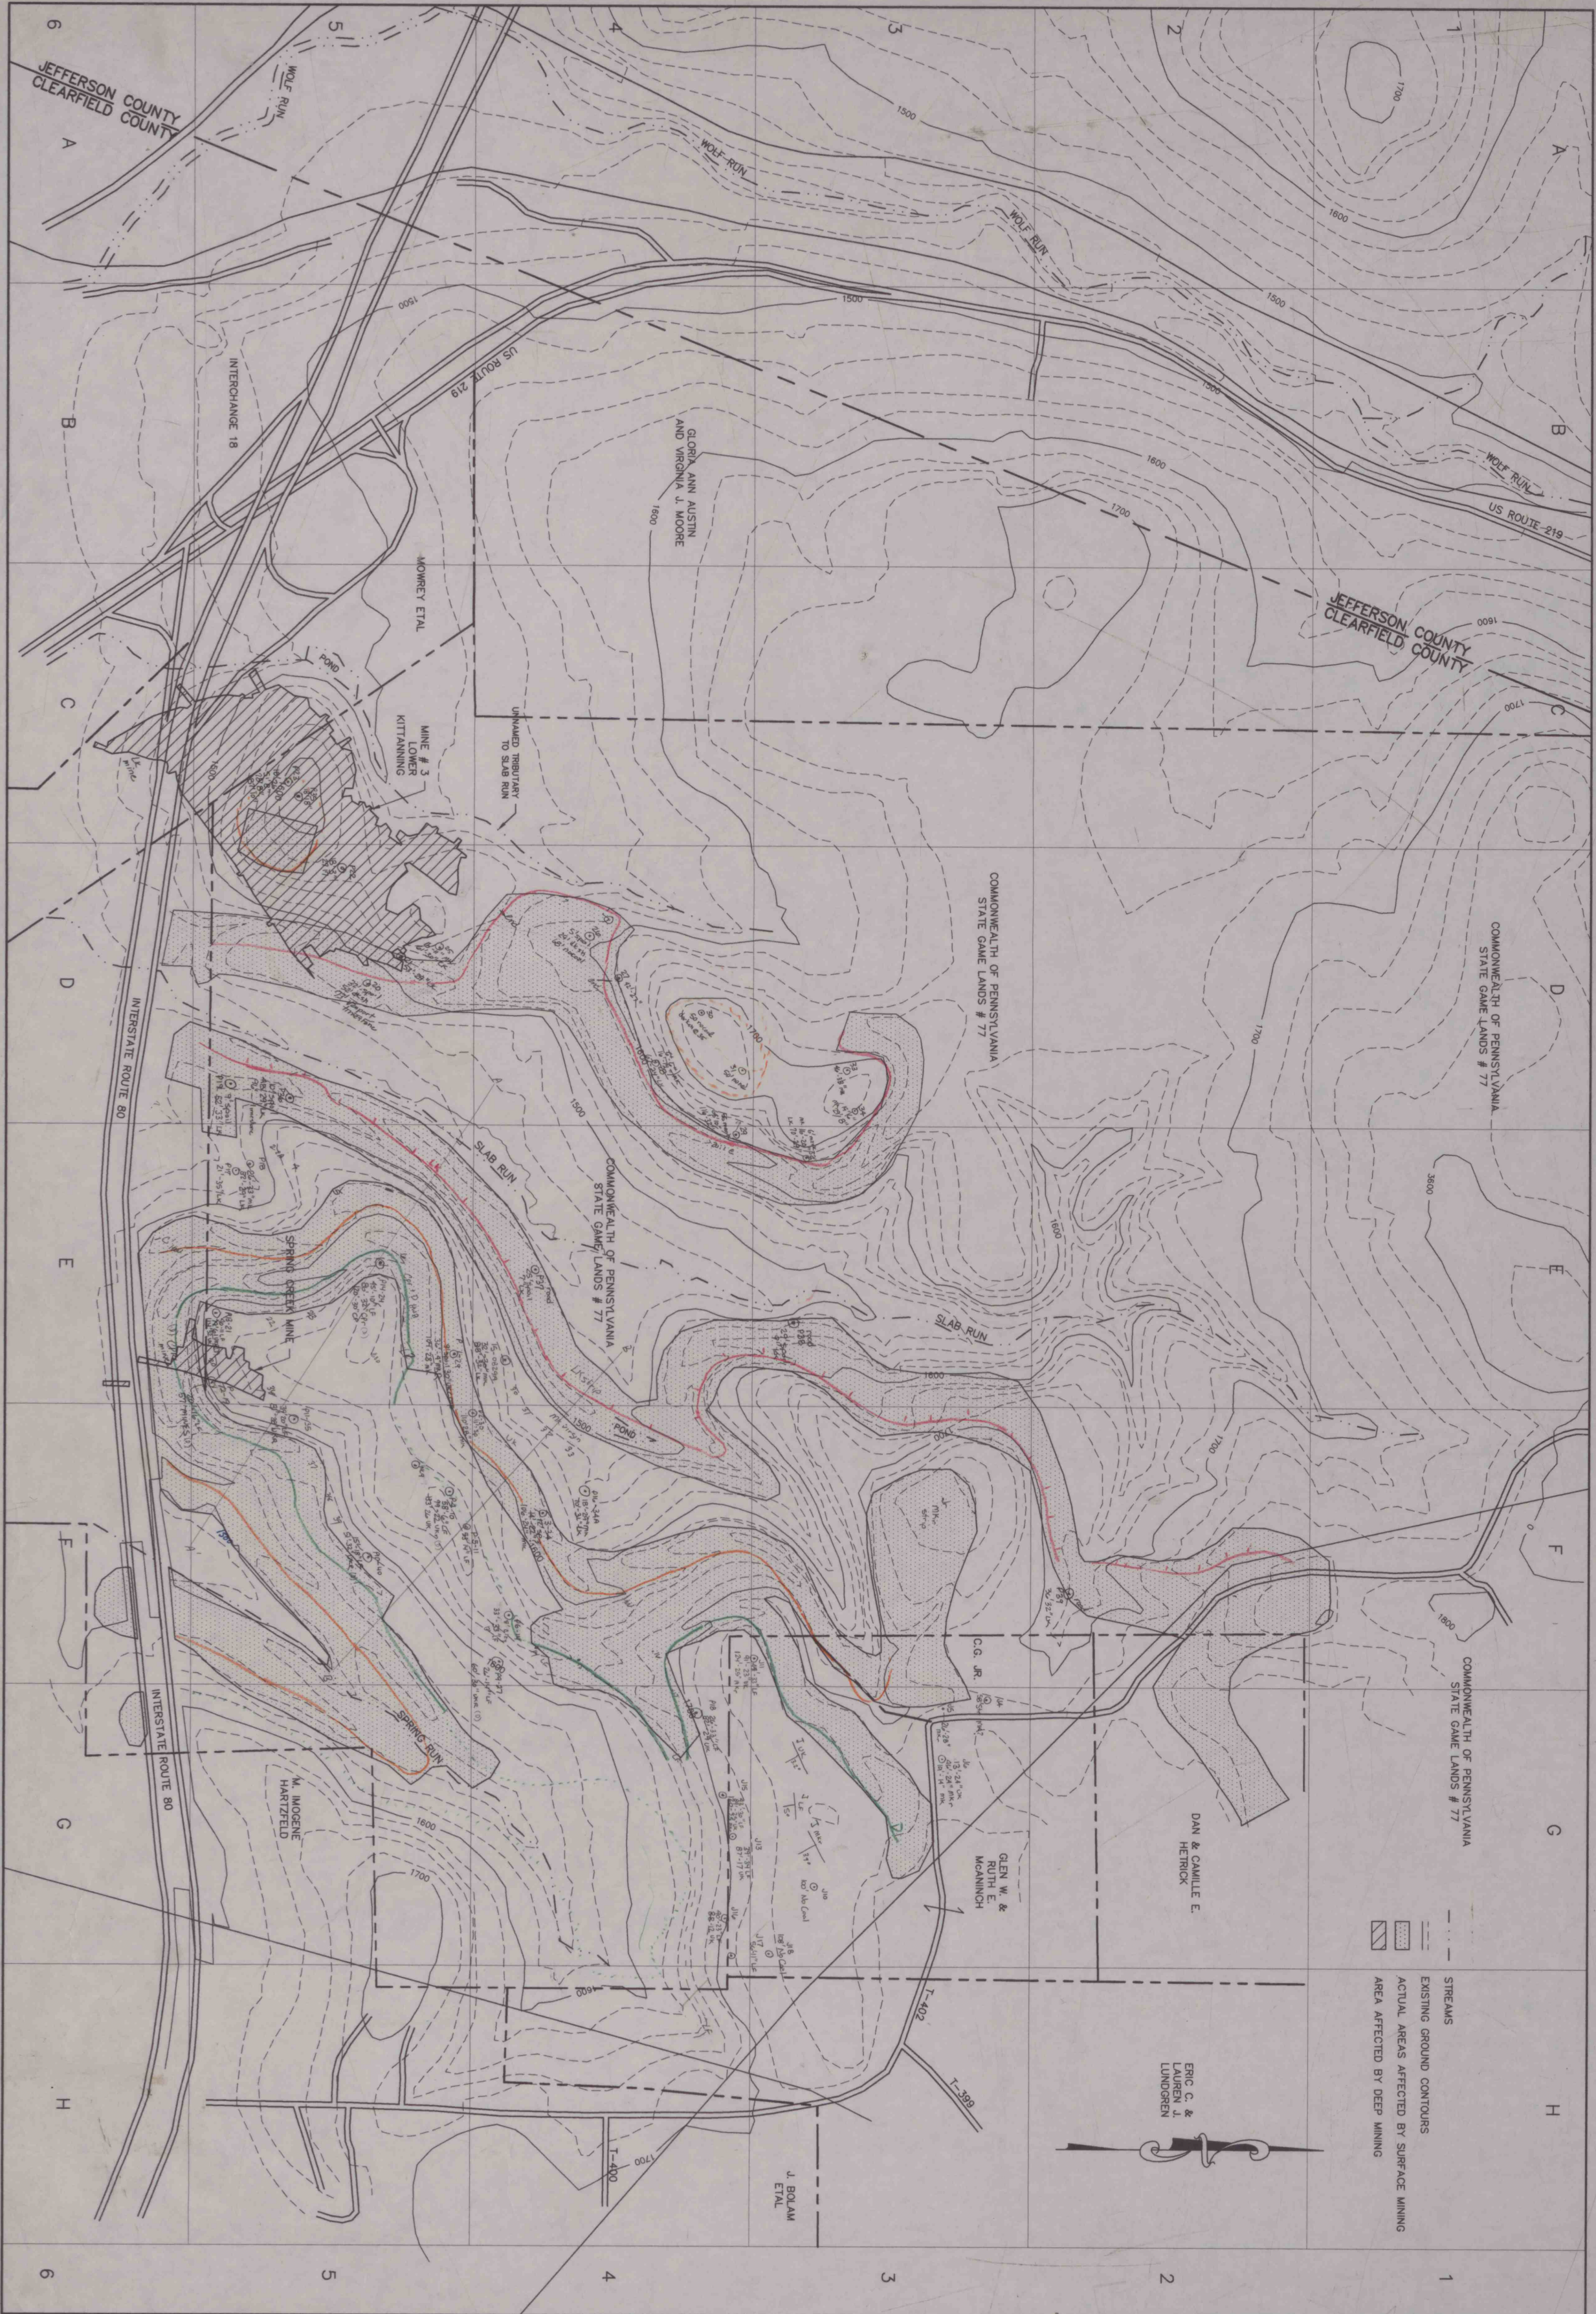

MAP SHOWING STATE GAME LANDS # 77 FOR P & N COAL COMPANY		APPROVED: _____ DATE: _____		APPROVED: _____ DATE: _____		APPROVED: _____ DATE: _____		APPROVED: _____ DATE: _____	
MINE PERMIT NUMBER		REG. NO.		ENGINEER		DATE		SEAL	
EXHIBIT 6.2 EXHIBIT 9 EXHIBIT 18 BOND INCREMENT BOND RELEASE		SANDY TOWNSHIP		CLEARFIELD COUNTY		LEE - SIMPSON ASSOCIATES, INC. CONSULTING ENGINEERS 200 WEST WEBER AVE. DUBOIS, PA. 16001 (814)371-7700		REVISIONS 10-6-95 STRAW BALE BARRIER	
						DRAWN BY: M.R.D.		CHECKED BY: D.L.B.	
						DATE: 10-17-96		PLOT DATE: 10-17-96	
						SCALE: 1" = 400'		FILE NO. 29622401	